


GRUNNMYND 1: 50

AFSTADA
1: 2000

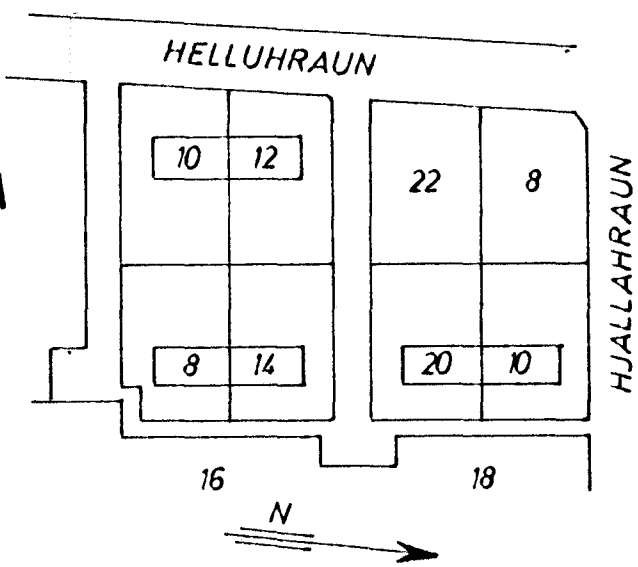

GERT SAMKVÆMT MÆLINGU A LÖGN.

HELLUHRAUN 20 HAFNARFIRÐI	MÆLIKVARDI 1: 50 1: 2000	VERK 7105	TEIKN NR 3B.
	Hannað Teiknað: <i>[Signature]</i>	Yfirtarið: Samb: <i>[Signature]</i>	DAGS DES '74.
JÓHANN GUNNAR BERGPÓRSSON VERKFR MVFI STRANDGÖTU 11 — HAFNARFIRÐI — SÍMI 53315		BREYTT	