

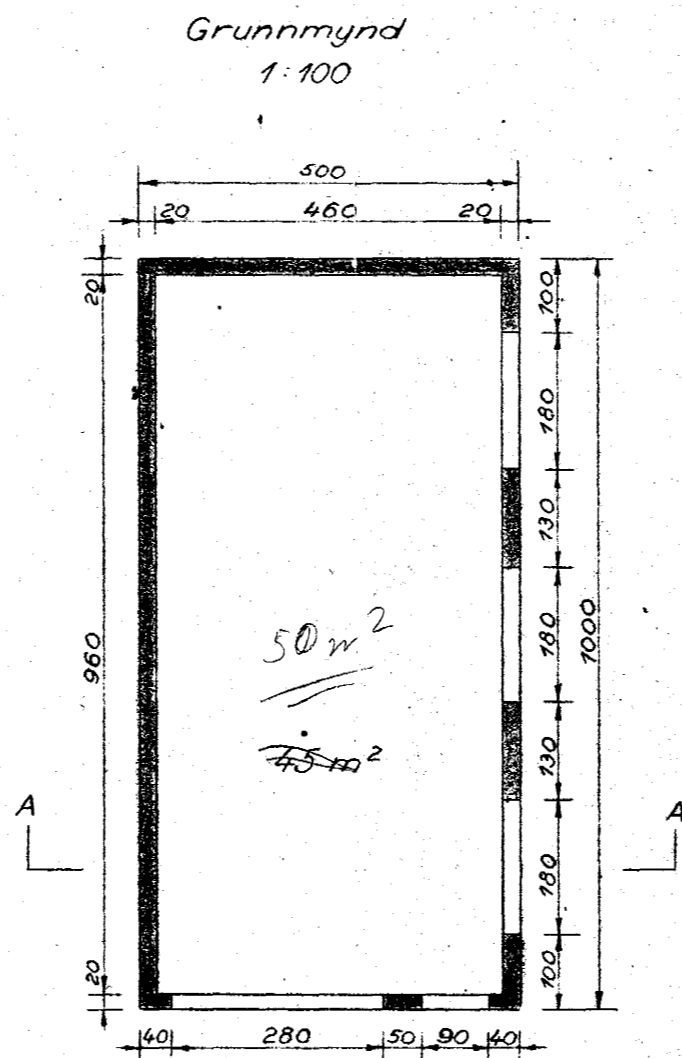
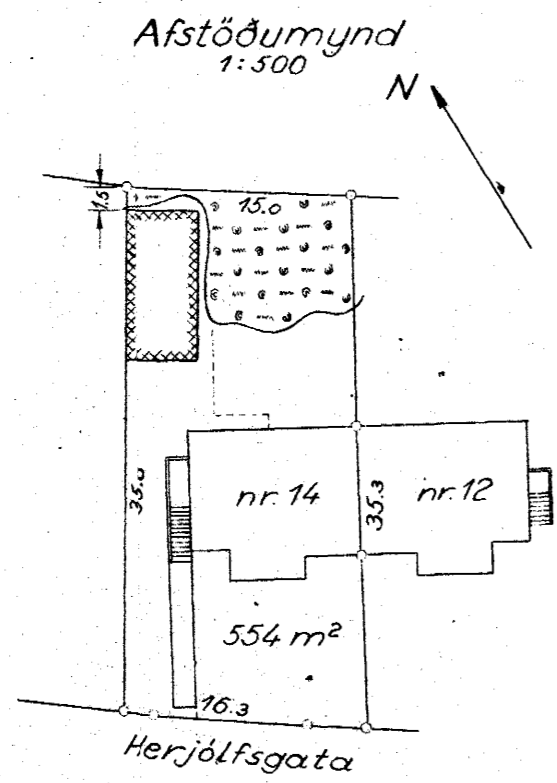


8/0 24/9 57

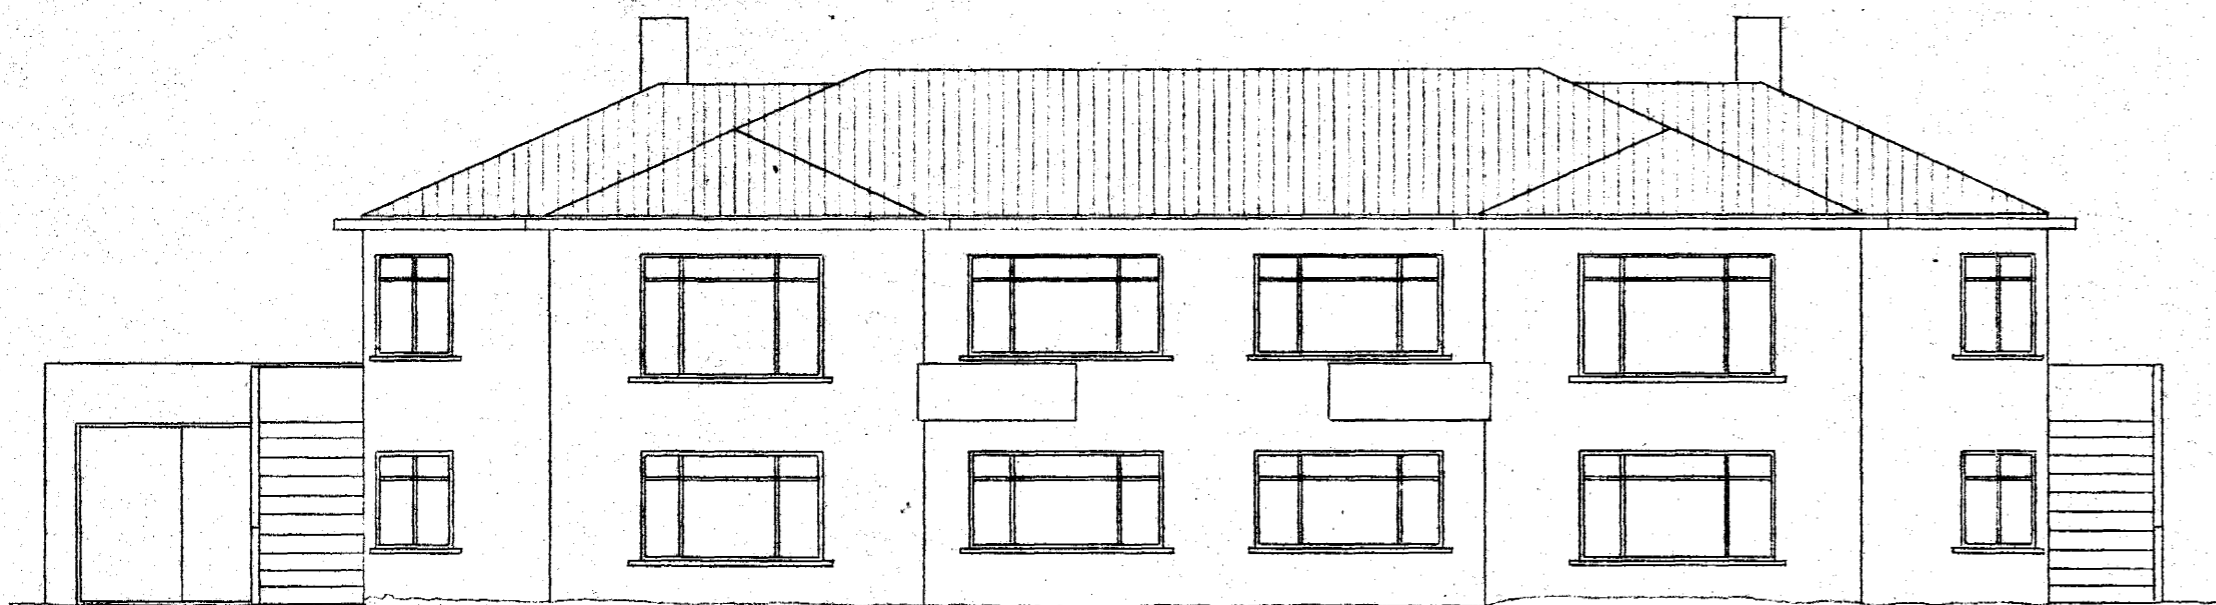


143. 107 K-r


Húsmann. Haldór Guðmundsson

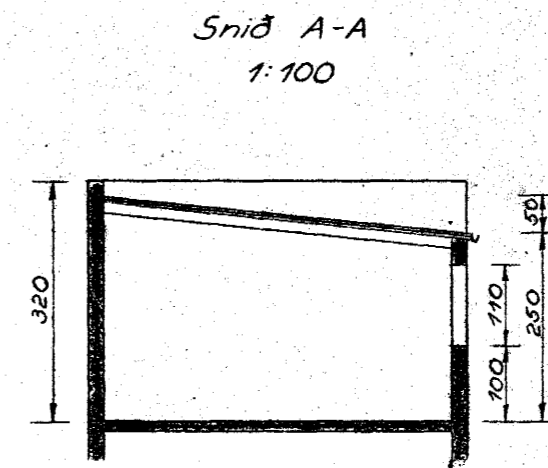

Súðvestur (séd frá götu)

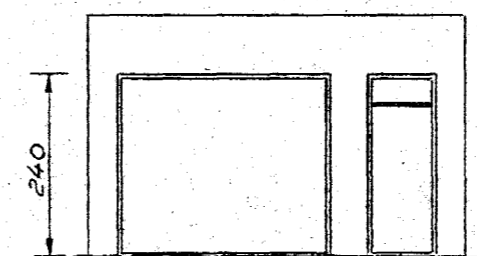

Súðvestur

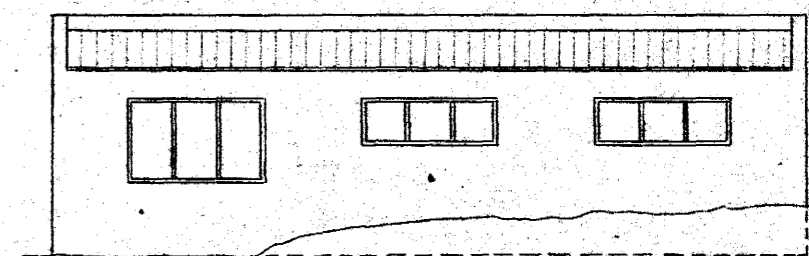

Súðaustur

Bilskúr Herjólfsgötu 14
 Þýð: Guðmundur Guðmundsson
 Reykjavík 13. sept. '57
 Gunnar Þóðleifsson