



Úr Gildi

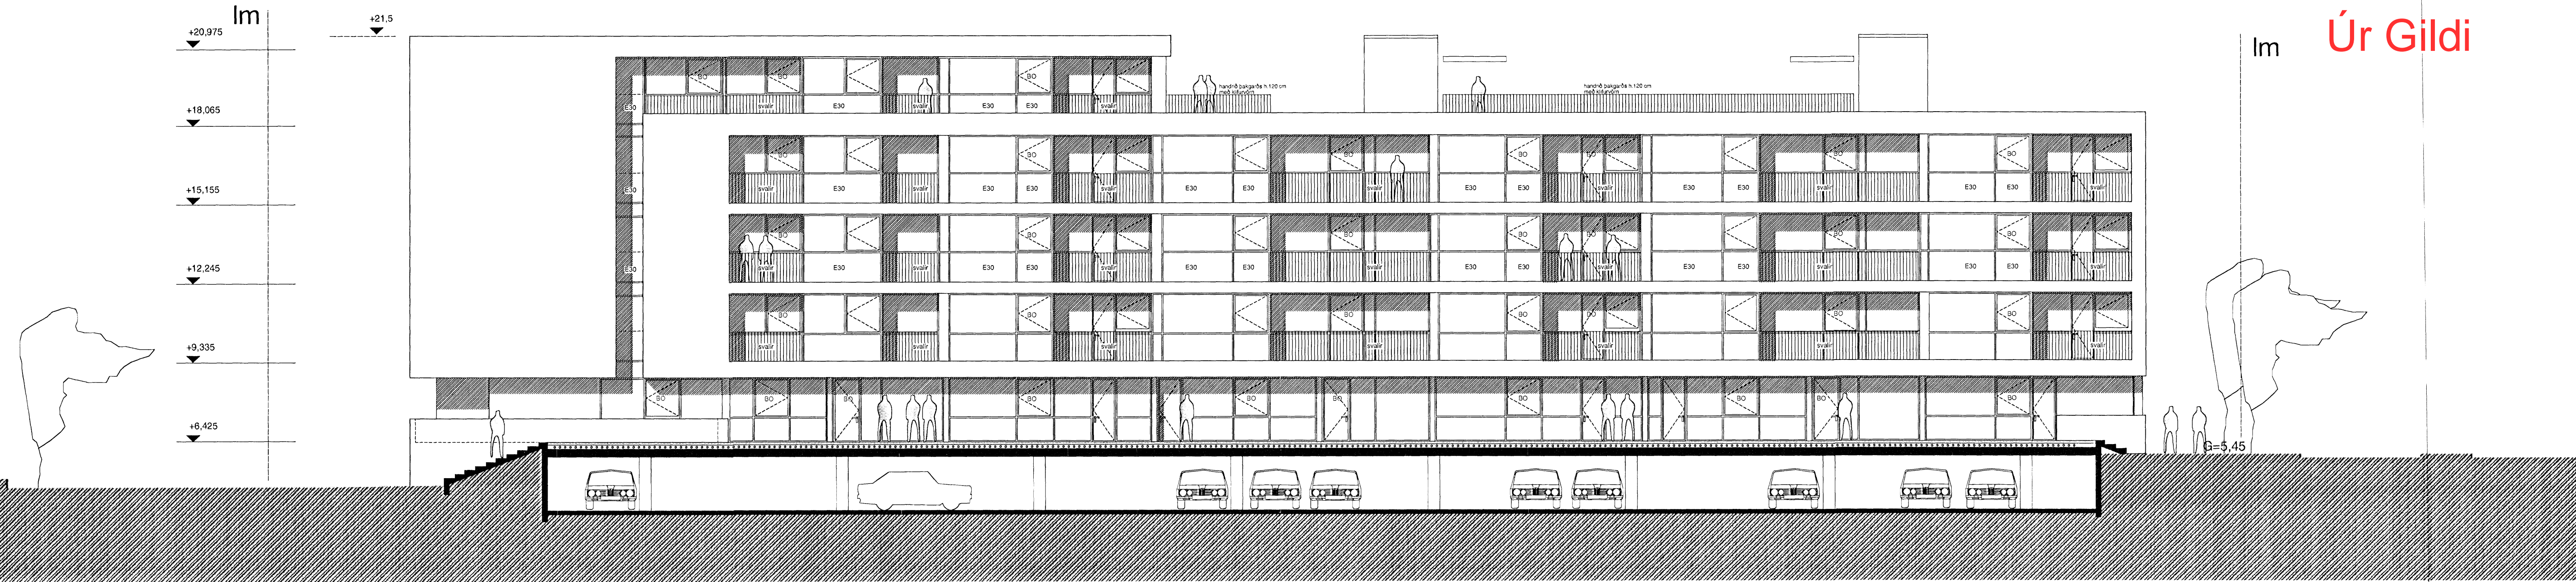

útlit Norðurbakki 9 - Austur

	K
	J
	I
	H
	G
	F
	E
	D
hæðarkortar	20.11.07 C
handhöf, brunnar, útlit, haug	19.05.06 B
opnarleg lög, skólavaggar, jarðin, garð	20.03.06 A
BREYTING:	0468

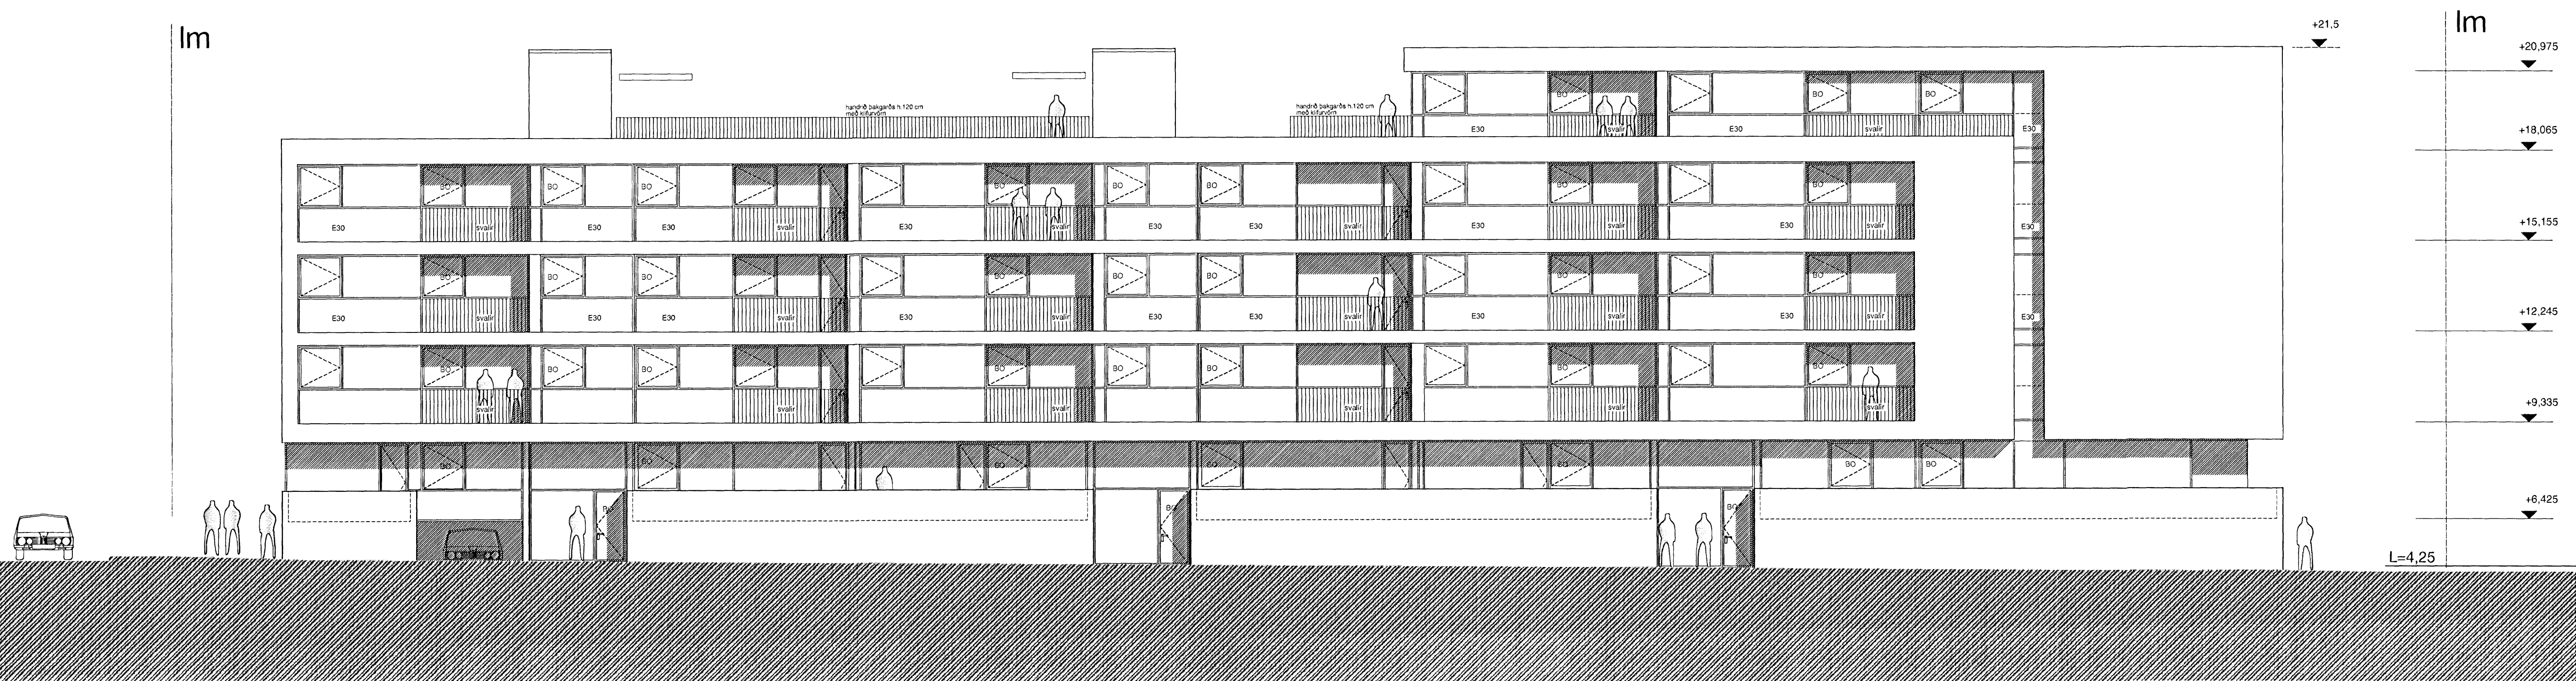

útlit Norðurbakki 9 - Vestur

norðurbakki 7-9

TEKNI. NR. NB 2.09 - C

TEKNI. NR. 06006  
 DAGS. 20.11.07  
 MÄV. 1 : 100

Plámar: Kristmundsson, Jóni 093455289

PK - ARKITEKTAR EHF.  
 LYNDELAUS 4 REIHKJAVÖR 110 XI 68004-2800 SÍMI 551 8050 FAX 551 8077  
 NETFANG p@pk.is

EYKT EHF.  
 NETFANG eykt@eykt.is