


7112
BL. 4

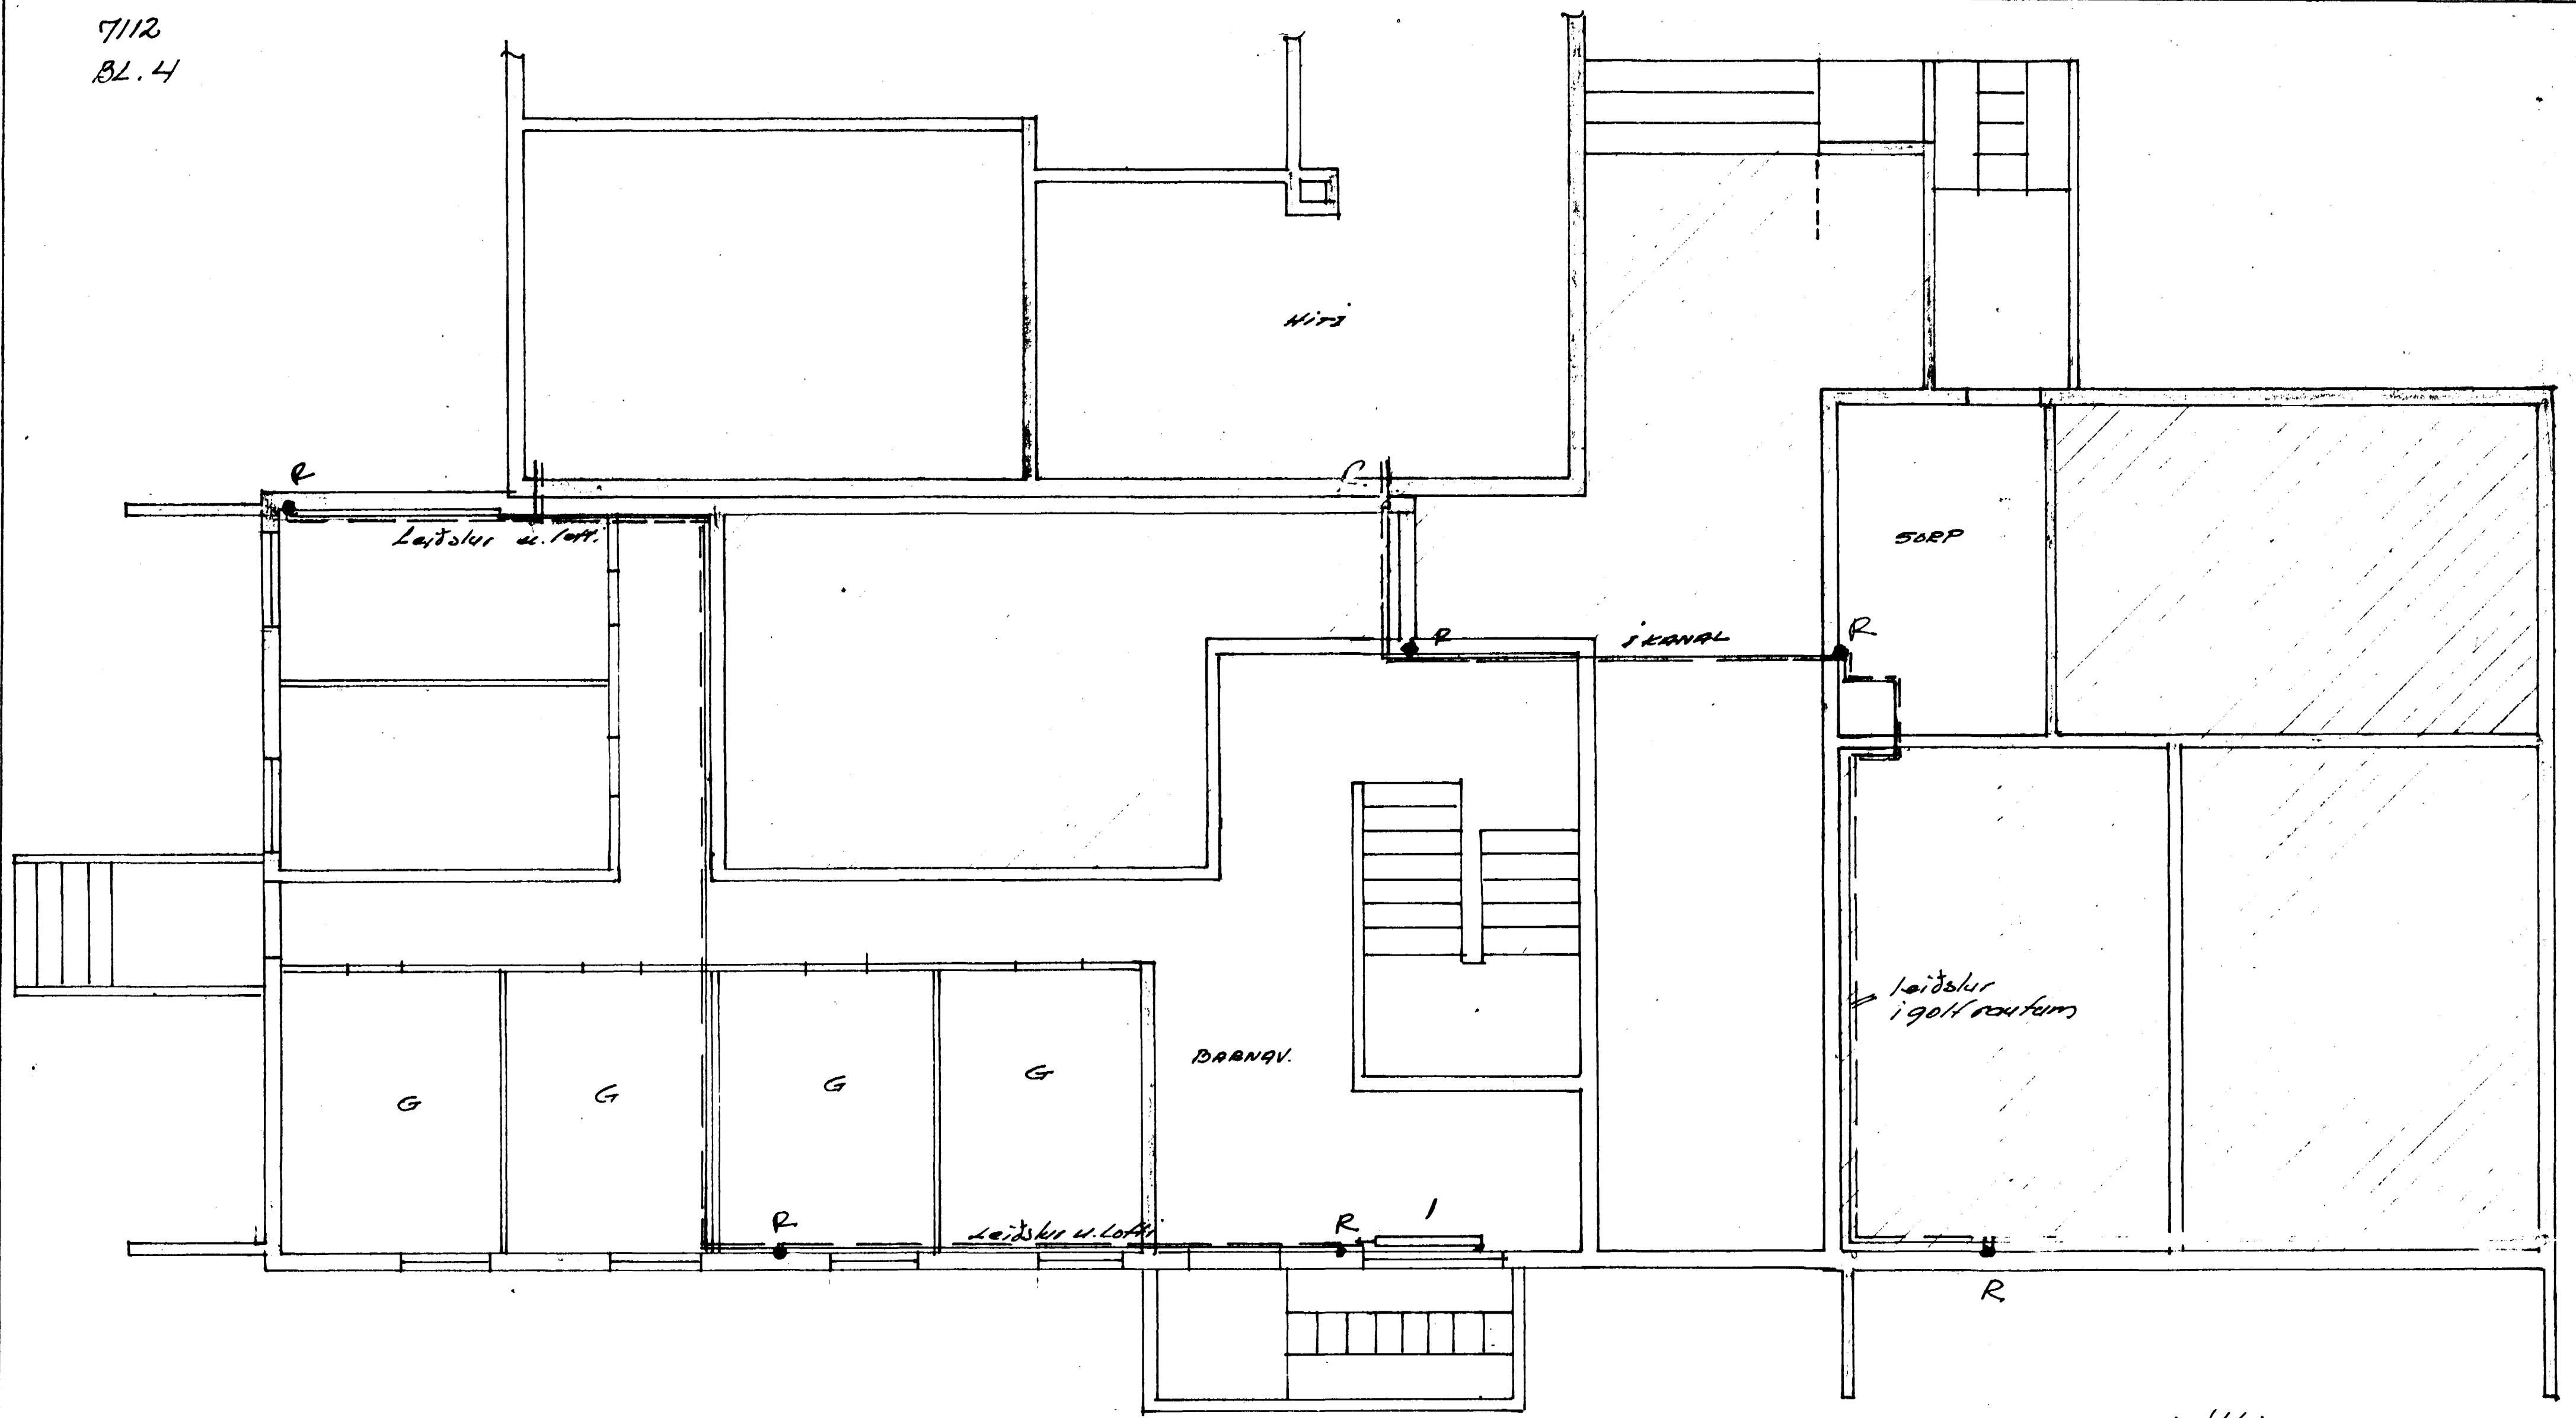

R. Líðrættiar BOKAR
09 gót.
Breyt. 18/6. 76. Kall.

HTALLA BROT I F HITALAGNIR	1:50	TEIKN.	Kall
		DAÐI.	14.7.71
KOLBEINN & G. JONSSON. TEIKN. DE.		TEIKN. NR	
		7112	
		BL. 3	