


Breytt STA BL. 3 B

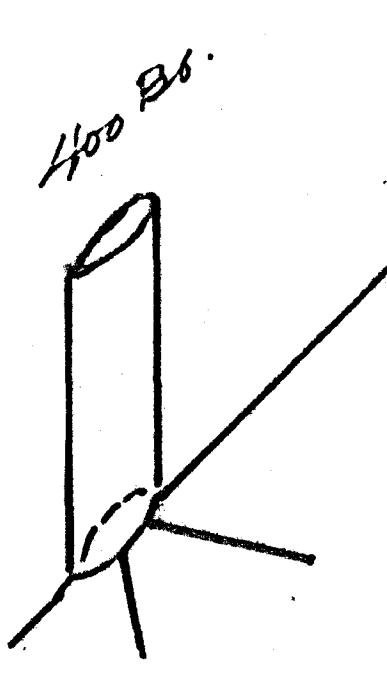

HJALLABRAUT 123 VARN & SKOLF	0481	1962 64
	7001	2001
Stalheim EY fætur Salvati	6920 BL 3	Emil P. Langs. H.