



Samþykkt þann

13 OKT. 1997

Byggingafultrúinn í Hámarfirði
Erlendur Hjálmarsson

STIMPILREITUR

TEIKNISTOFAN



SIGRÍÐUR MAGNÚSDÓTTIR ARK.FAÍ.
HANS-OLAV ANDERSEN FAÍ. MNAL.
©
BURUDVN. 1, N 1350 LOMMEDELEN
NORGE. SÍMI OG FAX: +47 6756 3549

Sigríður Magnúsdóttir

FLATARMÁLSÚTREIKNINGUR:


Heildarflatarmál:	82.9 m ²
2. hæð:	0.0 m ²
Samtals:	82.9 m ²
Golfflatarmál:	73.4 m ²
2. hæð:	0.0 m ²
Samtals:	73.4 m ²

Flatarmál veggir:	9.5 m ²
Netto / Brutto:	0.89

BREYTINGAR:

A. 17.7.1997:
BR. GÖLFKÓTI
MINNI PANILBORD Í KLÆDNINGU
BR. ÚTFÆRSLA SÜLU
GLUGGI Í HURÐ VIÐ LÍNU 4
RENNUNIDURFALL FLUTT Í HERB. 400
BR. VEGGJARÞYKKTIR OG TILFÆRSLA
Á MILLIVEGGJUM
BR. ÚTFÆRSLA "BÍLSKÚRSHURÐAR"
MEIRI LOFTHÆÐ Í HERB. 404
HLAUPAKÖTTUR FESTUR Í LOFT

**NÝTT HRAUNBYRGI
Á VIÐISTAÐATÚNI**
HJALLABRAUT 51

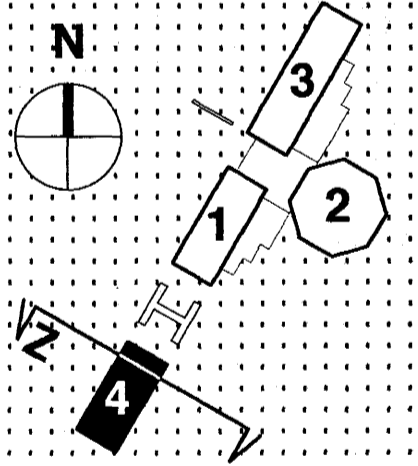

ÁDALTEIKNINGAR

ÁHALDAHÚS

HÚSHLUTI:	4
MÆLIKVARÐI:	1:100
DAGSETNING:	10.6.1996
TEIKNINGANÚMÉR:	107A
SÍÐAST LAGFÆRT:	17.7.1997

