
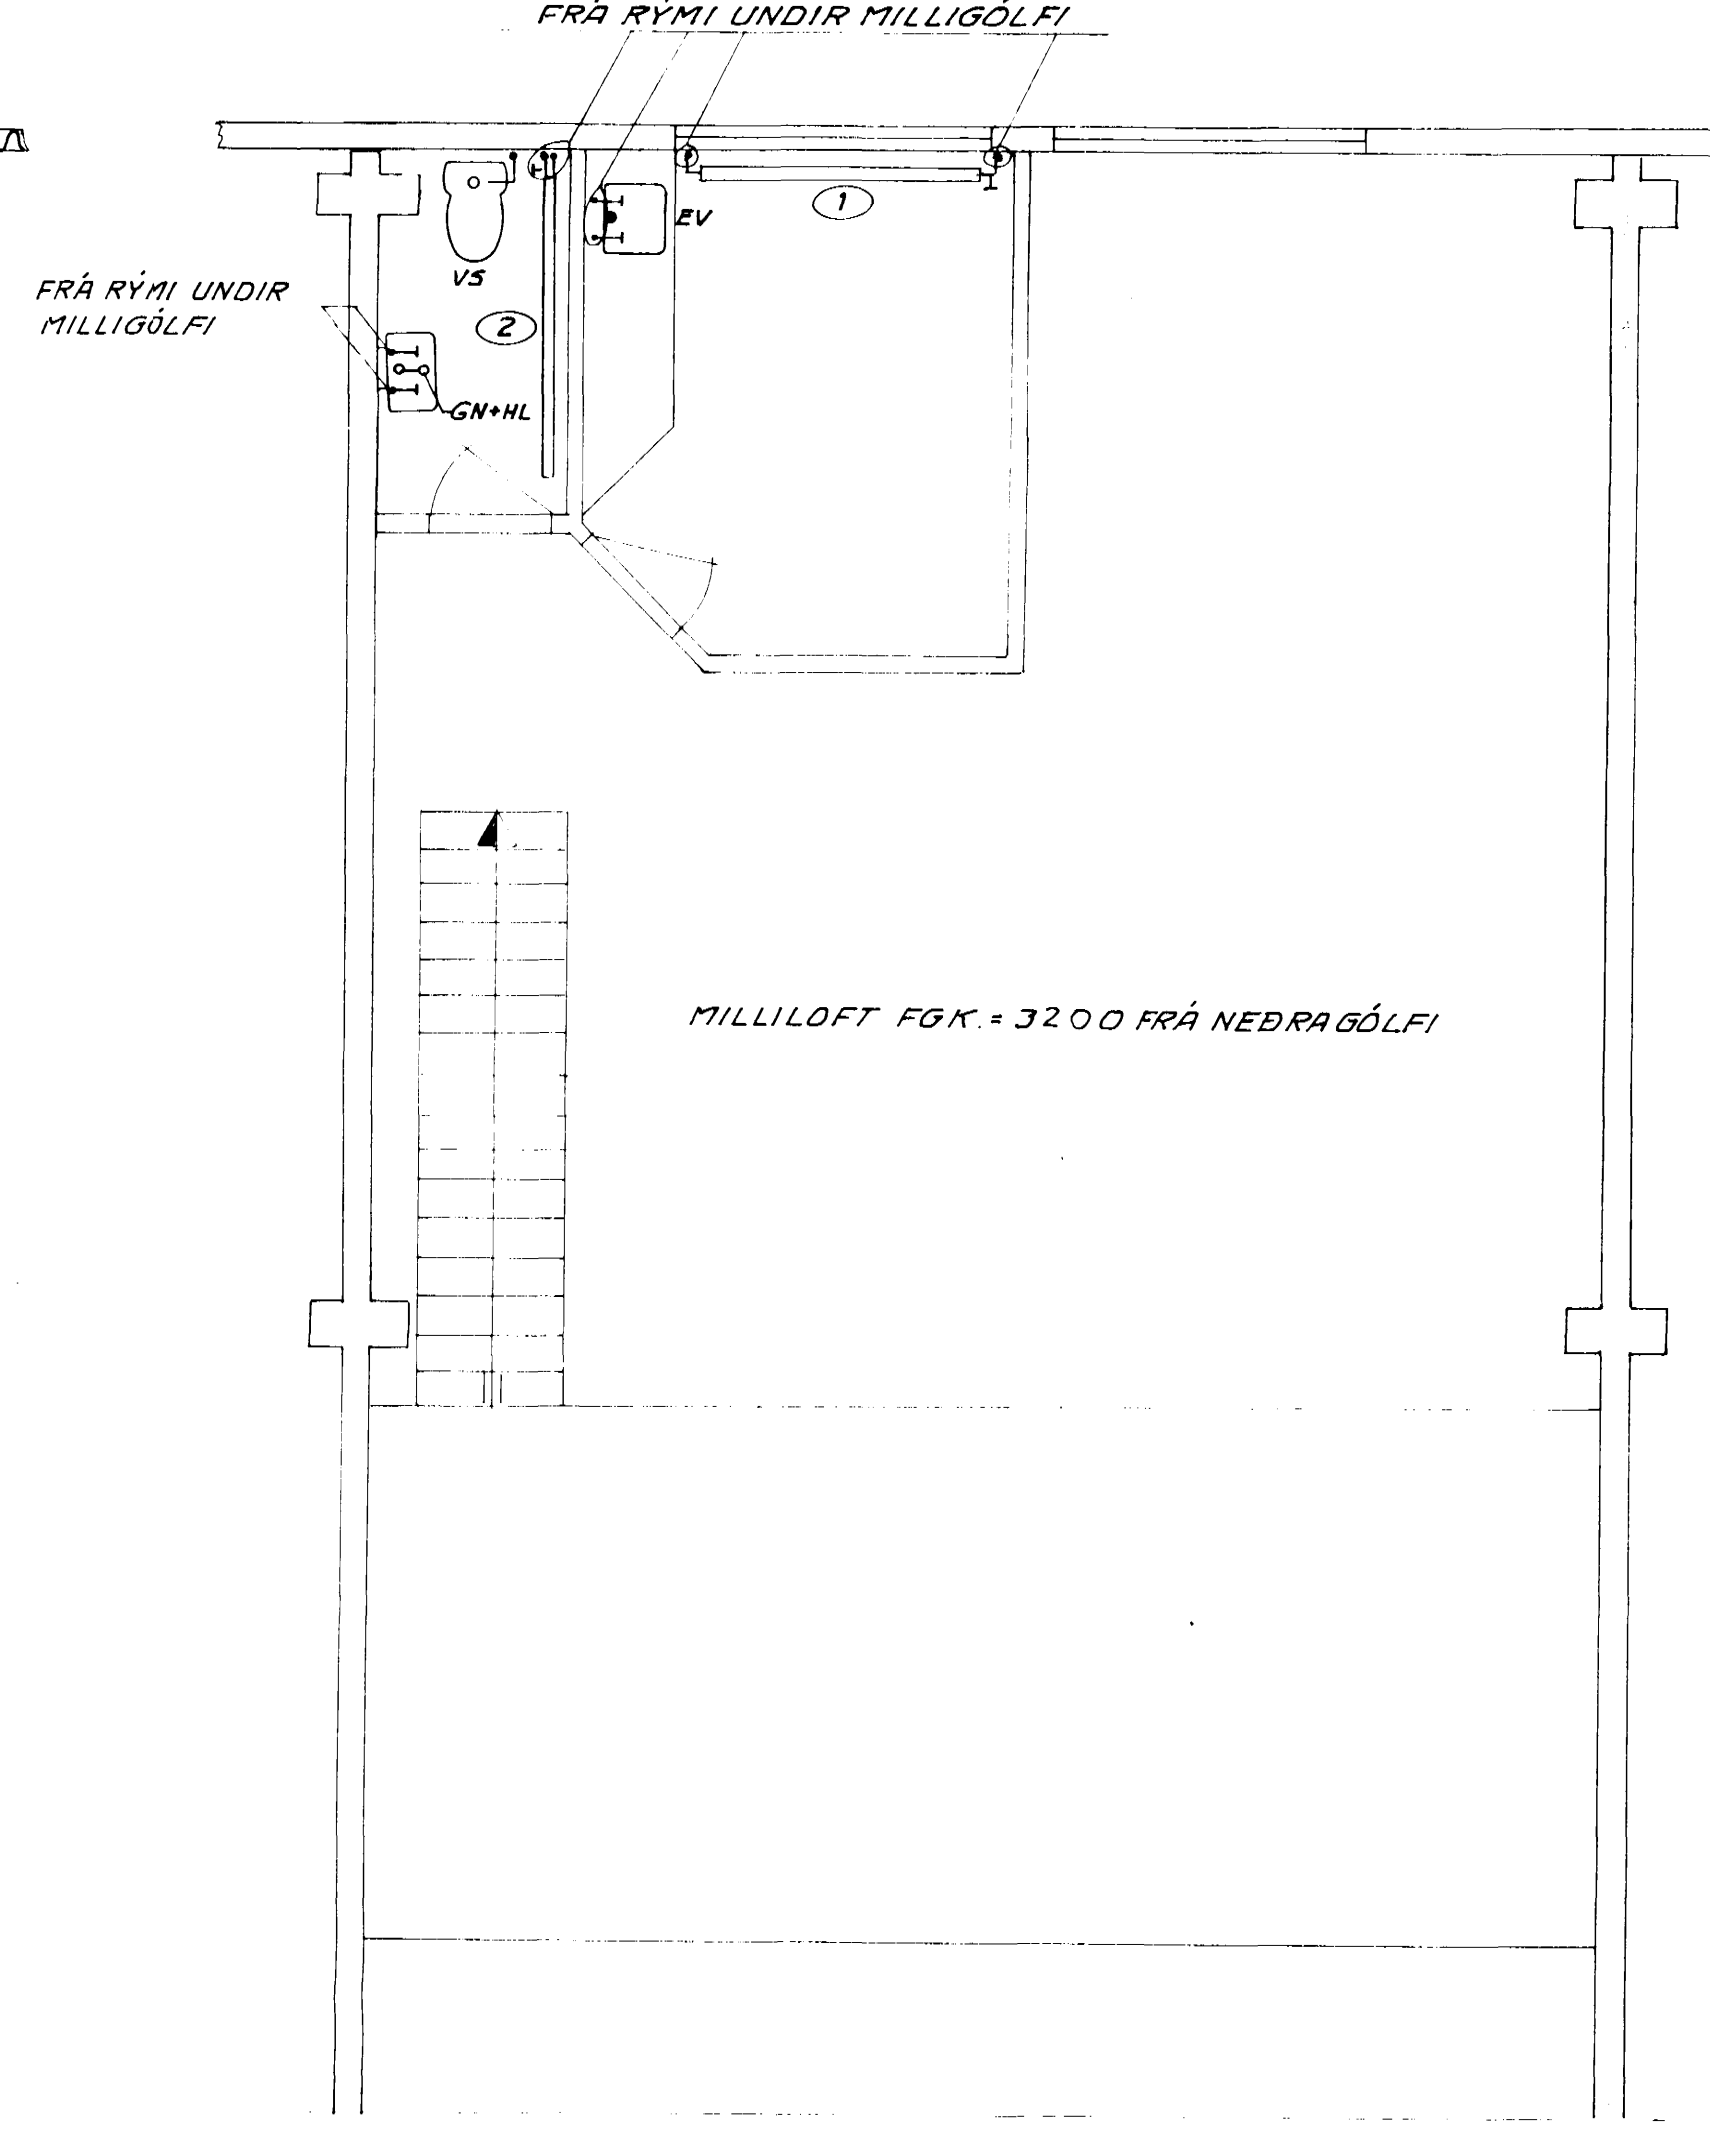


GRUNNMYND M 1:50


GRUNNMYND AF MILLILOFTI M 1:50

RÚMMYND VATNS OG HITLAGNA M 1:50


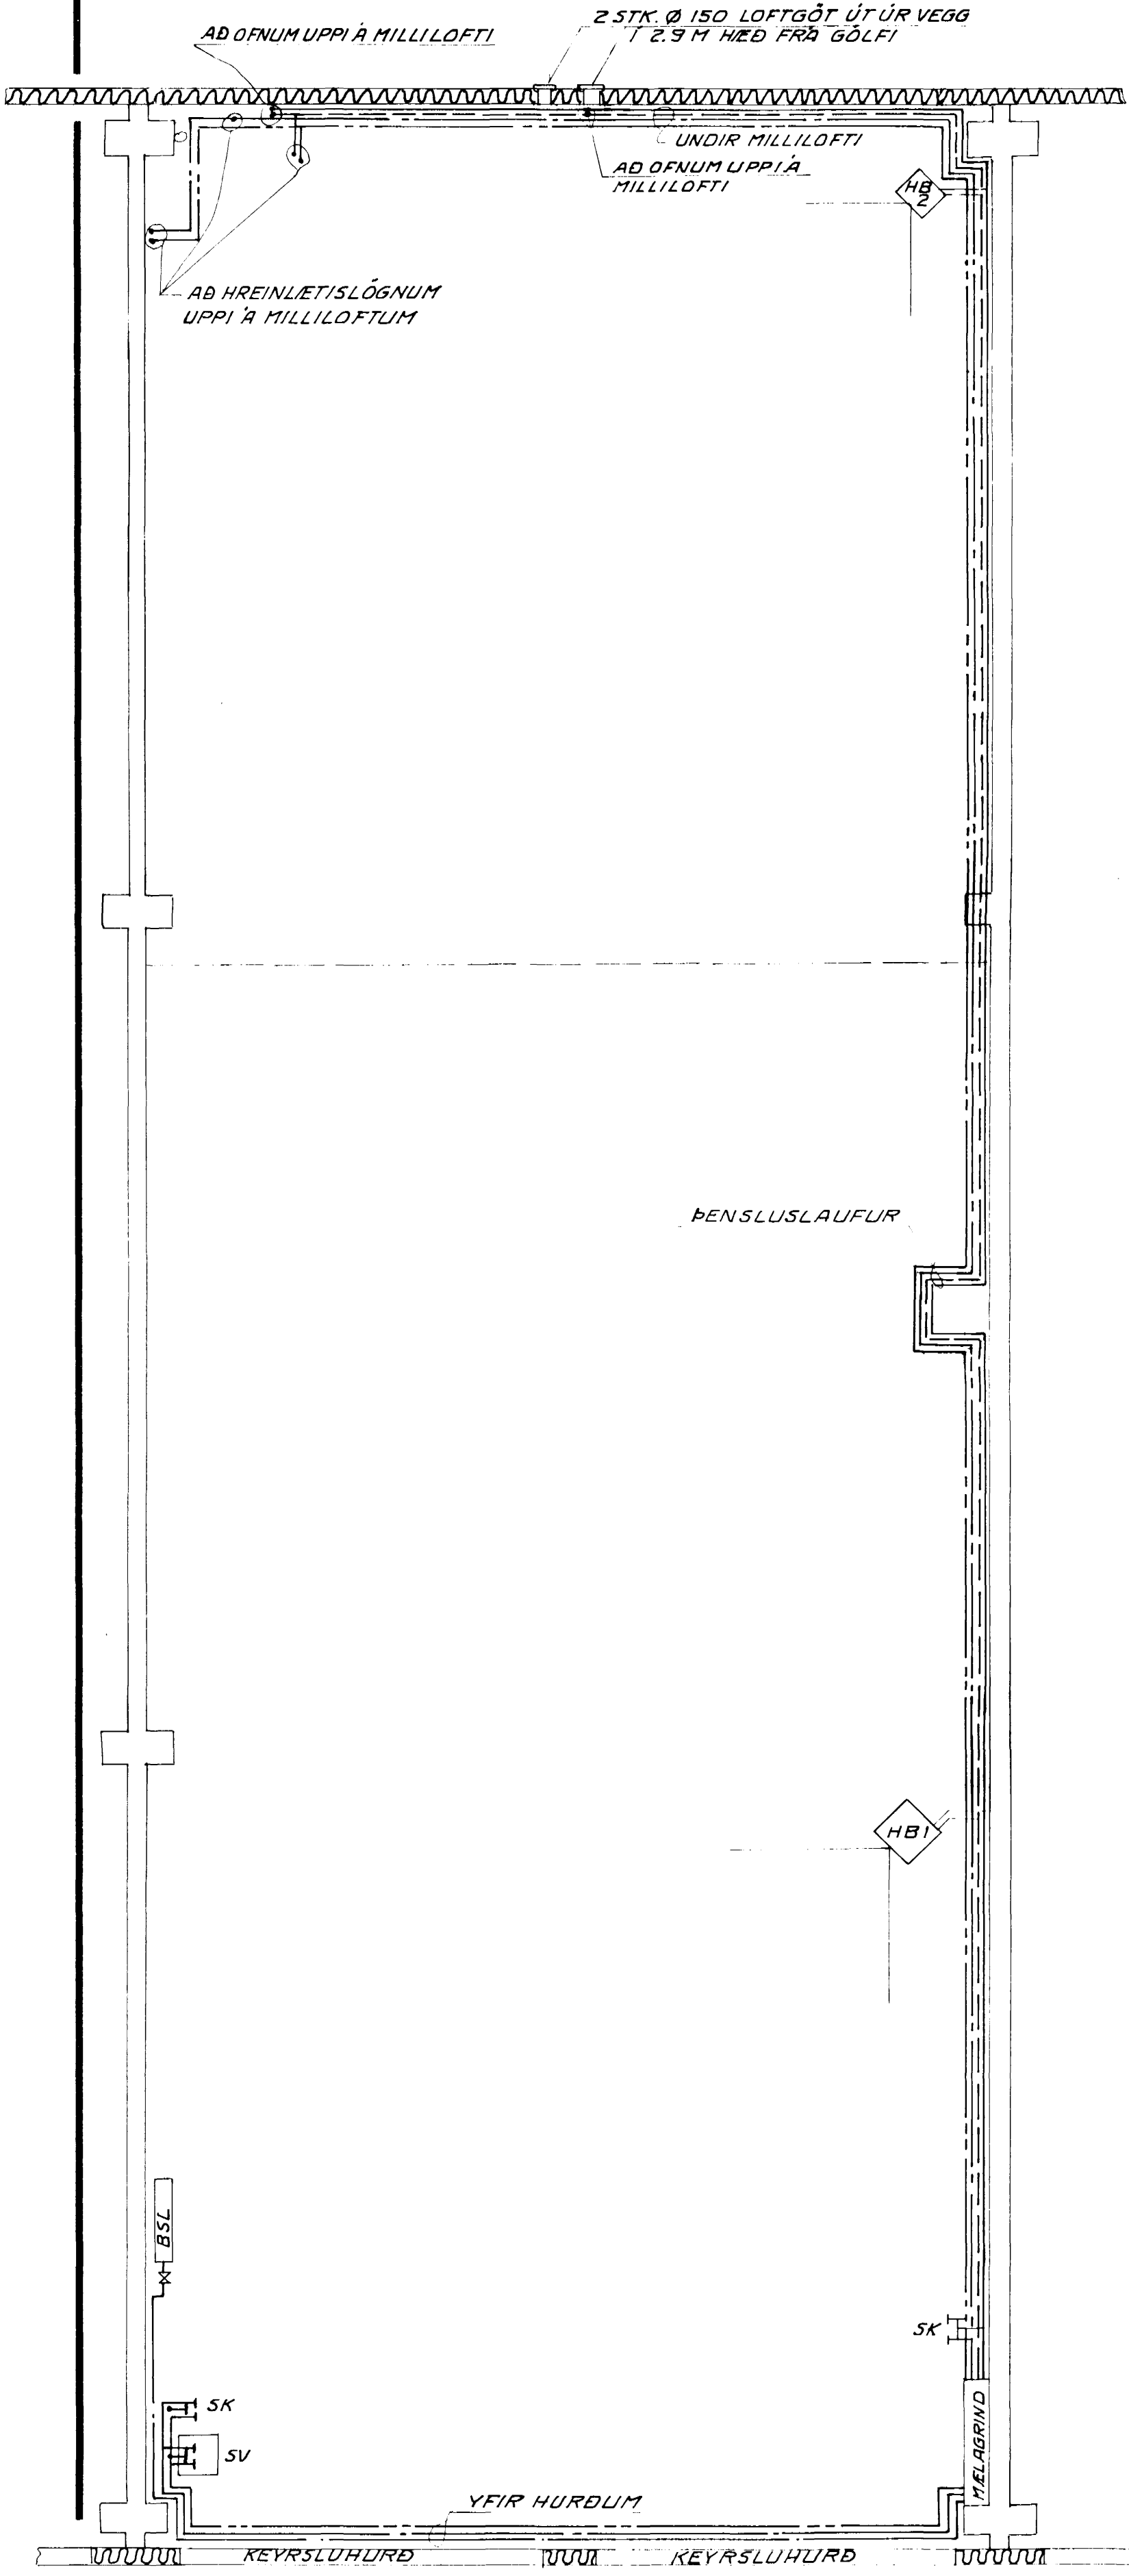


ΔT: 40°C SKRÁ YFIR OFNA OG HITABLÁSARA

NR.	STÆRÐIR		TENGING	AFKASTA		VALDIR OFNAR OG HITABLÁSARA	
	HJED (MM)	LENGD (MM)		HÖRF KCL/KLST.	HJED (MM)	LENGD (MM)	AFKÖST KCL/KLST.
OFN 1	300	2000	B - C	450			
OFN 2	300	2000	B - C	1300			
HB 1	BH 61/3			14.000		15.000	
HB 2	BH 49/3			6.000		7-10.000	
SAMTALS				21.750	SAMTALS		

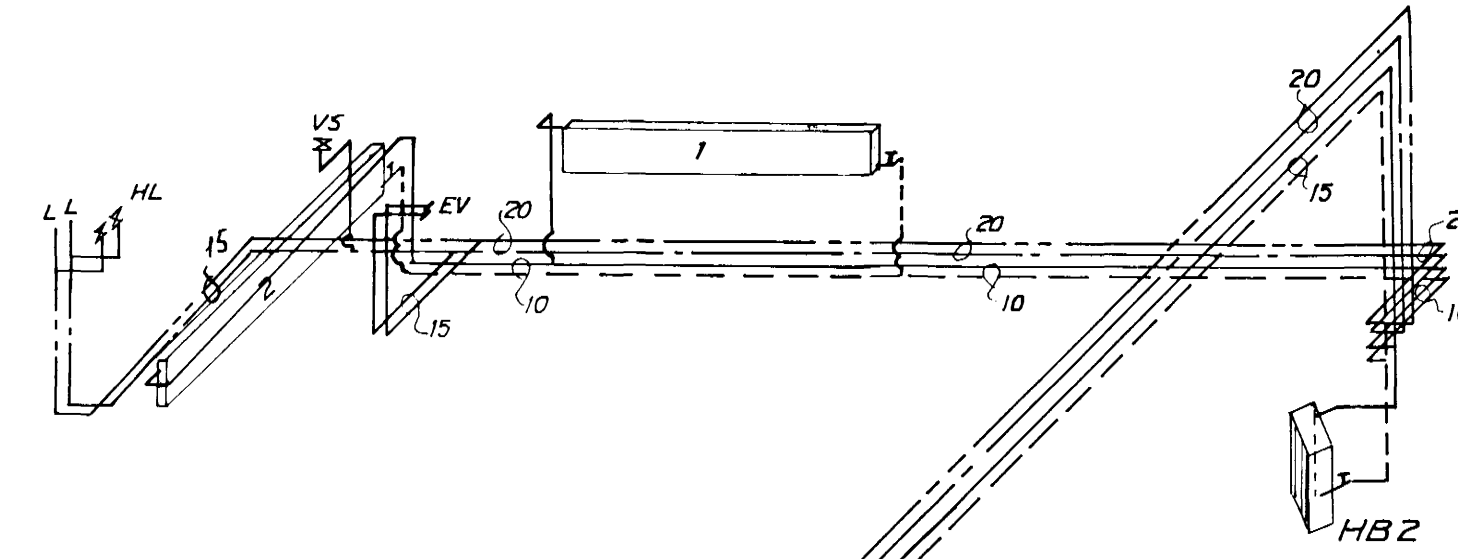


F1 M 1:50

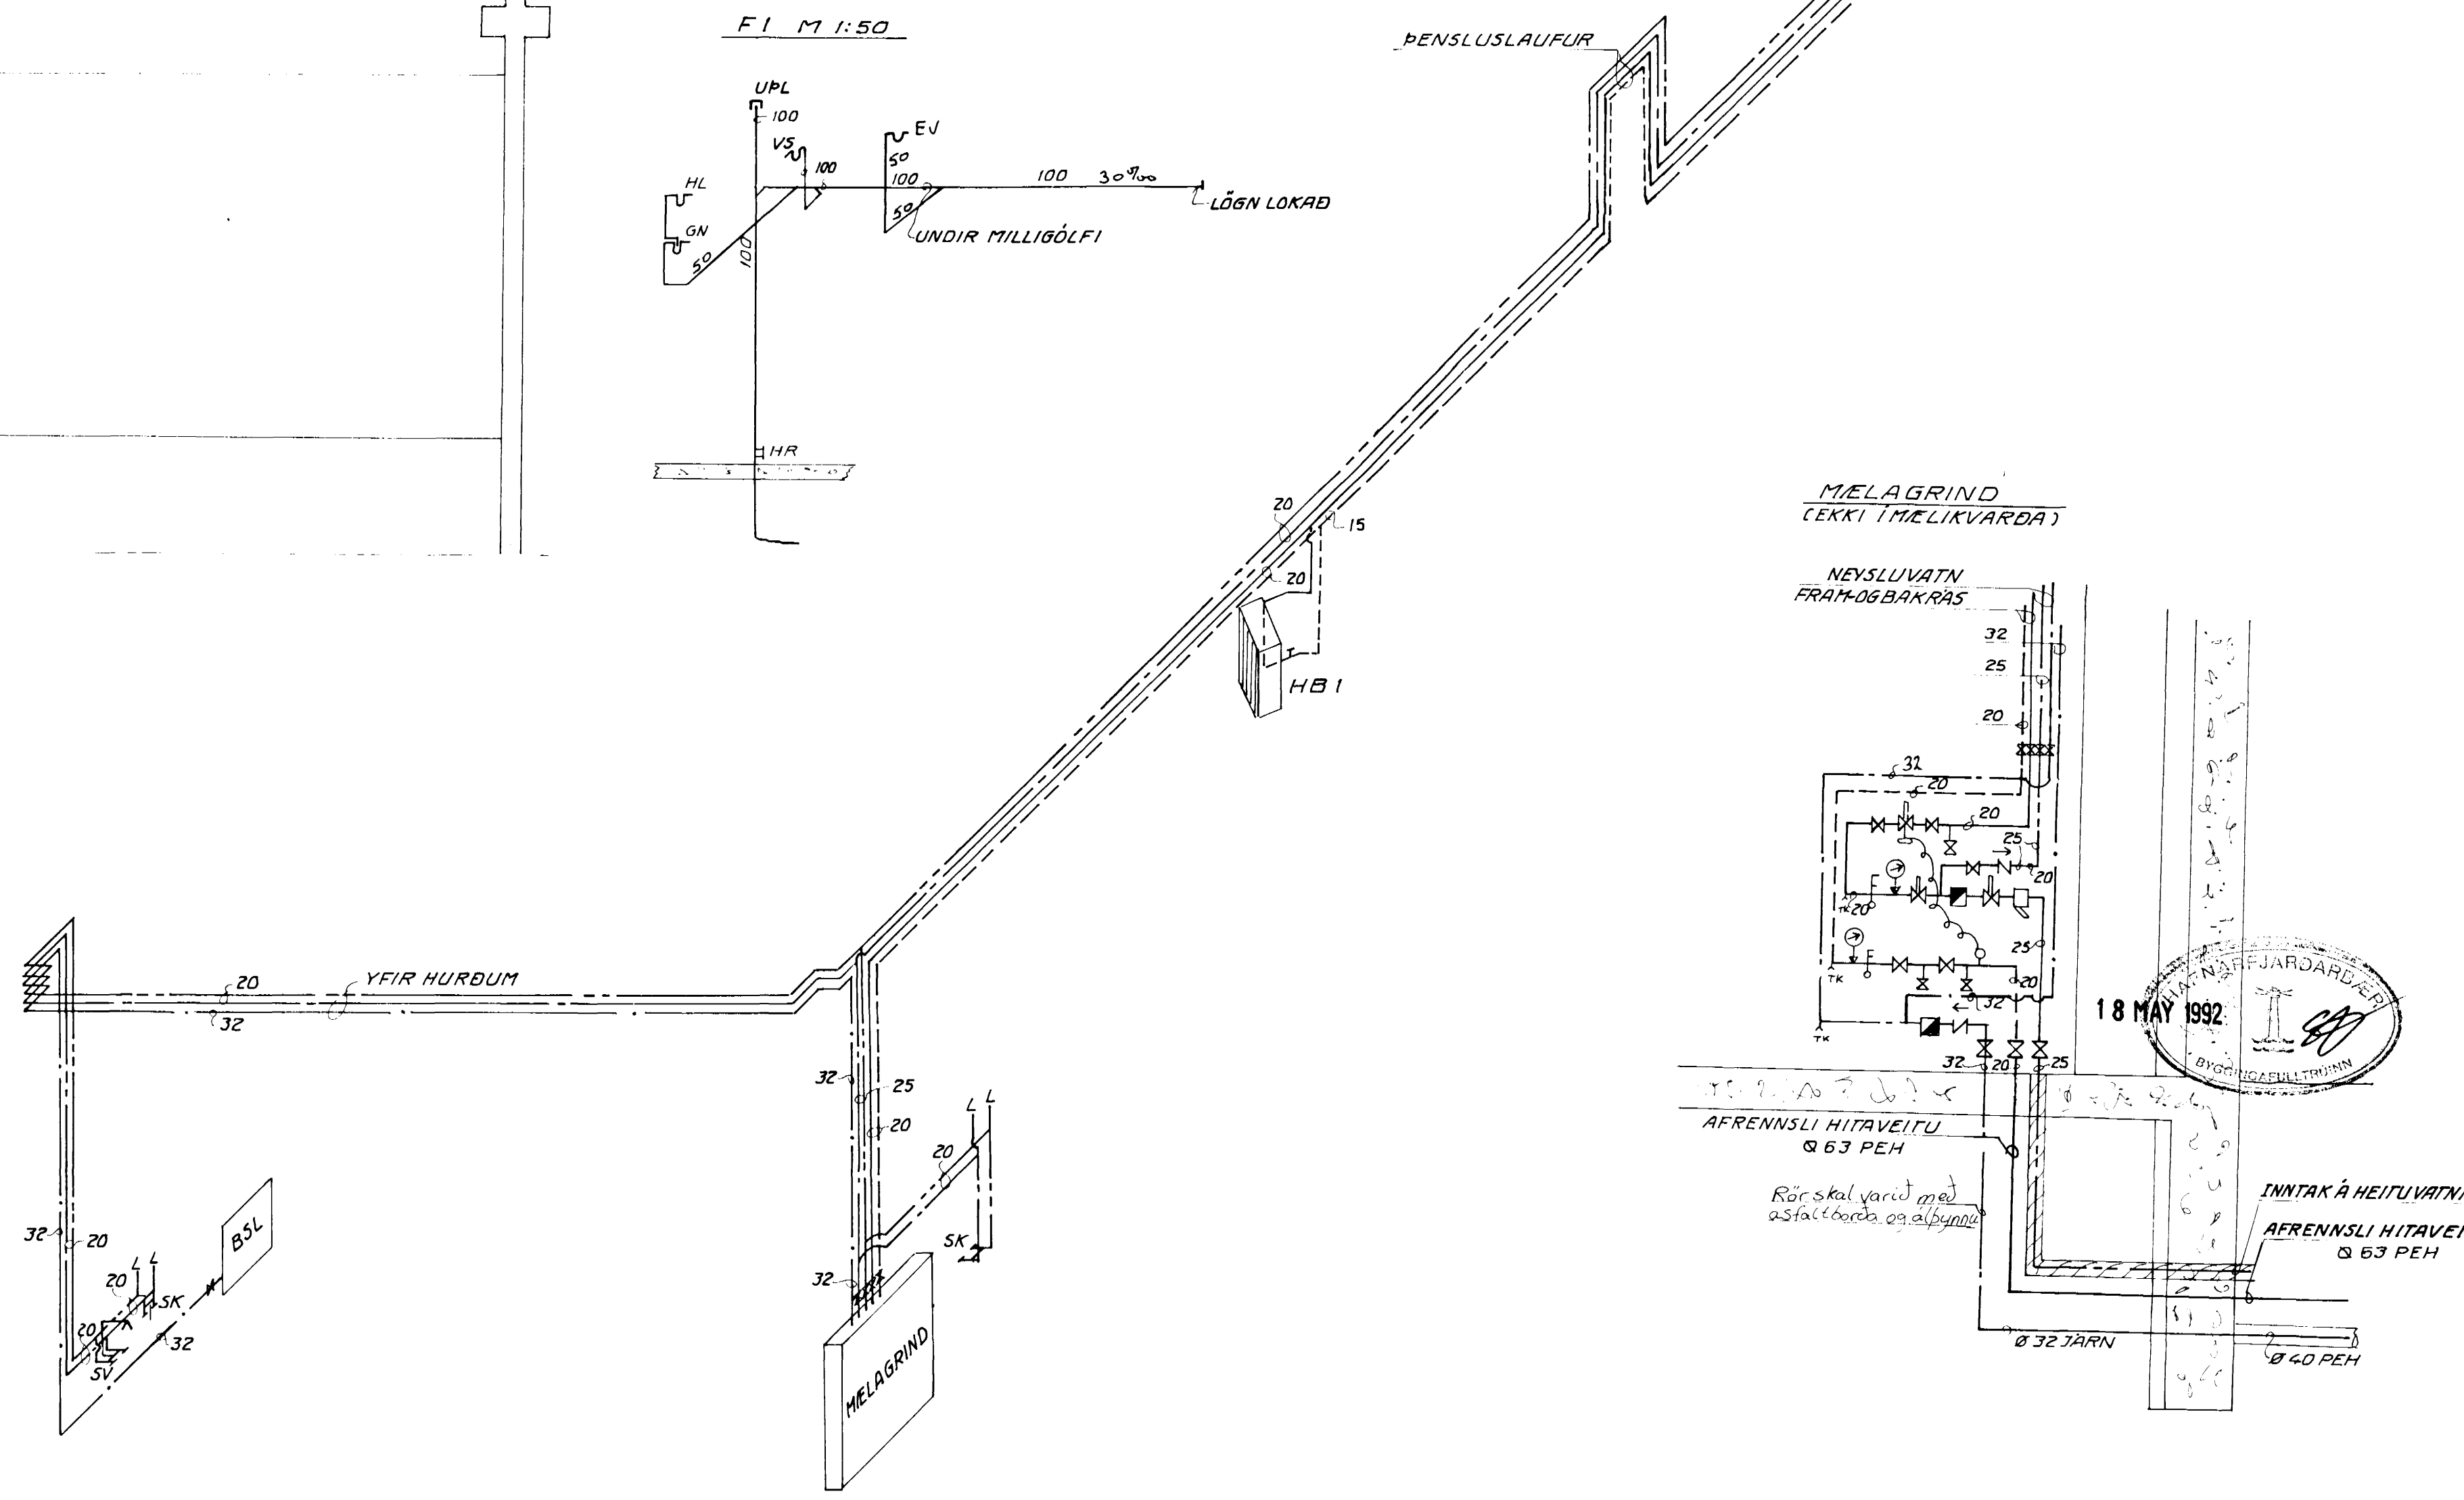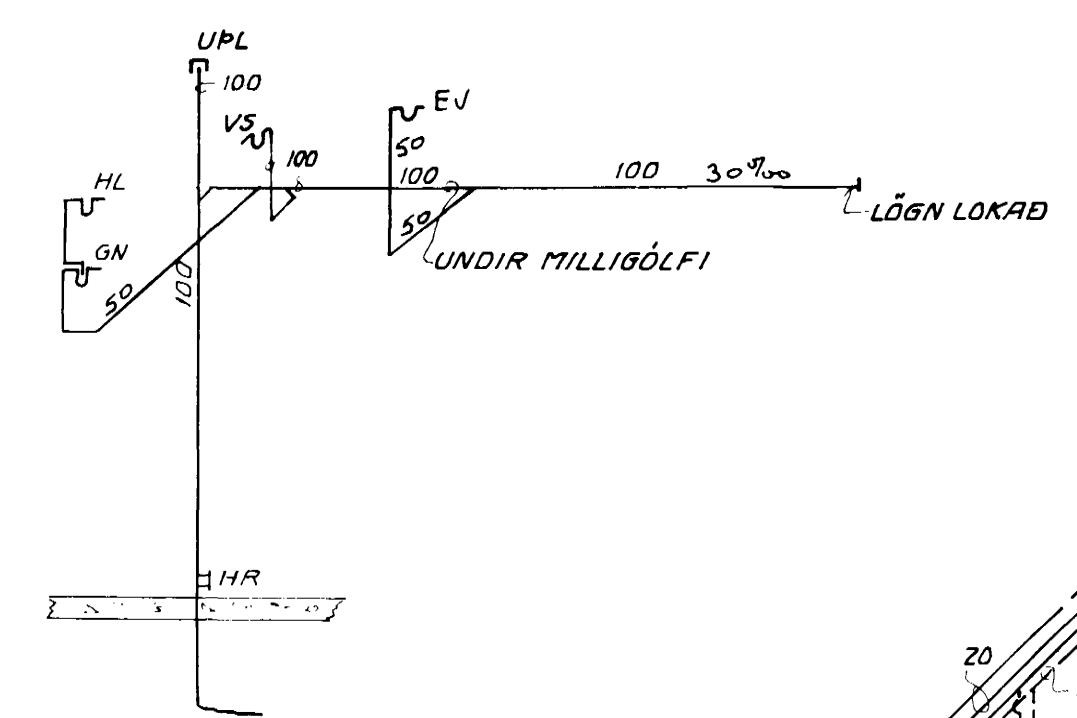

MELAGRIND (EKKI Í MELIKVARÐA)

NEYSLUVATN FRAM- OG BAKRÁS

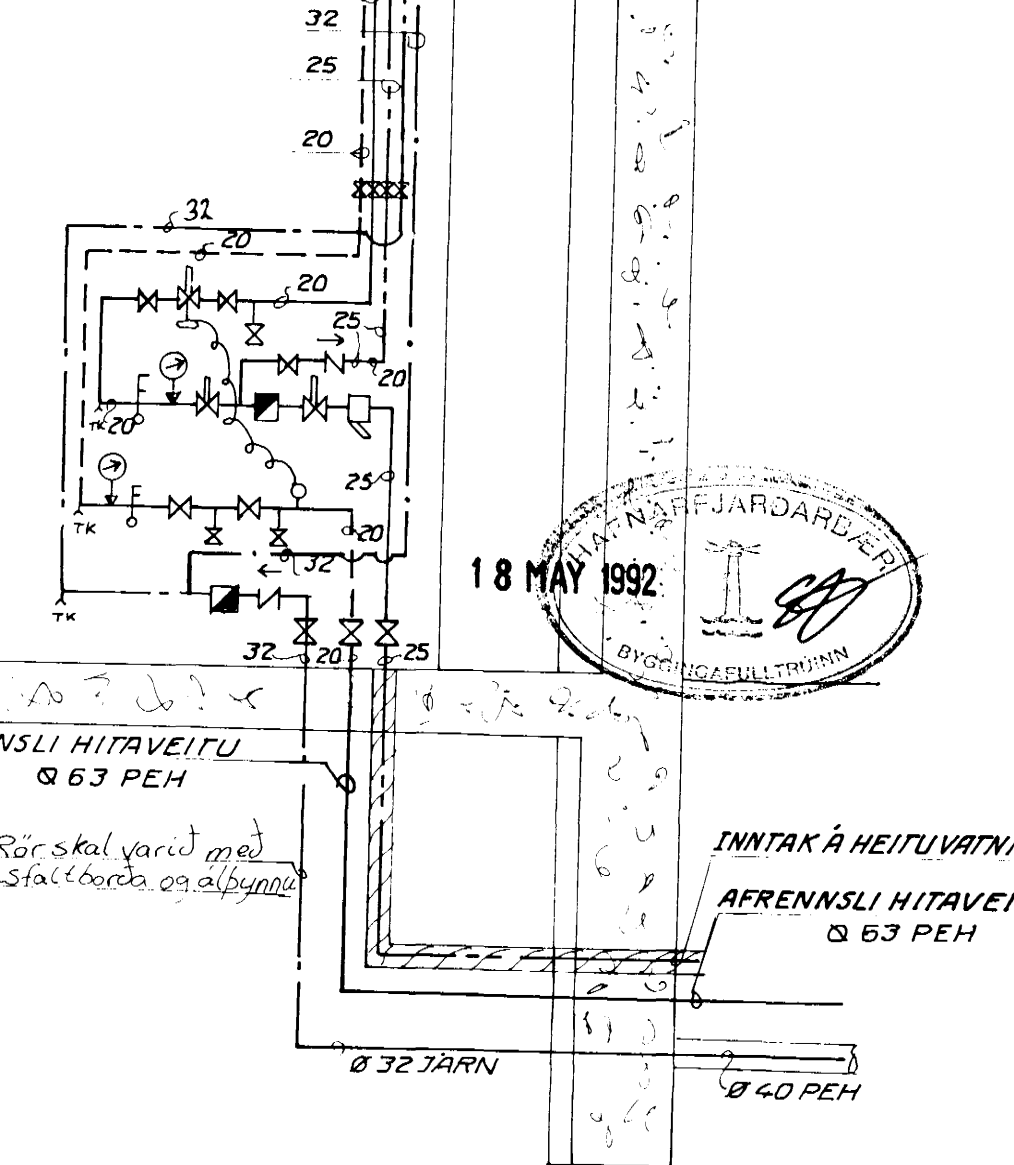

18 MAY 1992

SJA SKYRINGAR A TEIKN. NR. 500-2-01.

Ashild: Eldi teikning isild.

VERKFRÆÐISTOFAN FERILL HF.
 SUDURLANDSBRÁUT 4 REYKJAVÍK SÍMI 688570
 HJALLAHAURUN 4, HAFNARFIRÐI, BIL (H)-01
 HÚSNÆÐI STÖVA-ALMENNRA H.F.
 VATNS- HITA - OG FRÁVEITULAGNIR
 MELAGRIND

DAGS	HANNAÐ	SAMBYKKT
23. júlí 1991	SKIPULAG	
MKV	TEIKNAD	
BR	DAGS	HANNAÐ SAMP

1:50 5. TH. nr. 500 3 01 B