
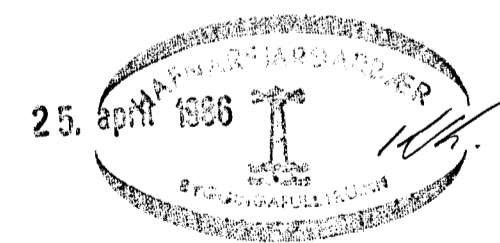


GRUNNMYND 1:50

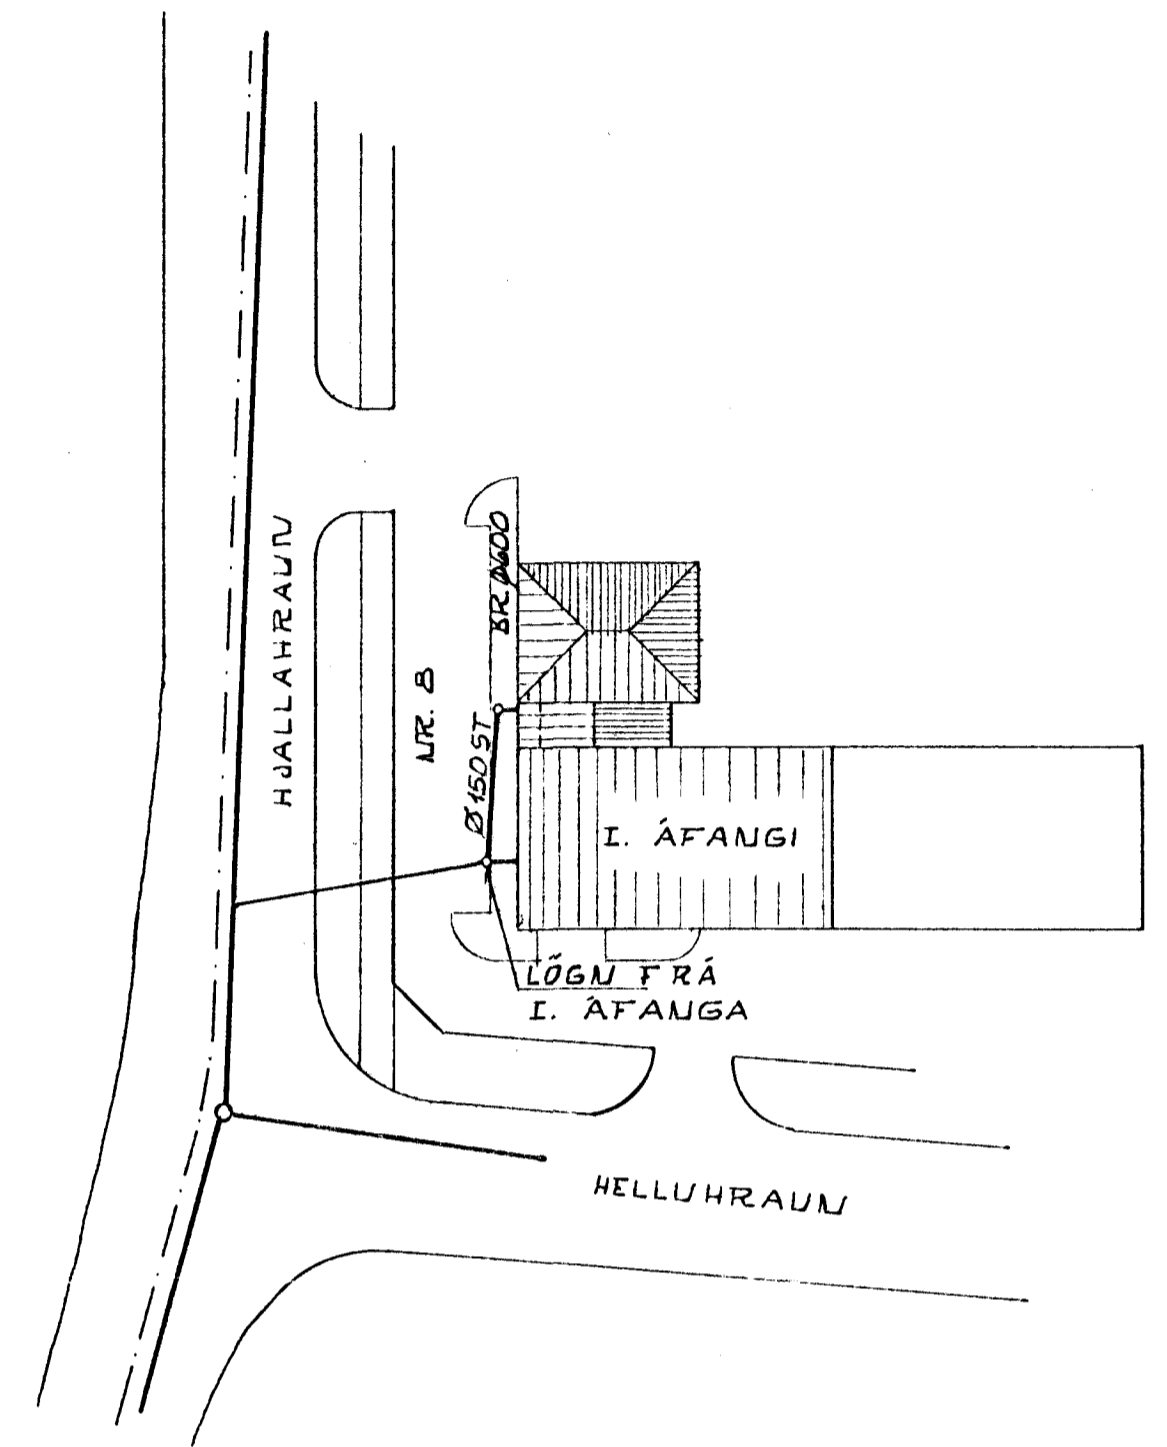

BREYTT: KJALLARI, MARS 86 K.K.

K. KNÚTSSON	
TÆKNIFRÆÐINGUR FTÍ	S 651647
HJALLAHRÁUN 8, II. ÁFANGI	DAGS NÖV. 1985
HAFNARFIRÐI	MKV. 1:50/1:500
LAGNIR Í GRUNNI	BL 1 AF
AFSTÖÐUMYND	VERK. 859-02
FRÆNNISLAGUIR.	