



RÚMMYND VATNSLAGNA 1:50

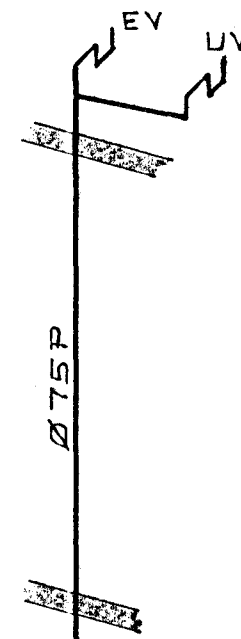


LAGNR TENGJAST MÆLAGRIMI
I. ÁFANGA.

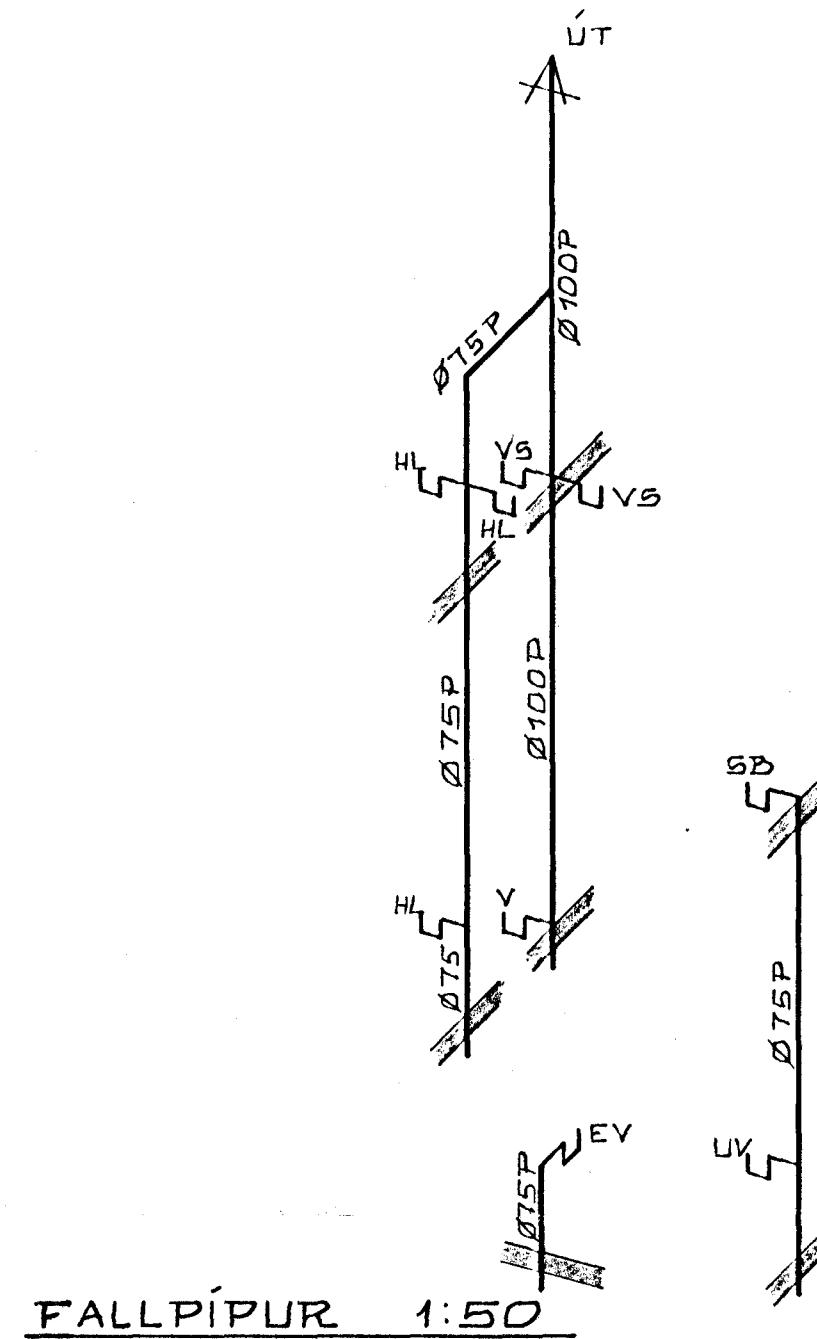

FALLPÍPUR 1:50

SKÝRINGAR SJÁ BL. NR. 2

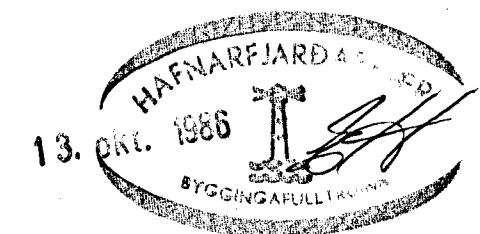

KRISTJÁN KNÚTSSON
TÆKNIFRÆÐINGUR FTFI 5 651647

HJALLAHRÁUN 8, II ÁFANGI HAFNARFIRÐI.	DAGS APRÍL 86
RÚMMYND VATNSLAGNA FALLPÍPUR	MKV. 1:50 BL 7 AF VERK. 859-02
HITA- OG HREINLÆTISLAGNIR.	

ÞREYTING.
SEPT. 86: LEGU LAGNA. K.K.