


GRUNNMYND 1:50

HÆD U. GLUGGA - SJA TEIKN. 2I

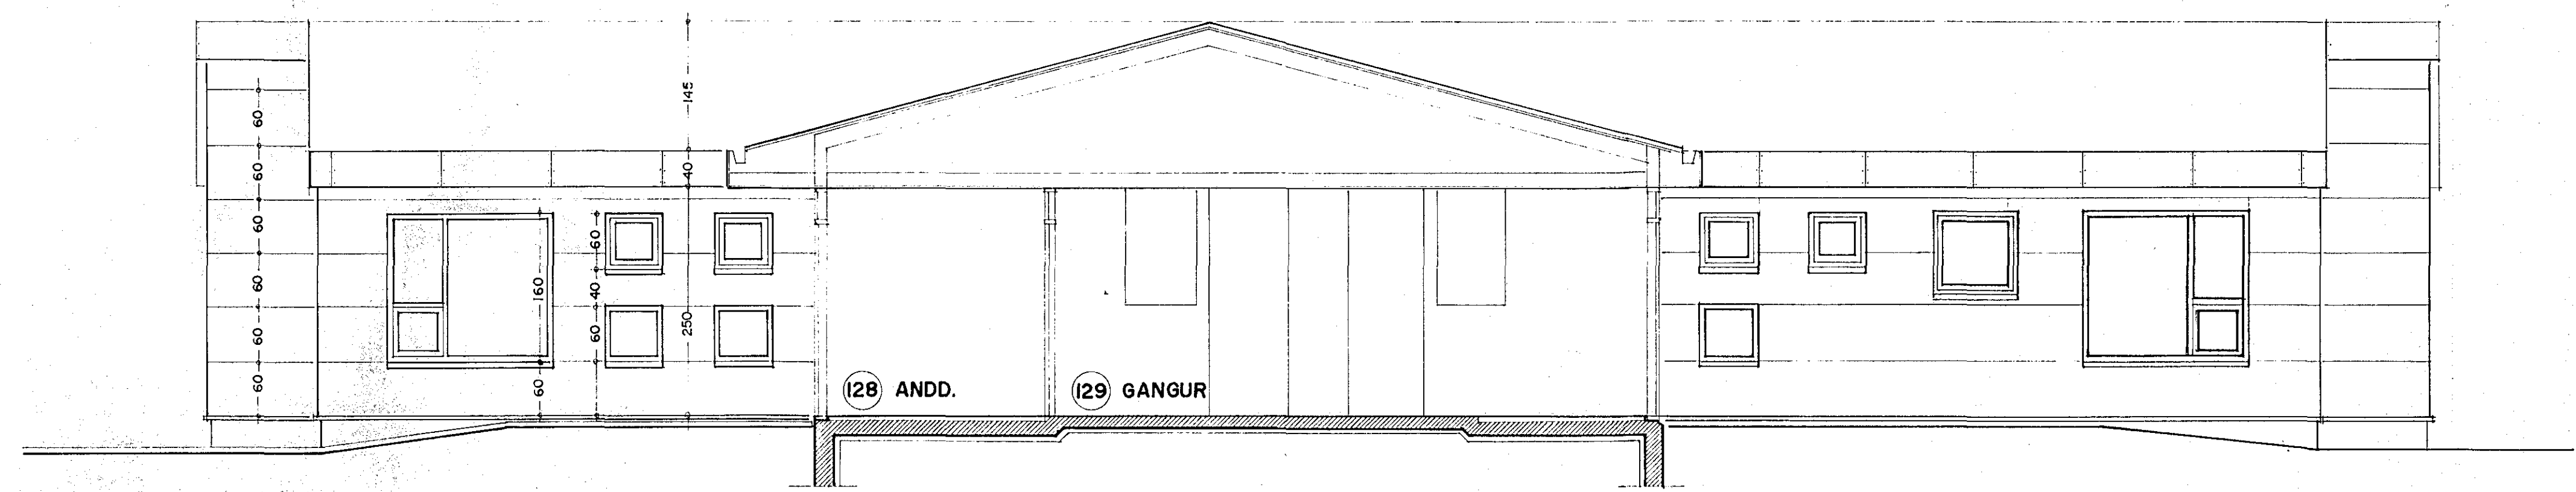

SNEIÐING A-A 1:50

DAGS. BREYTT
27.07.92 INNHURÐIR, GLUGGAR, WC

LEIKSKÓLI - SETBERGI
GRUNNMYND, SNEIÐING 1:50
06.07.92 11
Arsæll Vignisson arkitekt
Bæjarhrauni, Hf s.65 30 81