



Bjallari

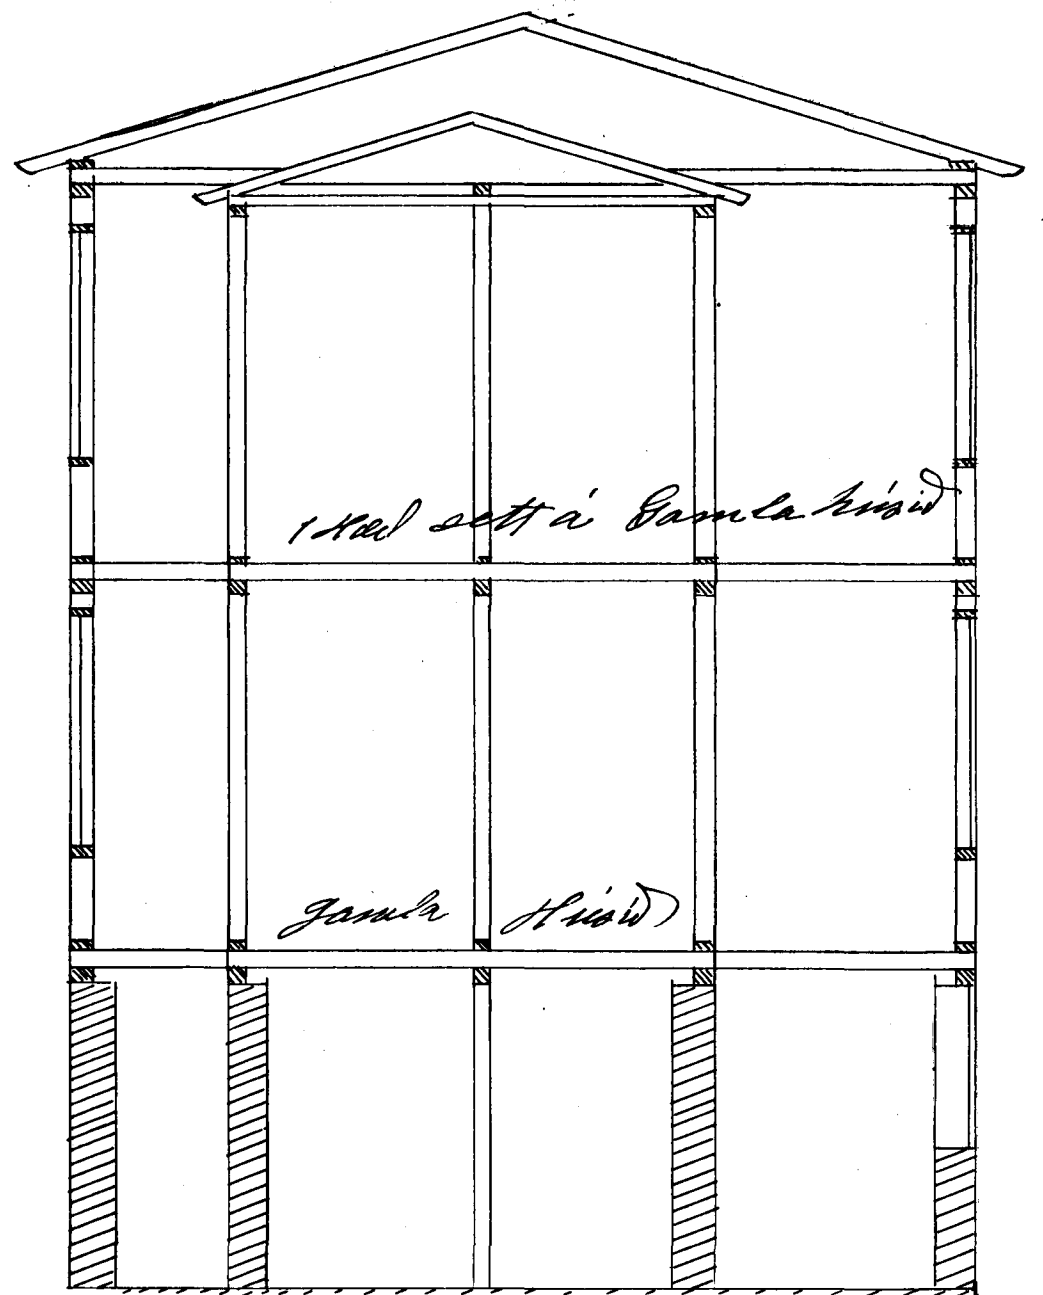


poorstandur

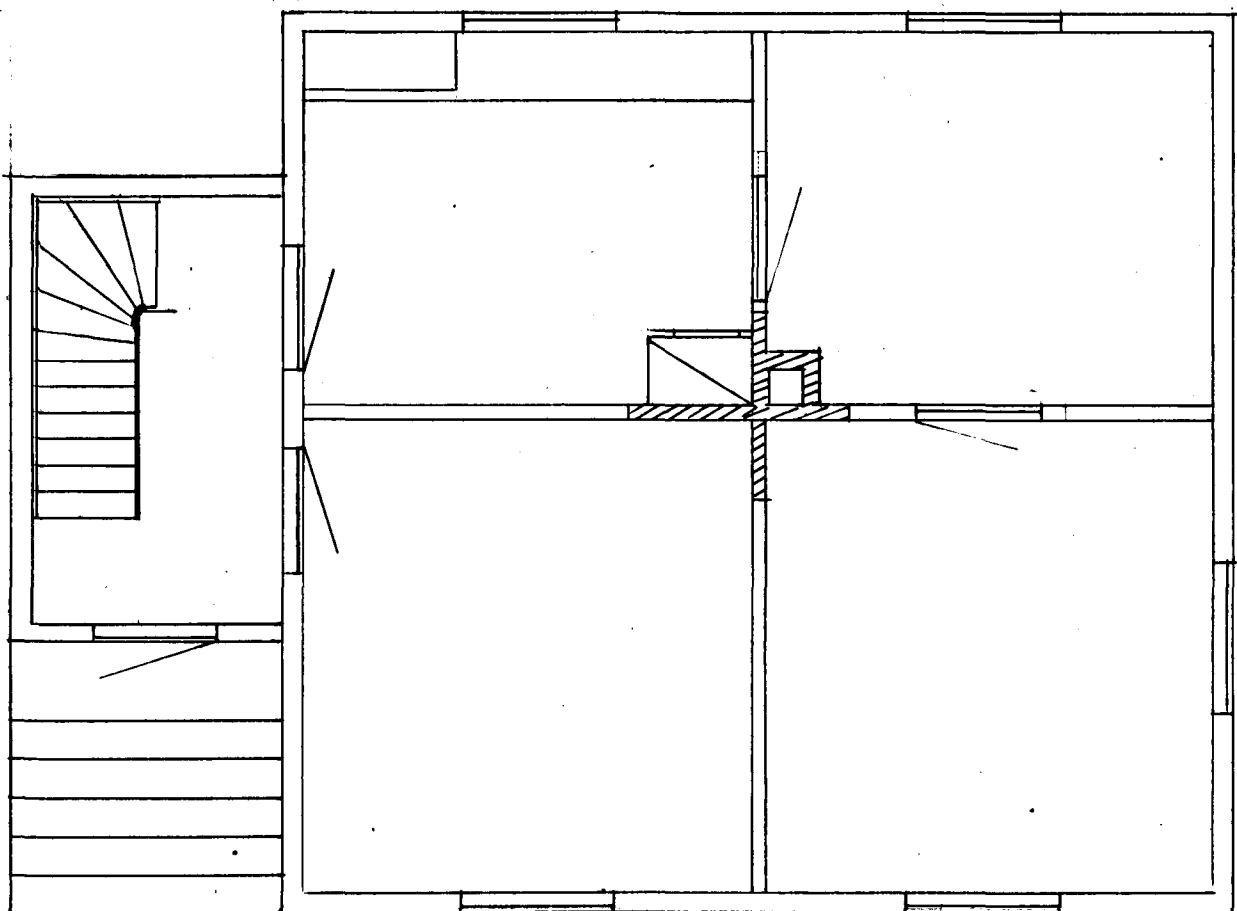

1. Gólf málb. 1.50 m.

Strogs gata n. 4

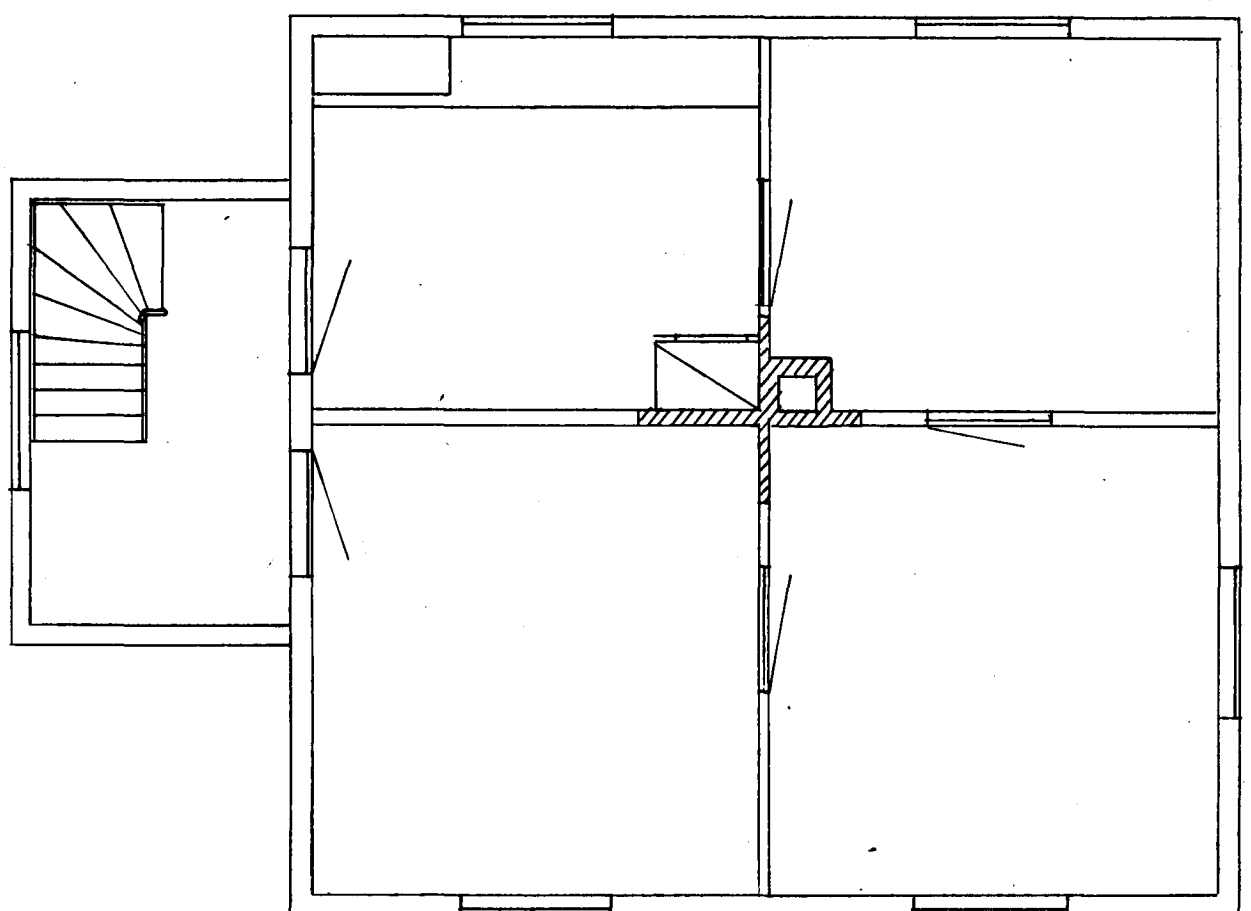

II Gólf

Hafnarfgati

Hús Einars Jónssonar