



GRUNNMYND RISHÉÐAR 1:50

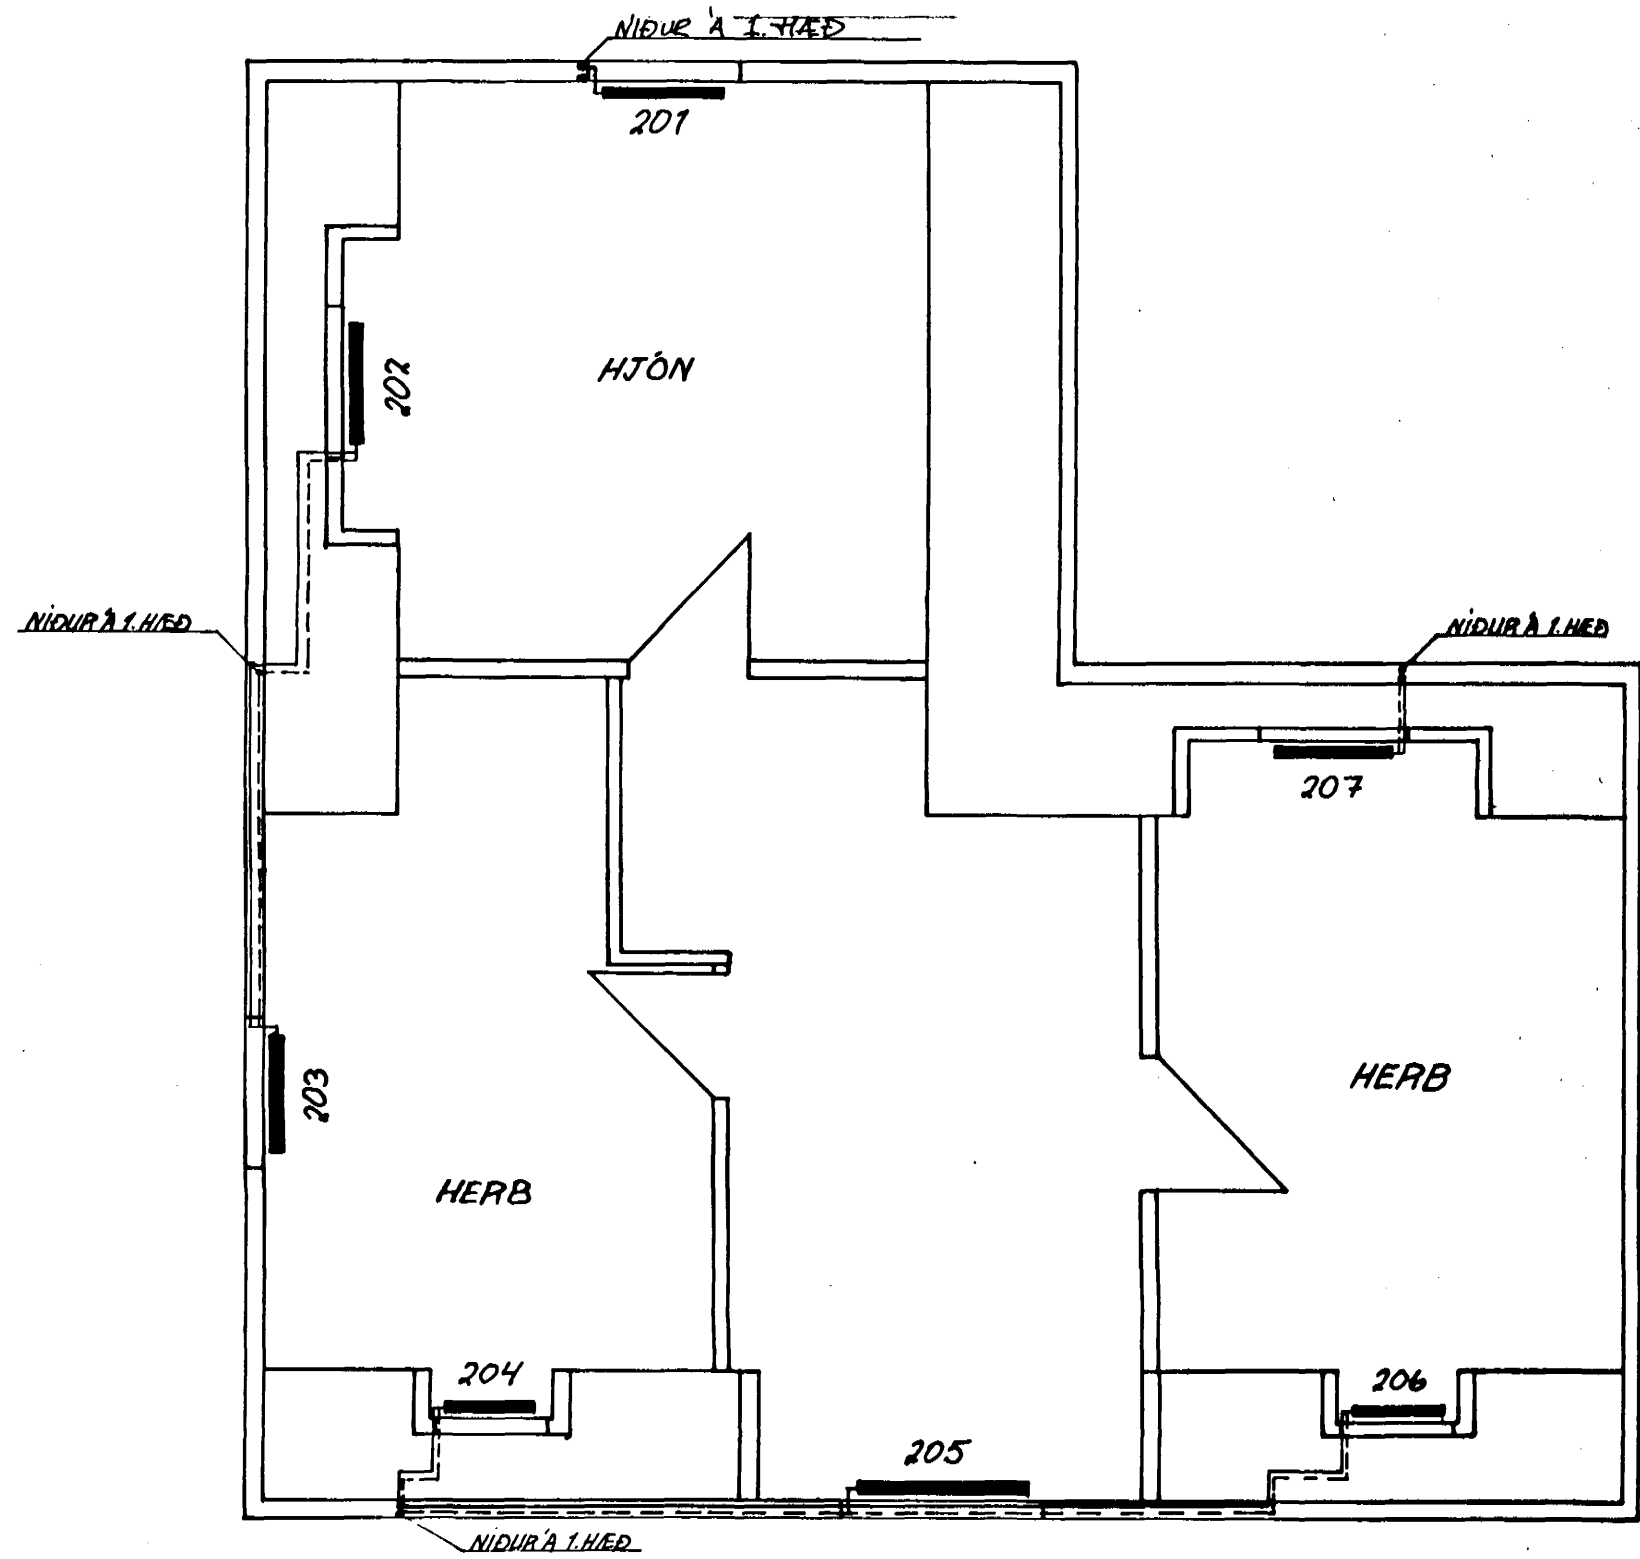


RÚMMYND HITALAGNAR 1:50

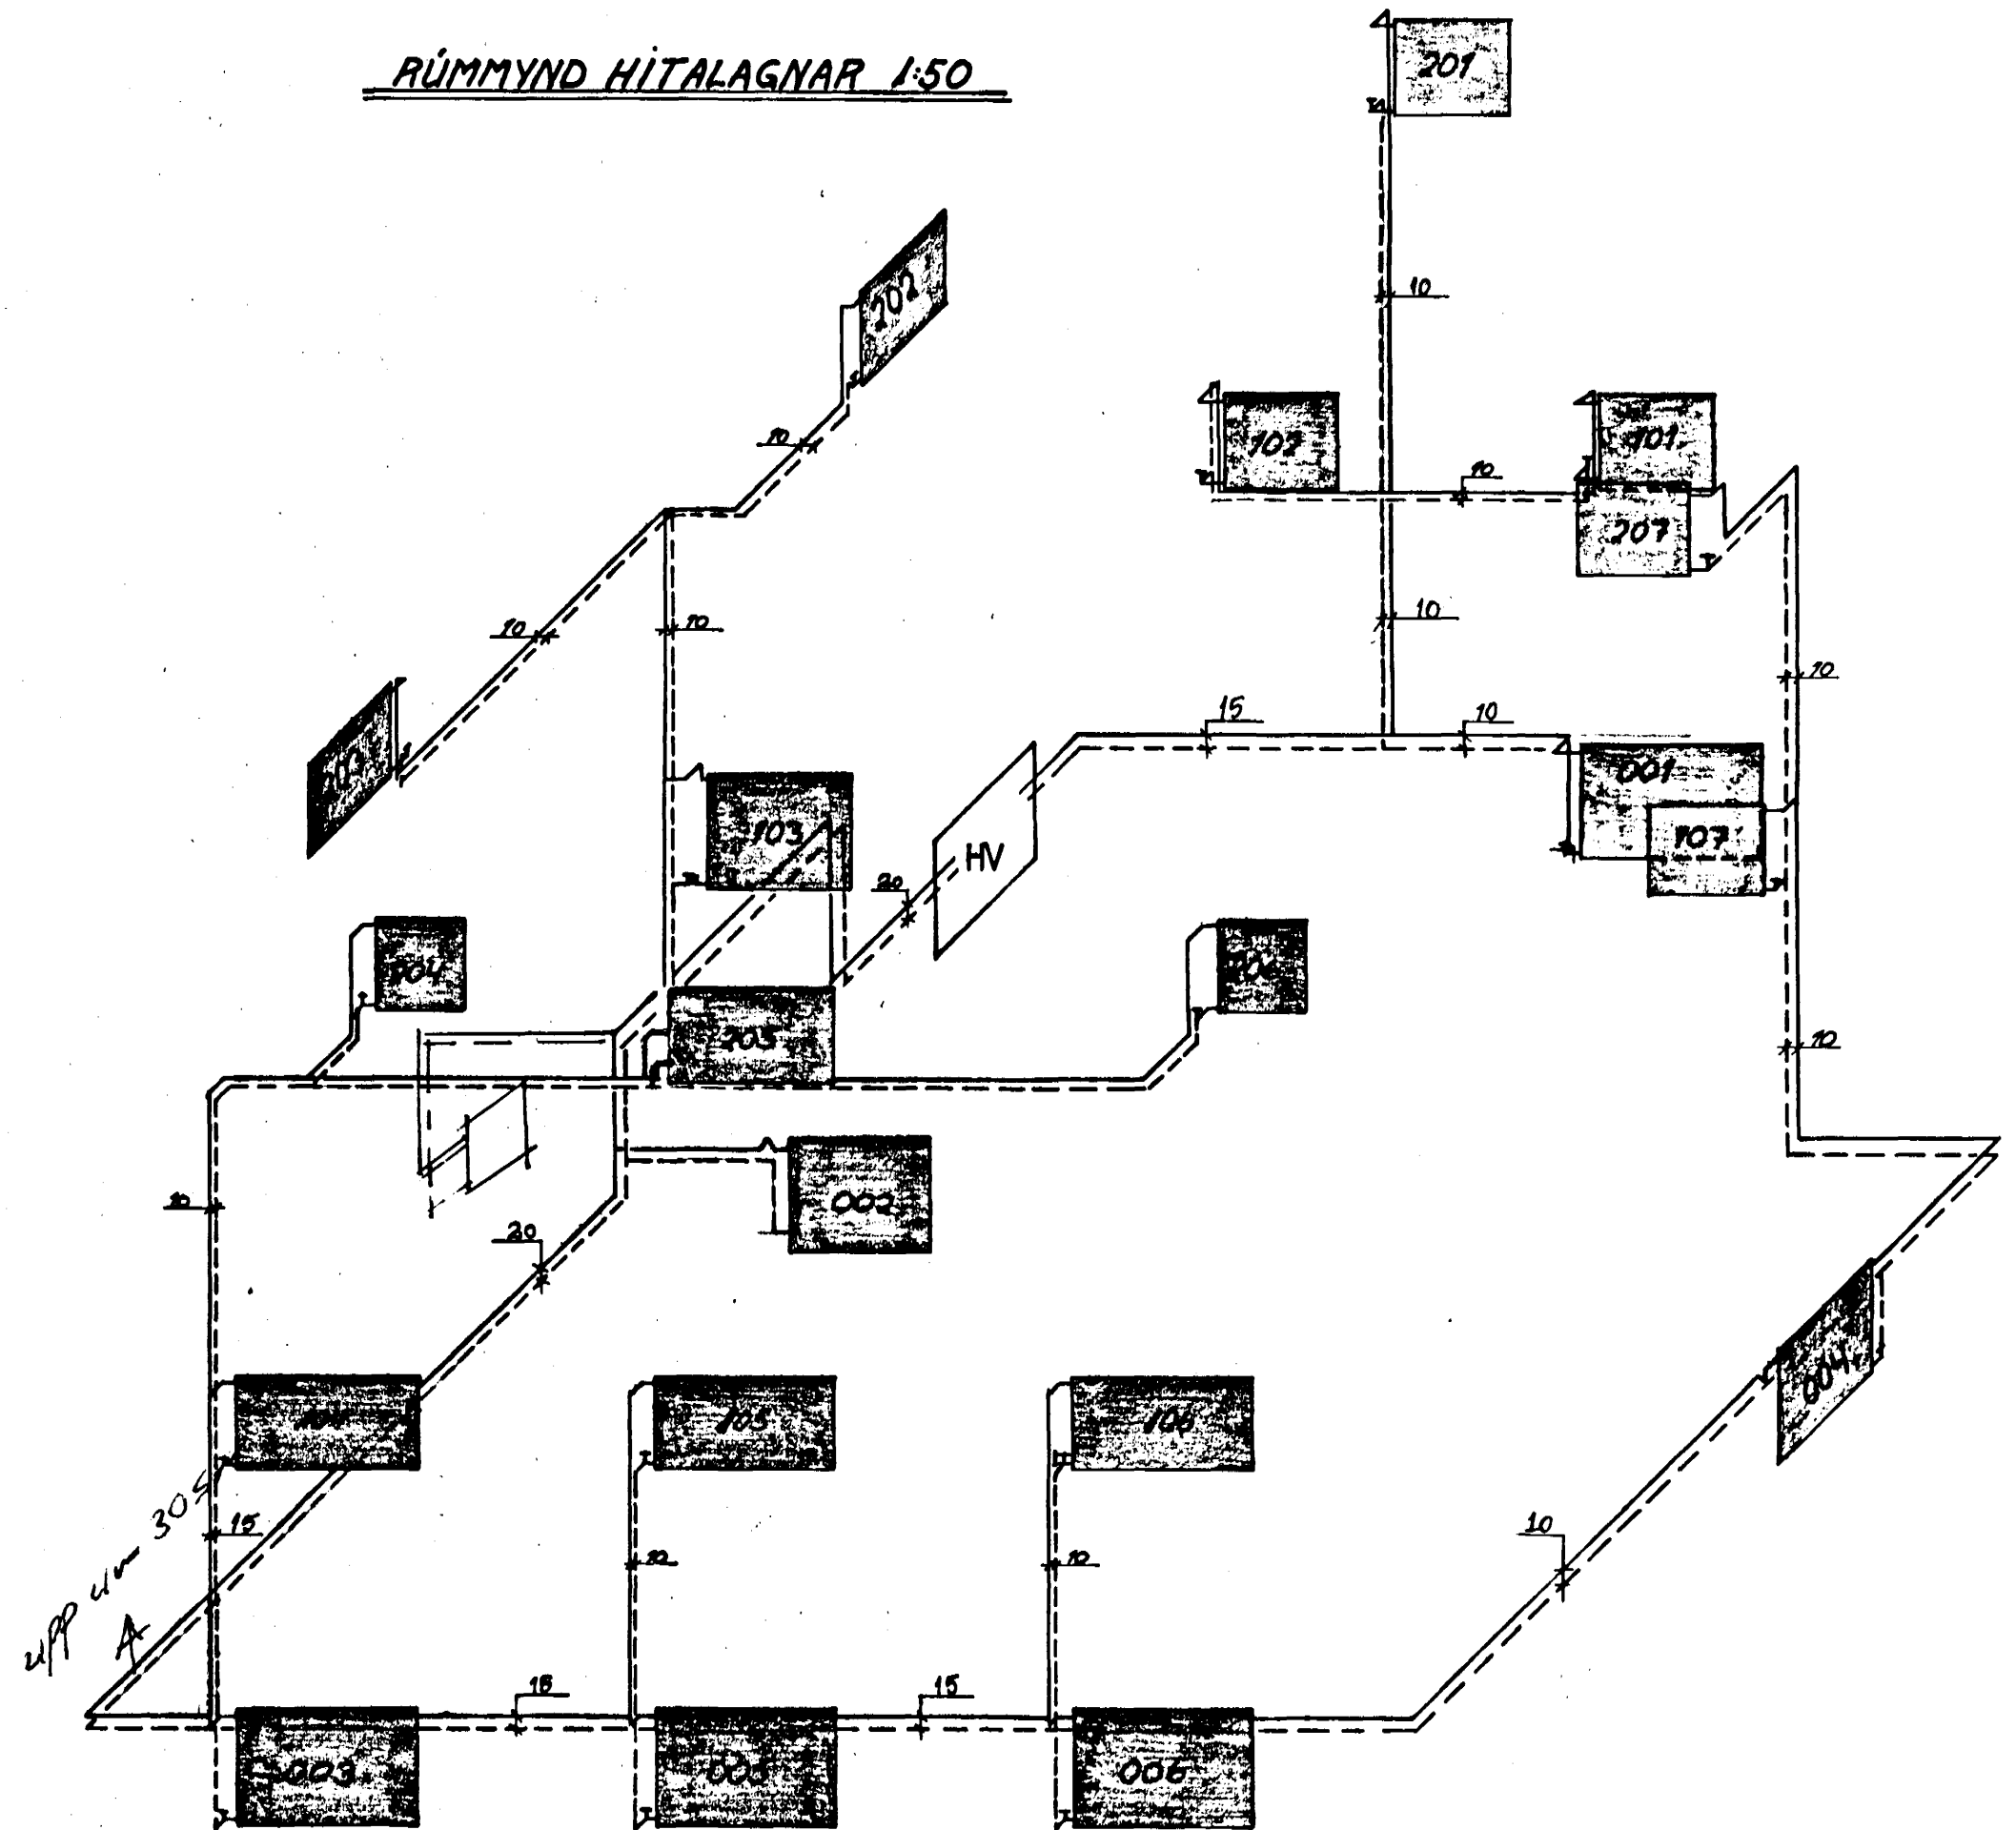

OFNASKRÁ  $\Delta T = 40^\circ C$

NR	HITATAP WÖTT	MESTA LENGÐ	MESTA HÉÐ	TENGI	OFN
001	1511	175	80	AB 10	
002	573	100	80	CD 10	
003	1451	124	80	CD 15	
004	913	70	80	BC 10	
005	1131	124	80	CD 15	
006	807	124	80	CD 15	
101	682	80	65	AB 10	
102	411	80	65	AB 10	
103	785	100	80	CD 15	
104	1409	124	65	CD 15	
105	1019	124	65	CD 15	
106	1019	124	65	CD 15	
107	780	80	65	CD 15	
201	957	80	65	AB 10	
202	957	80	65	AB 10	
203	669	80	65	CD 10	
204	669	60	65	CD 10	
205	1393	114	65	CD 10	
206	792	60	65	CD 10	
207	792	80	65	CD 10	

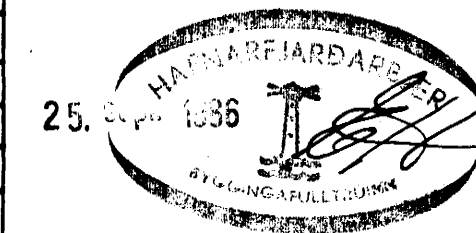

BREYTT Í SEPT. '86 GH.

HÍÐARBRÁUT 5 HAFNARFÍRÐI	VERK	BL. NR 4.2.
HITALAGNIR GRUNNMYND, RÚMMYND OFNASKRÁ	HAFNARF. JÚNÍ '83 MKV 1:50	REIKN. S.P. TEIKN. S.P. SAM. J.P.
VERKFRÆÐI STOFA HALLDÓRS HANNESSONAR REYKJARVÍKURVEGI 60 HAFNARF. S. 54355		