


Hnotuberg 15
Uppfært: nóv 2017

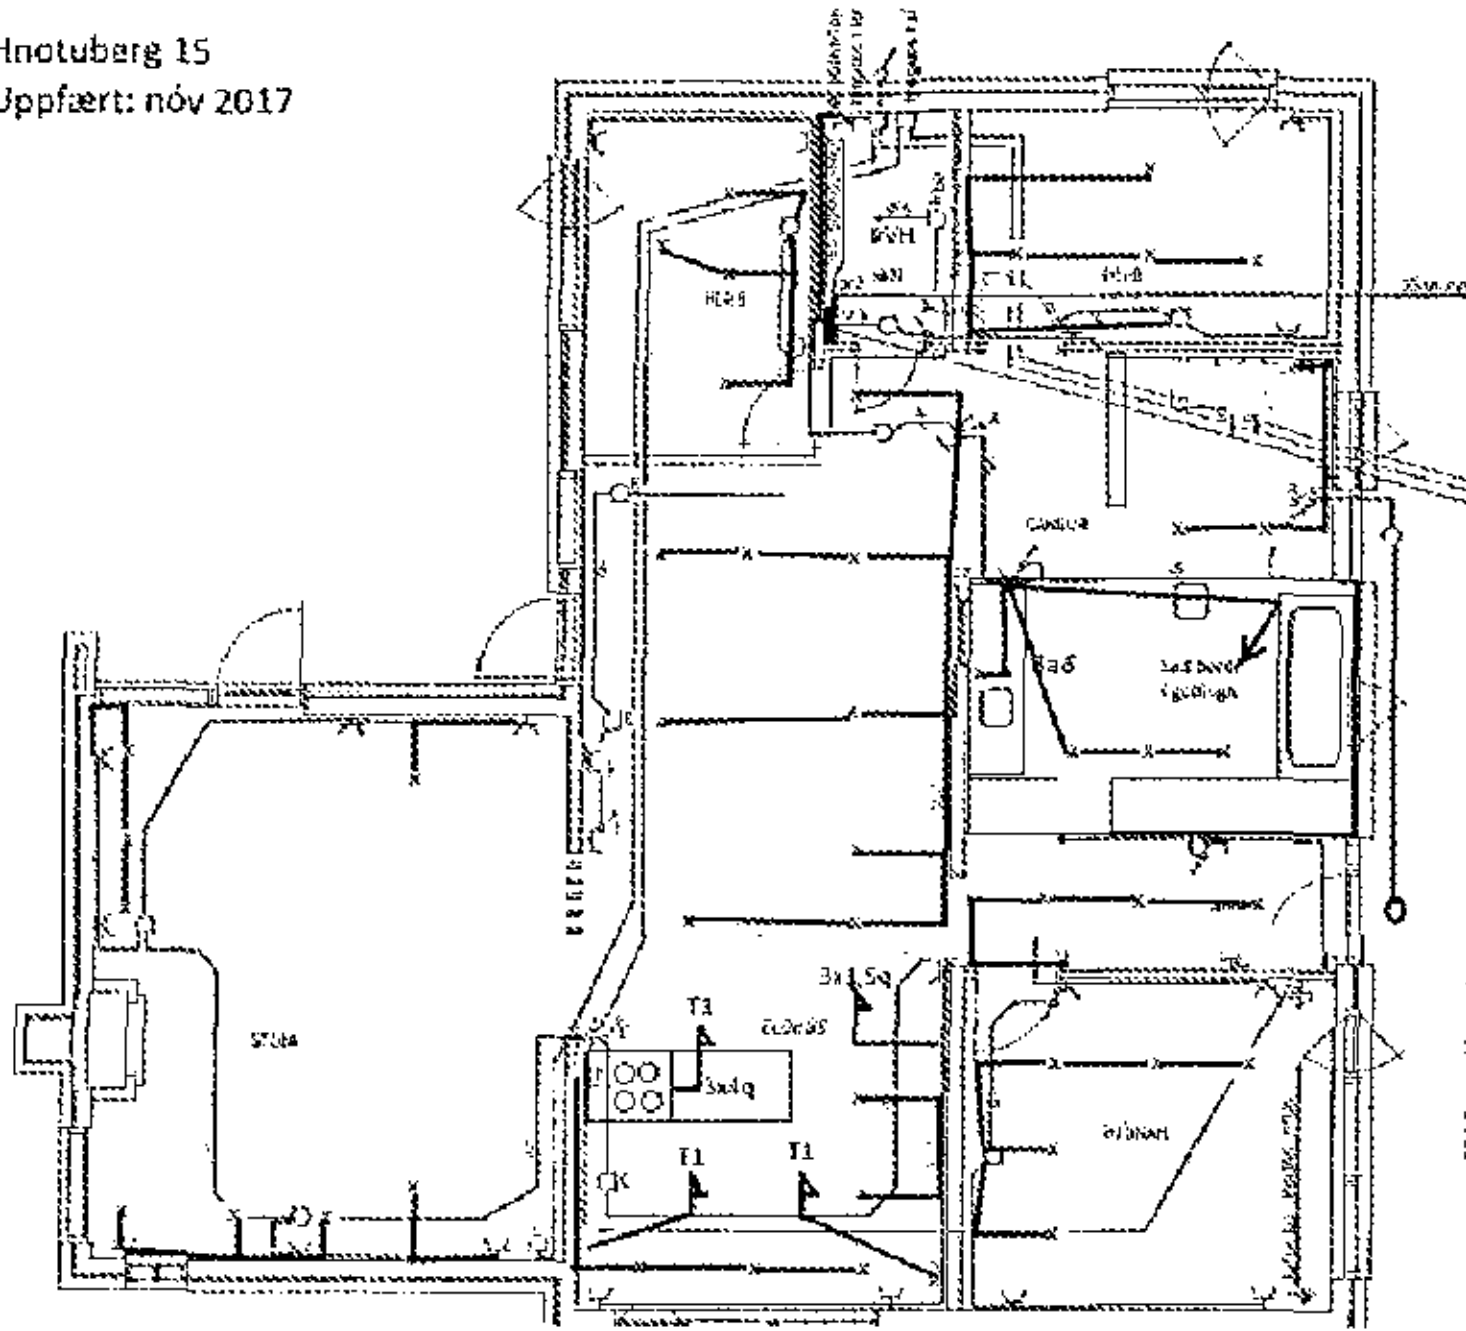

Úr Gildi