



Samþykkt á fundi bygginga-  
nefndar þ. 30. 5. 1984  
BYGGINGAVALDSTYRIÐ  
Í HAFNARFIRÐI

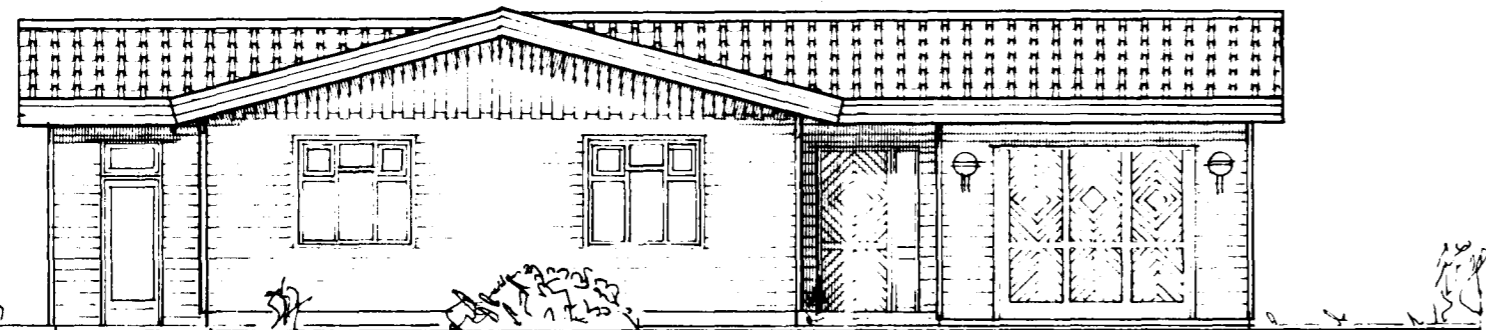


SUDUR

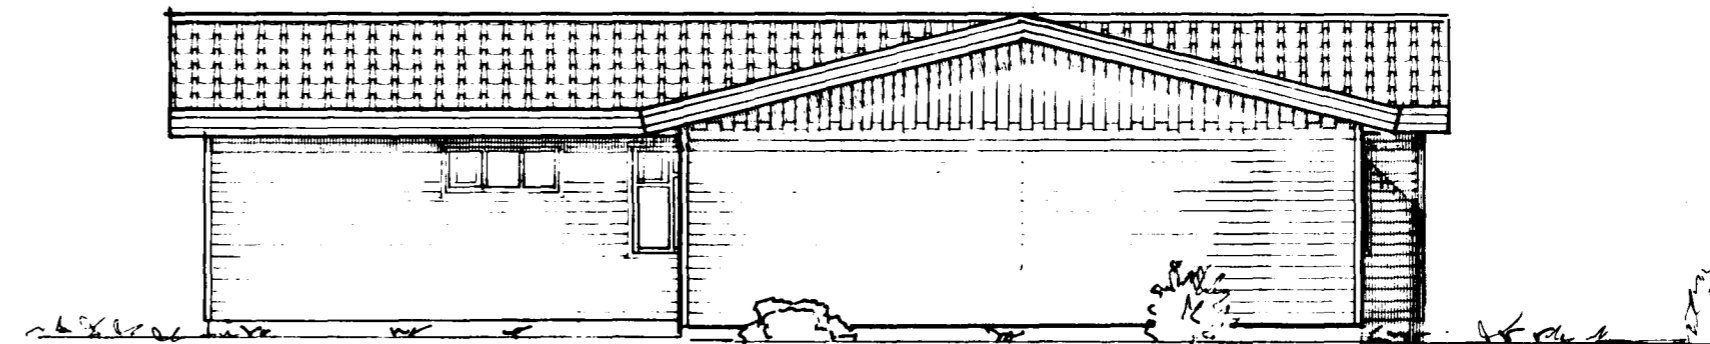


AUSTUR

tifftopdf - www.rubissoftware.com - Demo Version

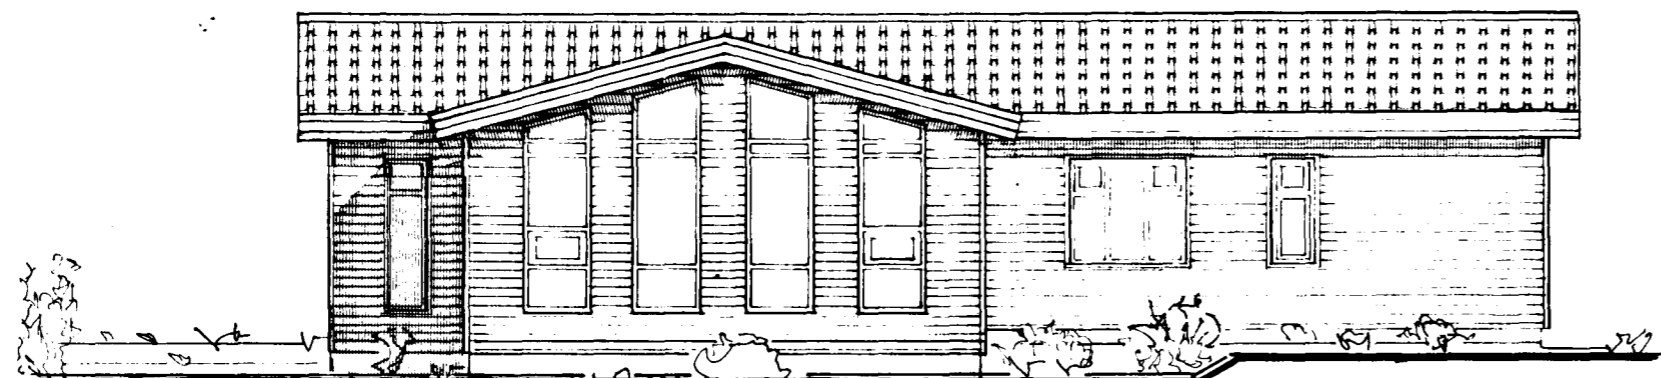

VESTUR

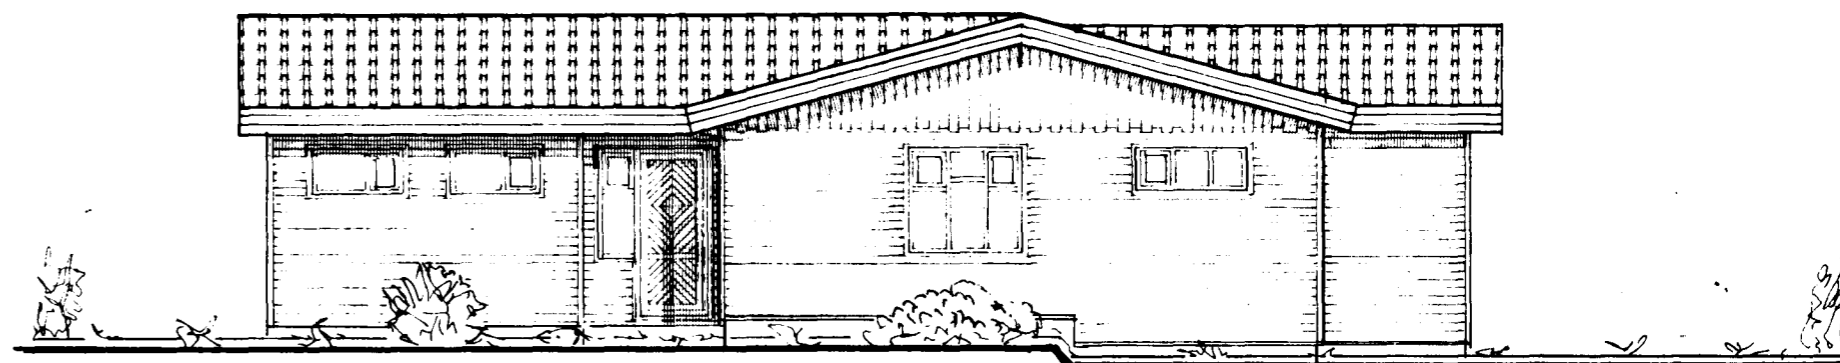

NORÐUR

3960-0250. 01  
02

BREITT NOV 84



Bolholt 6, 3.h. Reykjavík Sími (91) 82414

VERKEFNI	HNOTUBERG 25, HAFNARFIRÐI	KVARÐI 1:100	VERK NR. 8420
DAGS.	APRIL 84	HÖNNUN	G.G.
HEITI	ÚTLITSMYND	TEIKN	G.G.
			TÝPA NR.
			TEIKN. NR.

*Gísli Gunnarsson*

