


HNOTUBERG NR. 31 GRINDVERK

*Jón Halsteinsson 23/4 90*  
*Sampipi grindská lötur mörkum.*

NR. 2

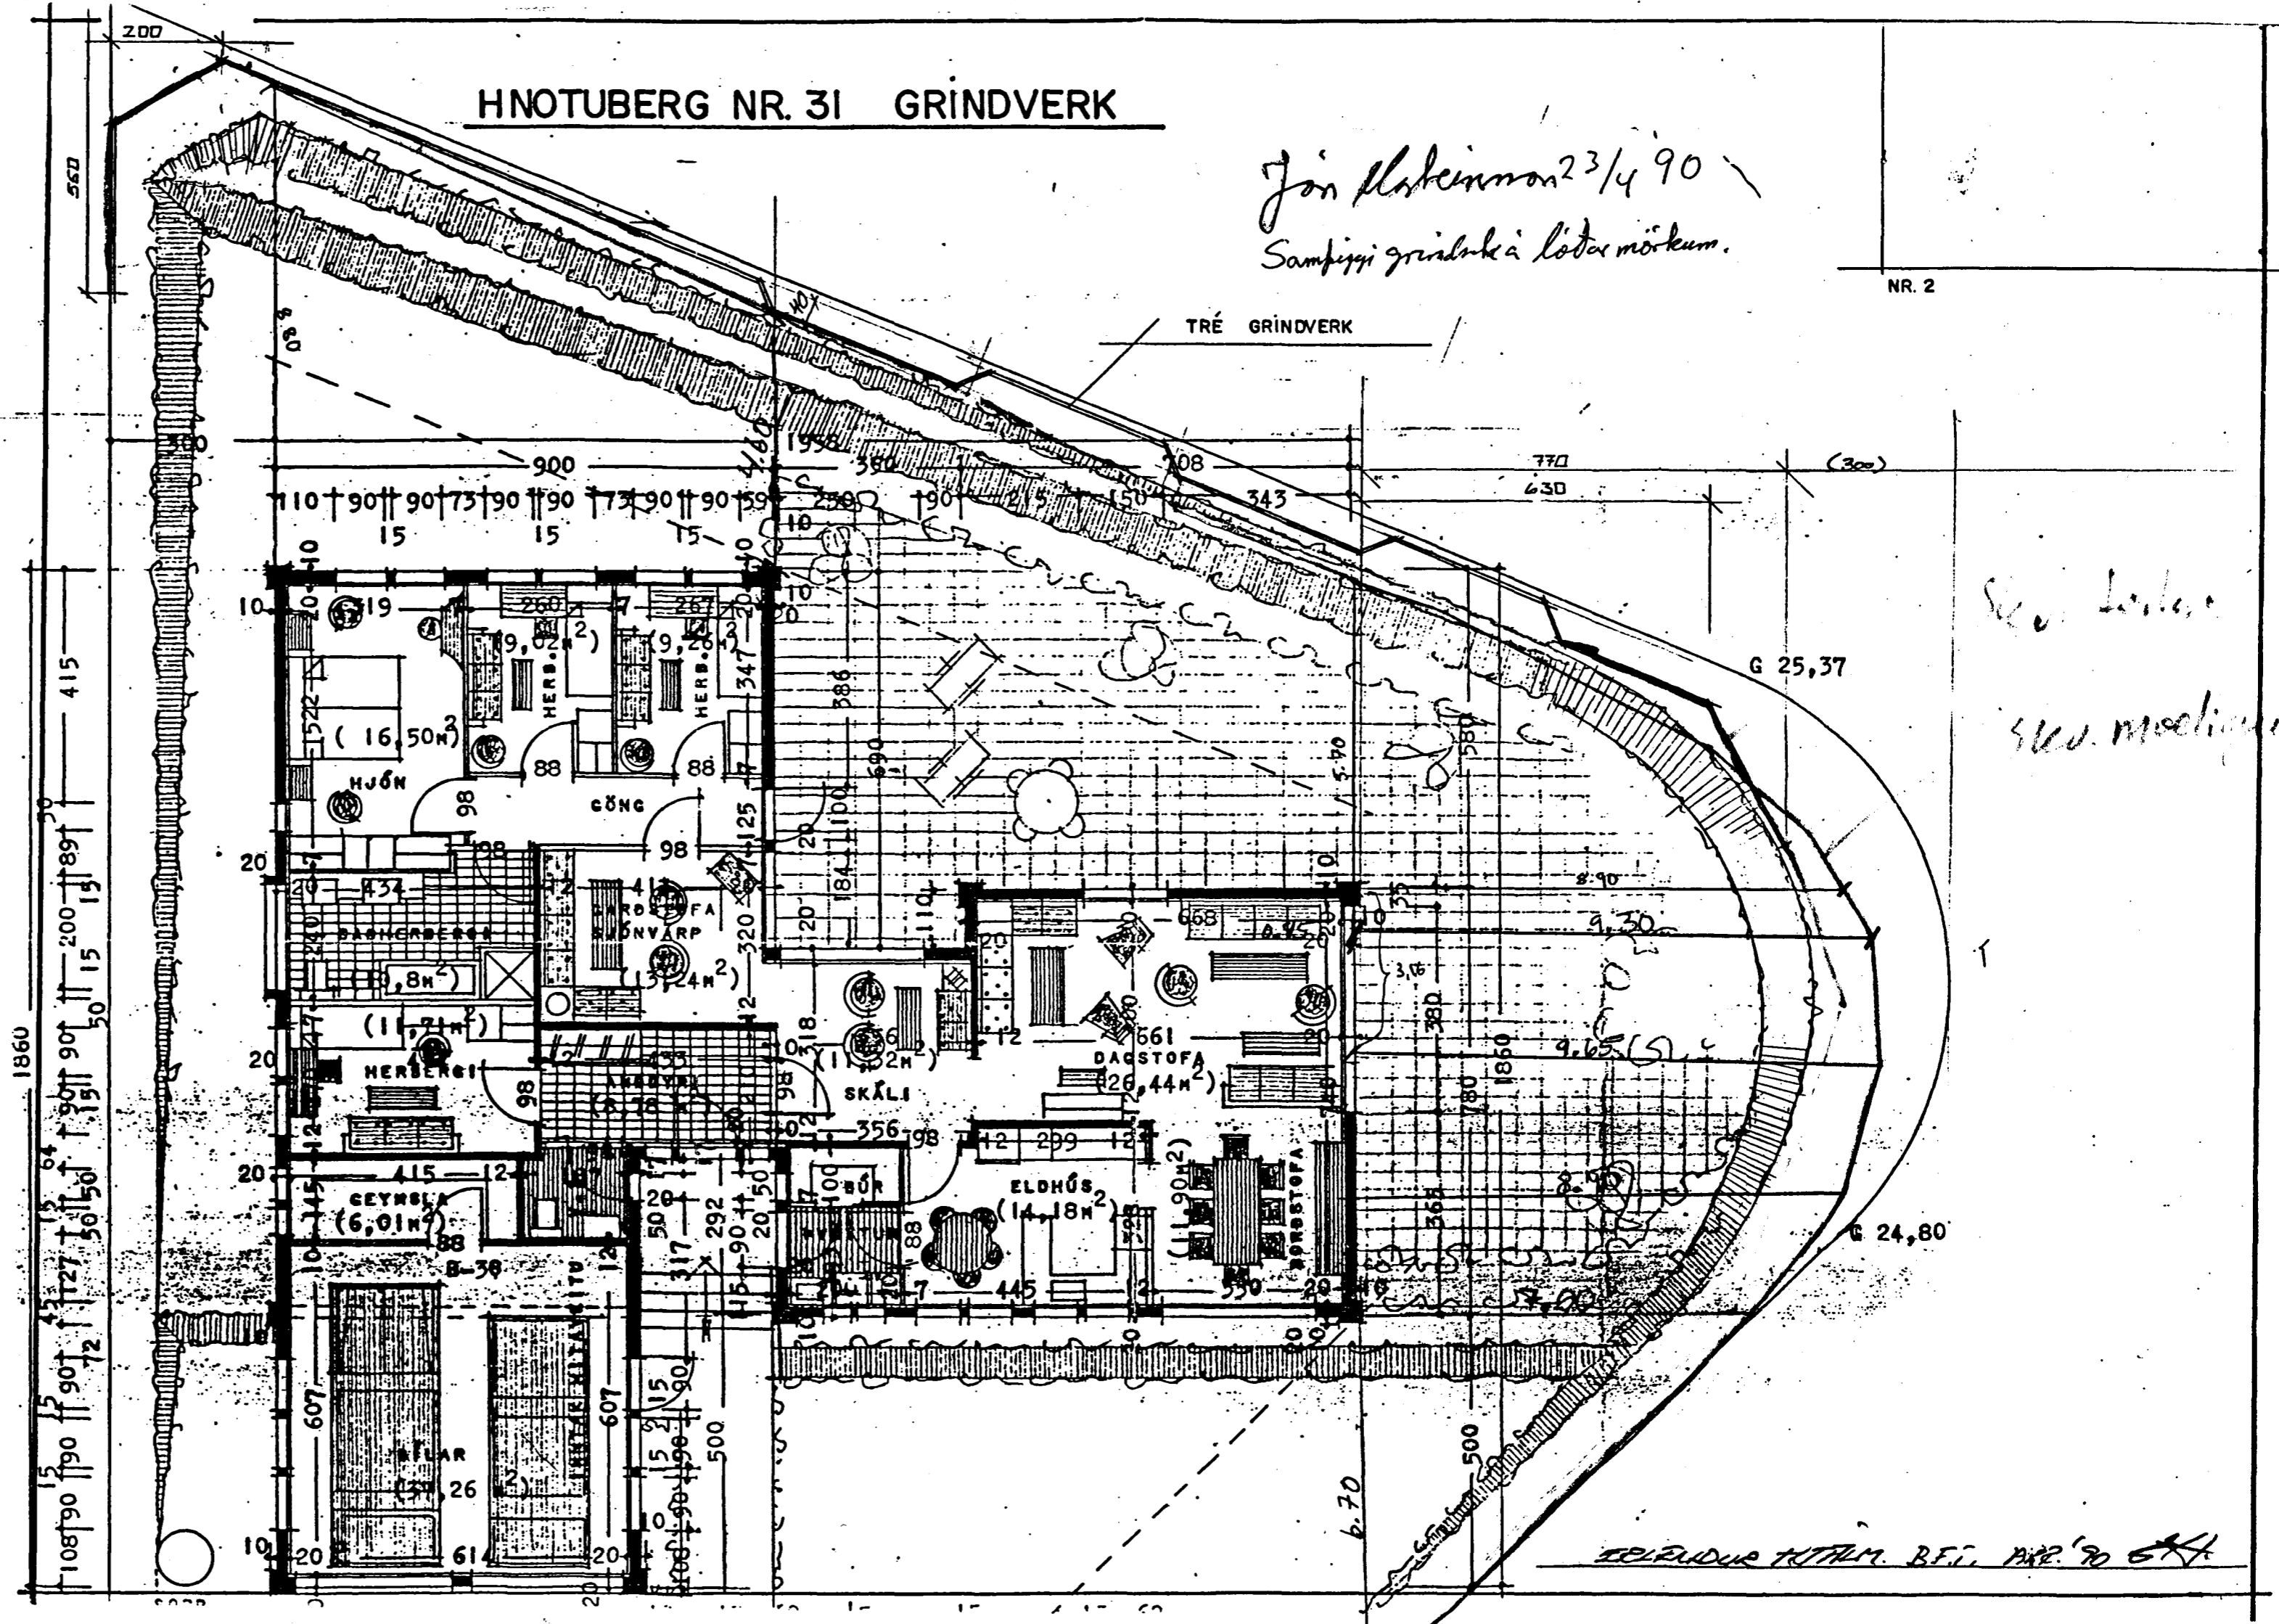


EÐLIFUR HJALM. B.F.I. APR. '90