

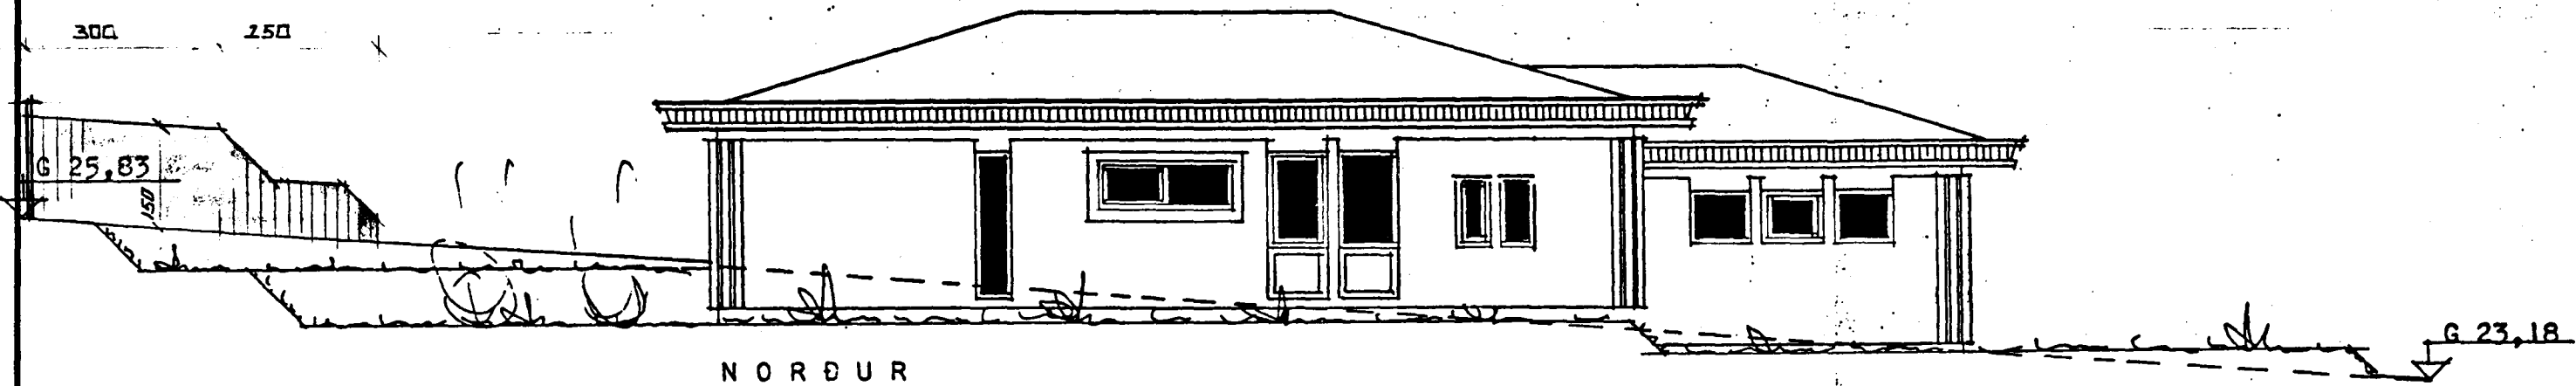


HNOTUBERG NR. 31 GRINDVERK.

NR. 3

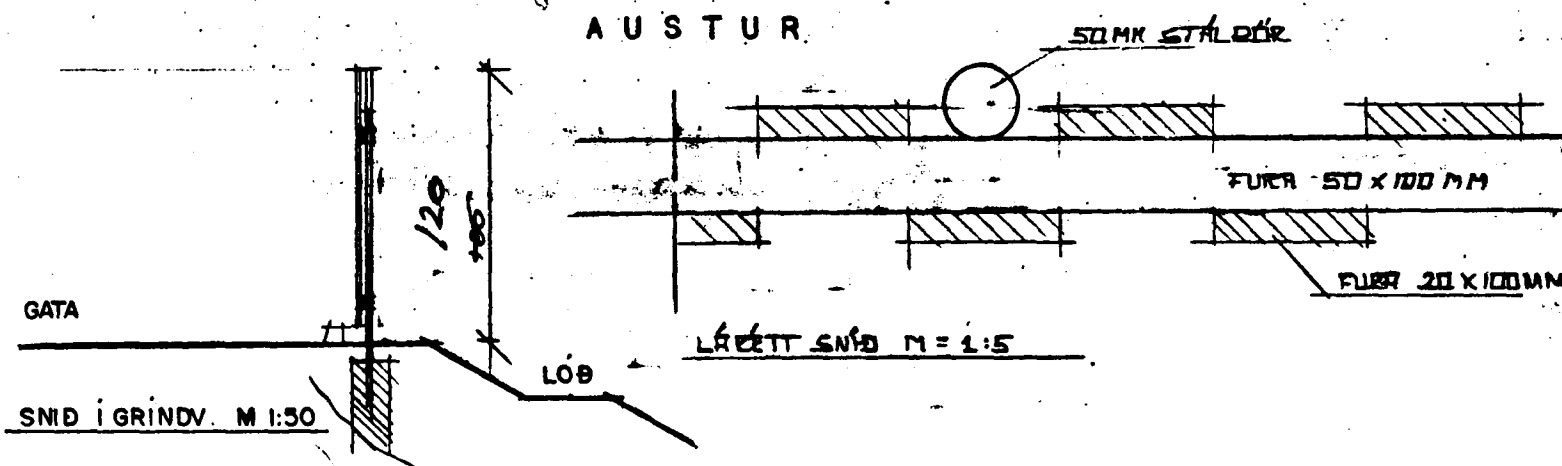

tifftopdf - www.rubissoftware.com - Demo Version

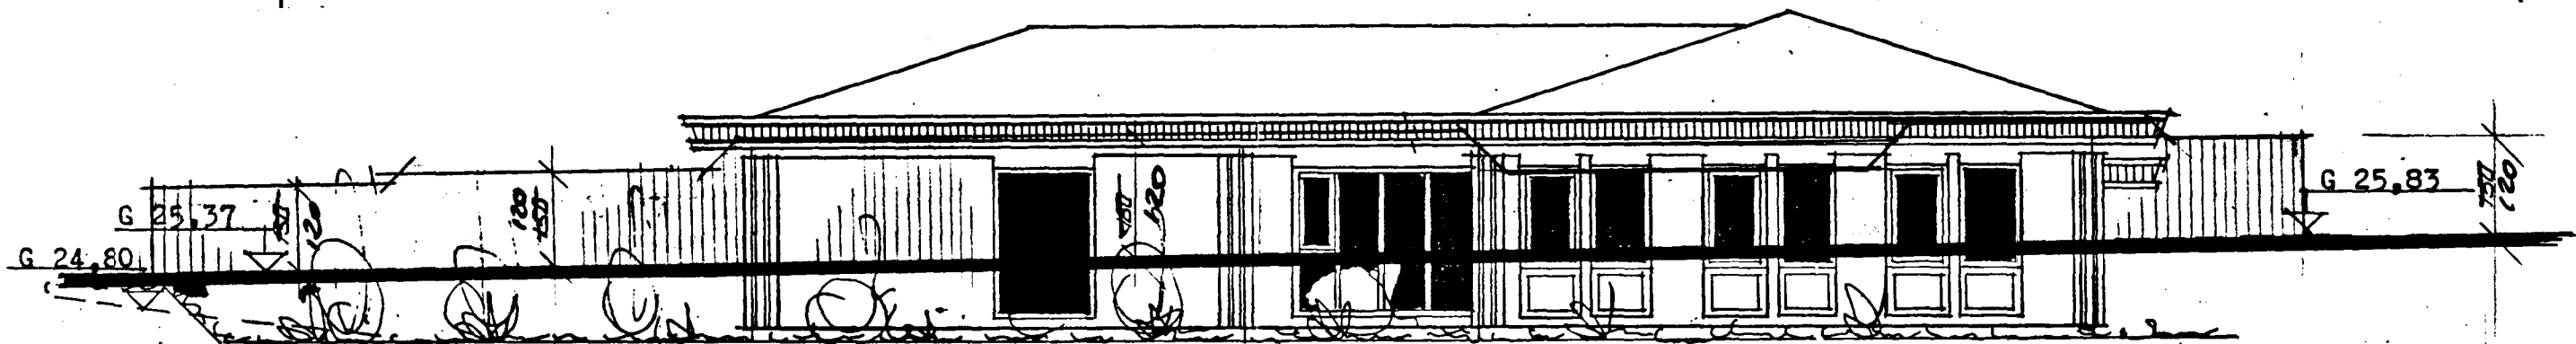

DEL. HÖFALM. B.F.I. MAR 90