

HÓLABRAUT NR. 10


Samþykkt á fundi bygginga-  
nefndar þ. 1. 13. 1990

BYGGI GAFULLTRÚINN  
Í HAFNAREIRDI

*För Jónsson*




VESTUR

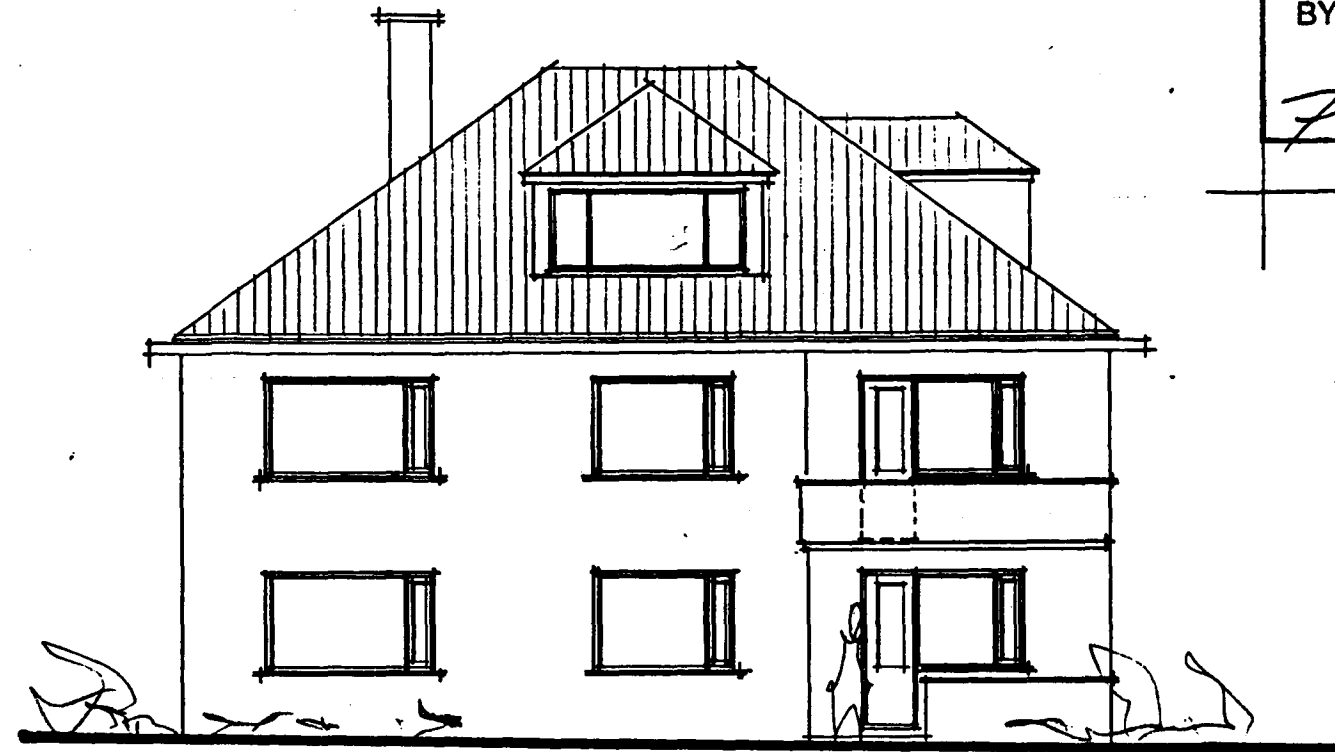


NORÐUR

tifftopdf - www.rubissoftware.com - Demo Version

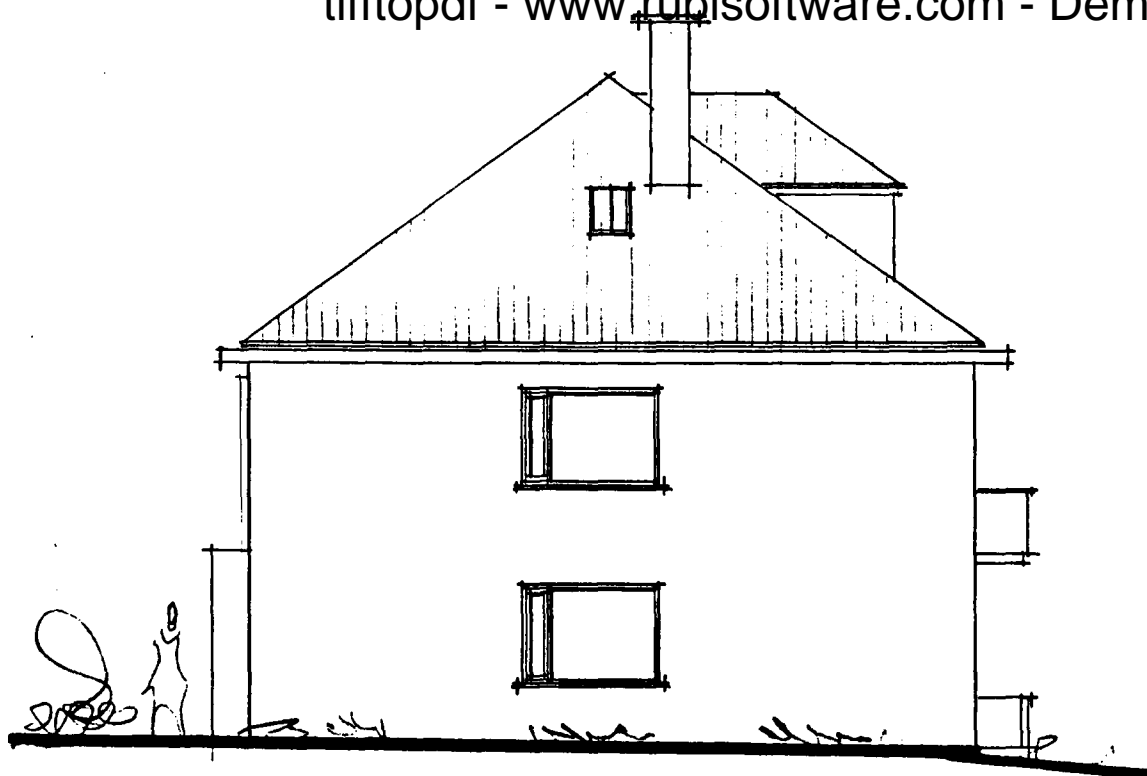

AUSTUR

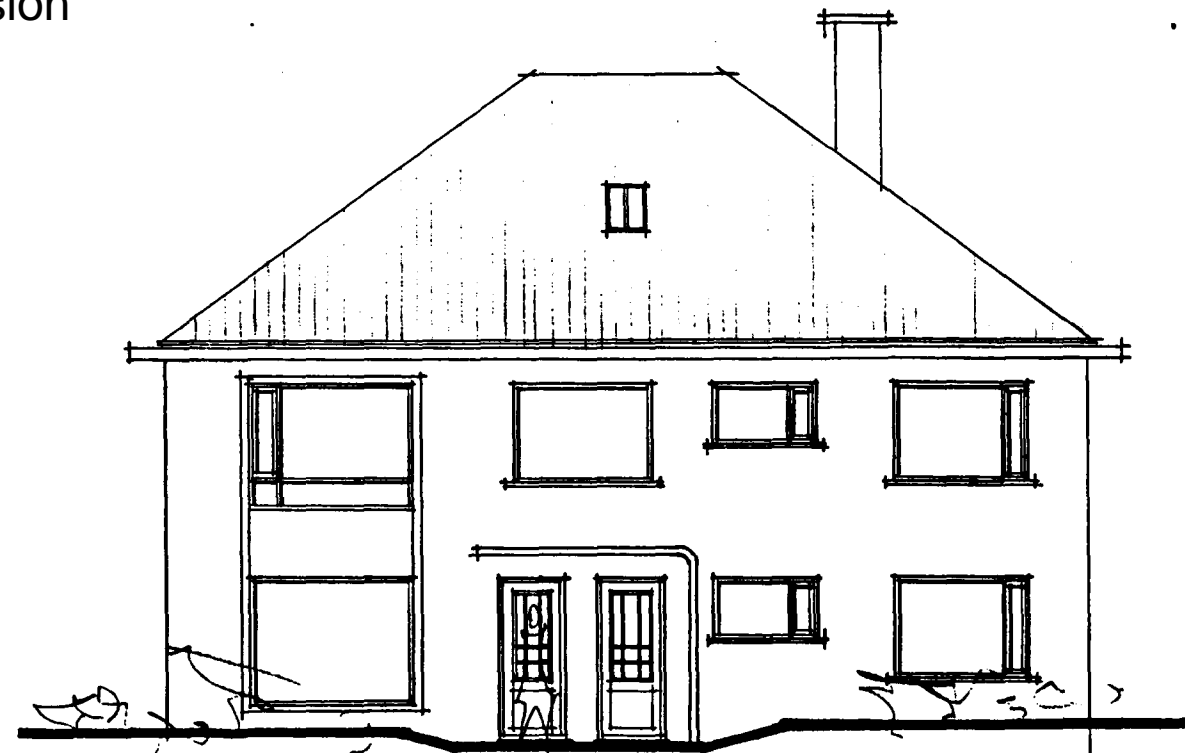

SUÐUR

HÓLABRAUT 10 HAFNARÉ

TEIKN. NR. 101

EFNI.

MÁL. 1:100

GLUGGABREYTING

DAGG. FEBR. '90

ERLENDUR Á. HJÁLMARSSON, b.f.i. ÁLFASKEIÐI 80 H. S-53860