



HÓLABRAUT NR 19 SNID Í ÞAKBRÚN M. 1:5

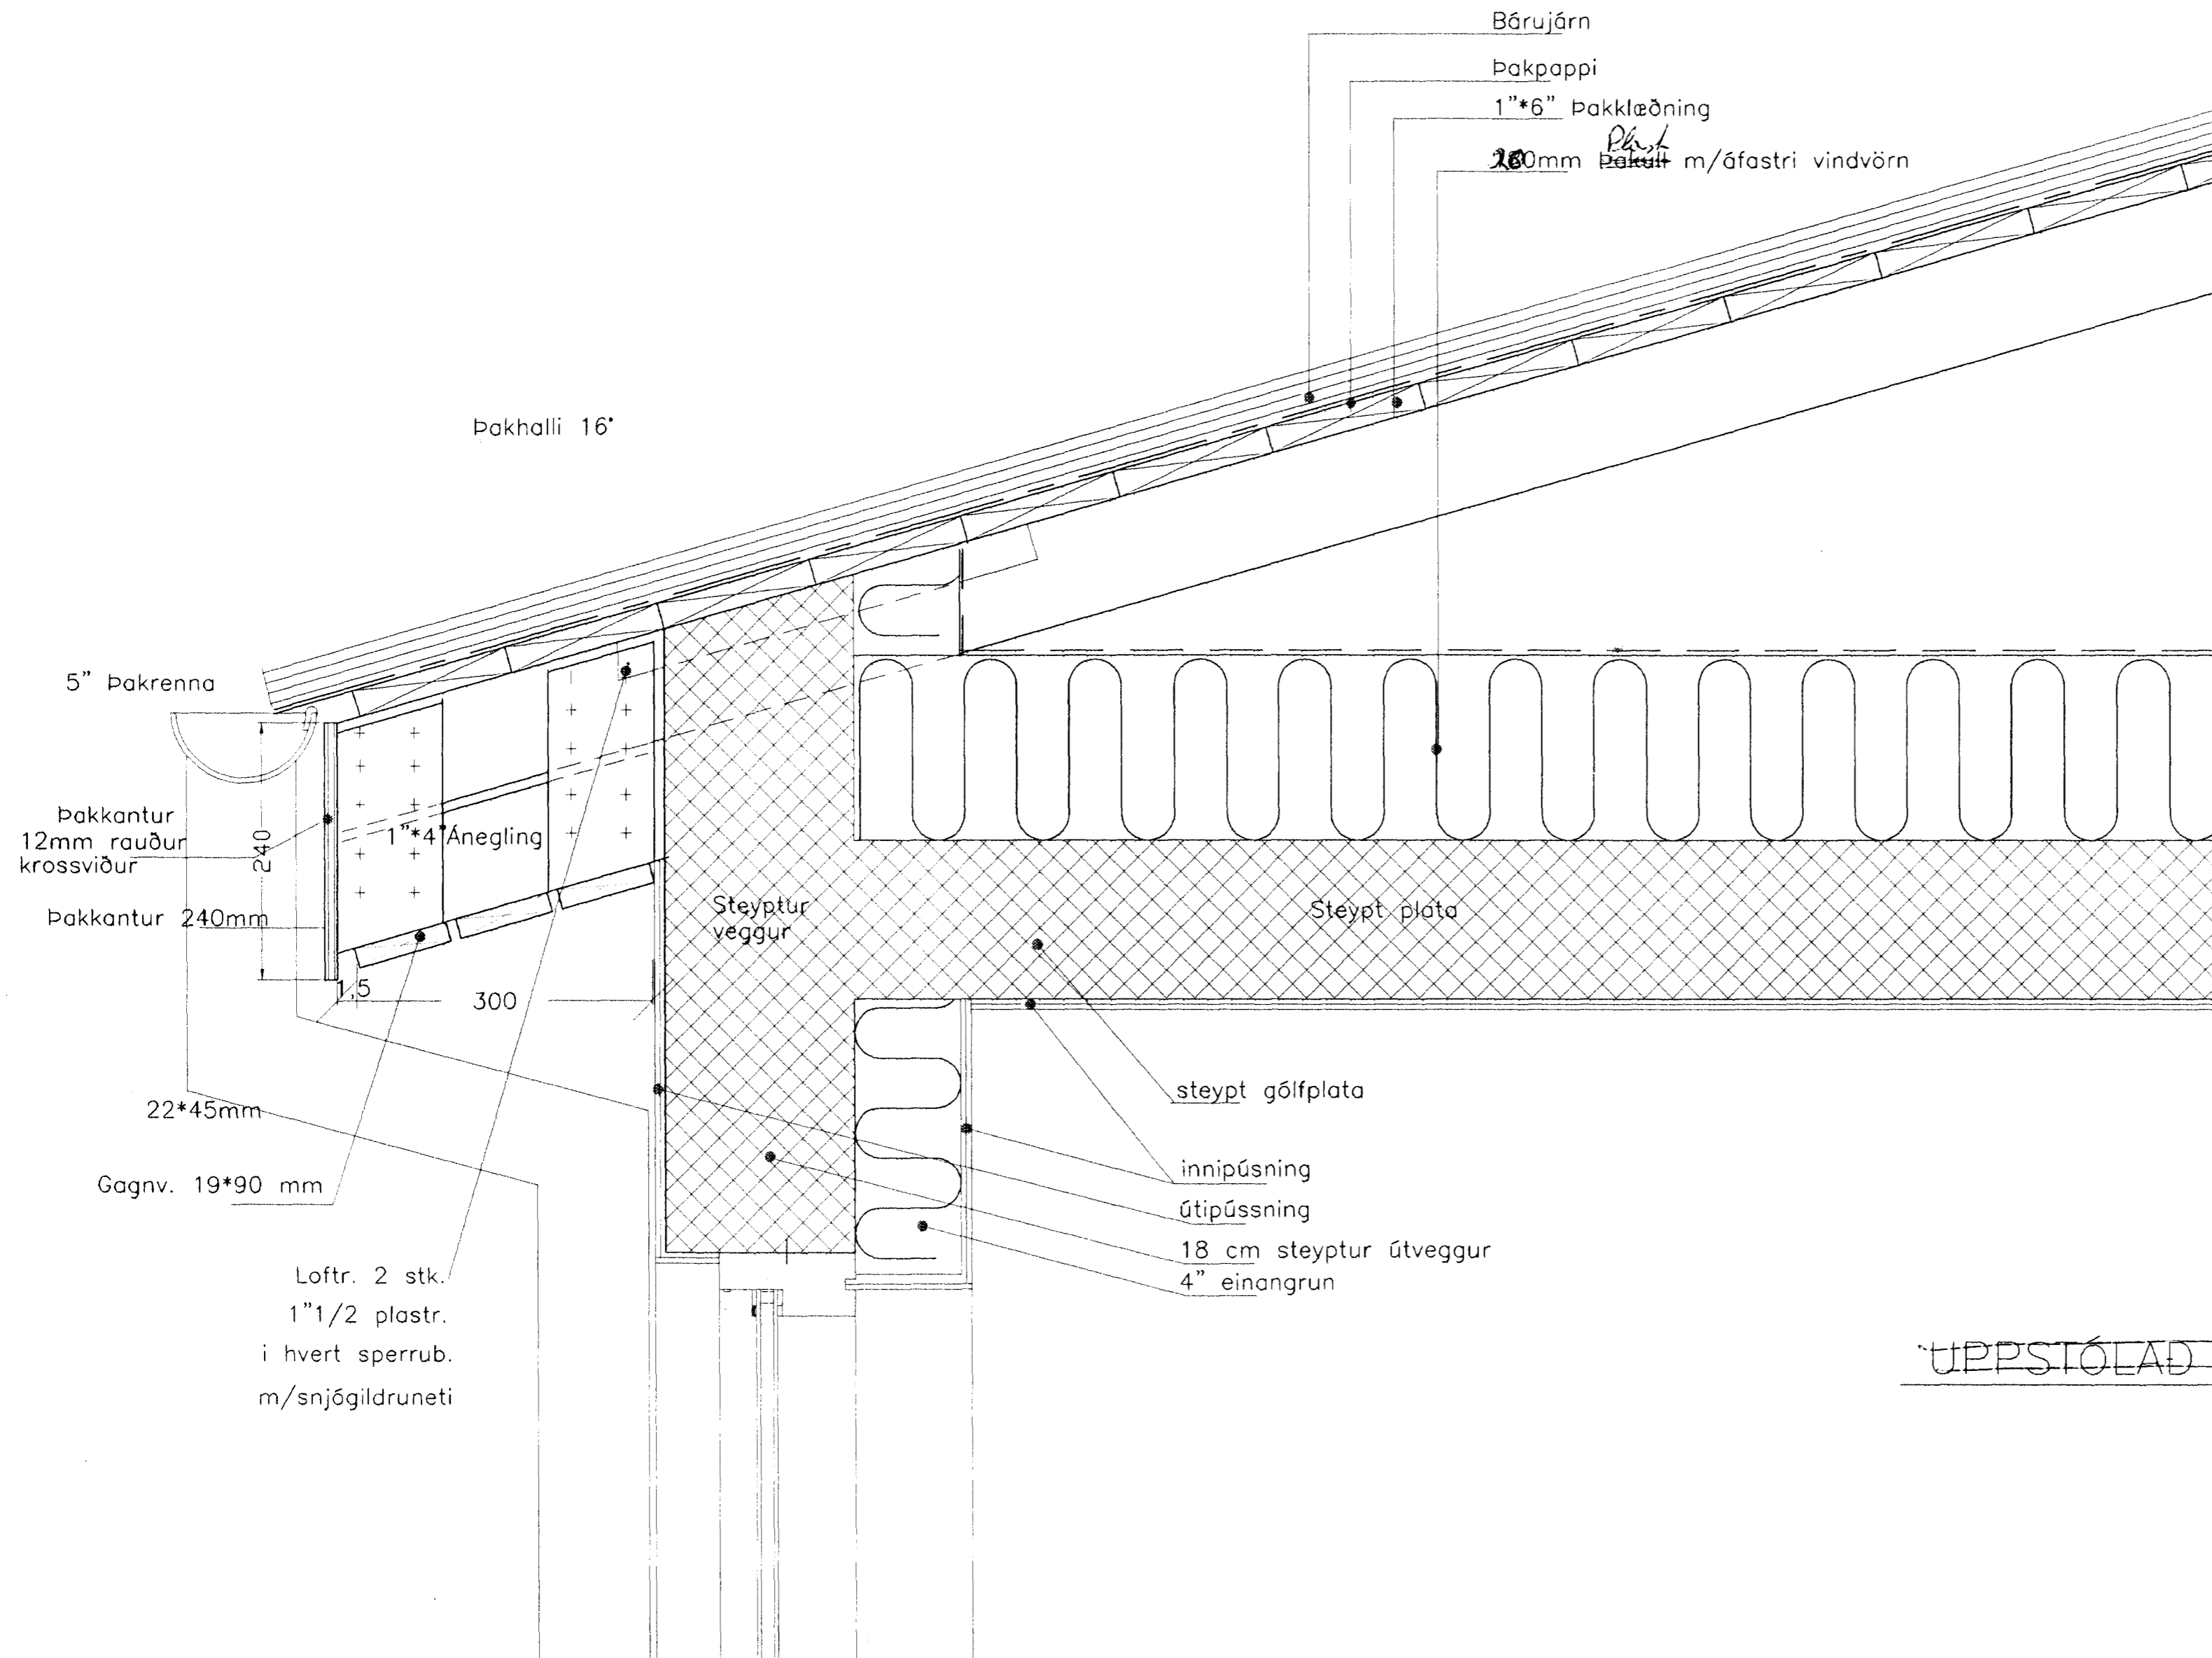

UPPSTÓLAÐ ÞAKKANTUR

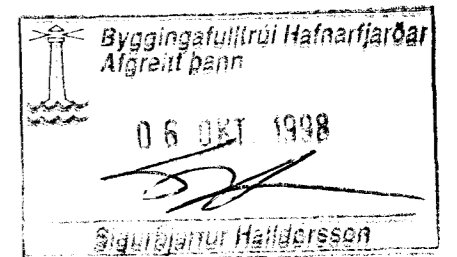

es

TEIKNISTOFAN Suðurlandsbraut 48 Sími 5887344 Fax 5887343

VERKHEITI. HÓLABRAUT NR 19

MÁL. 1:5

BLAD.

DAGS. 25.09 1998

BREYTT.

SIGURÐUR KJARTANSSON kt. 090246-2839