



GRUNNMÝND • 1:50

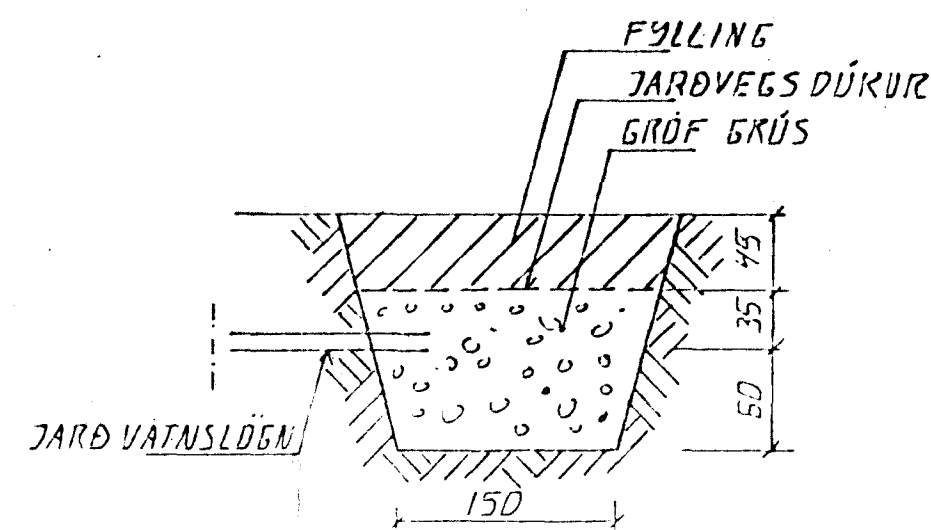

TÝPISKUR GRJÓTSVELGUR 1:20

ÁSKILID, ELDRI  
TEIKNING ÓGILD

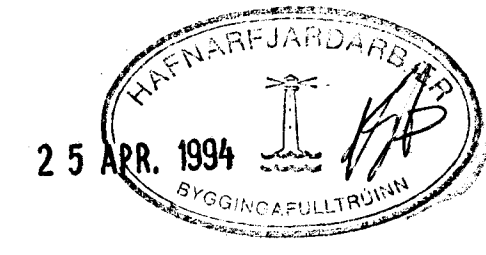

SKÝRINGAR

ALMENNA SKÝRINGAR SÁ BL.NR. 2-01.  
AFRAMLALD GRUNNLAGNA OG AFSTÖLL-  
MIND SÁ BL.NR. 2-02.

BR	DAGS	EDLI BR	SIGN.
2	APR 94	LEGA VAFJSL DFT	[Signature]
01	OKT 93	SEK LÖGULY FVRIK US HL	[Signature]

HÓLSHRAUN 7  
HAFNARFJARÐI

GRUNNMÝND - GRUNNLAGNA

MKV	1:50
DAGS	OKT '93
VERK NR	9335
TEIKN NR	2-02A
HANNAÐ	
TEIKNAD	
YFIRFARI	

**TEIKNIÐJÓNUSTA**  
**SIGURDAR ÞORLEIFSSONAR HF**