
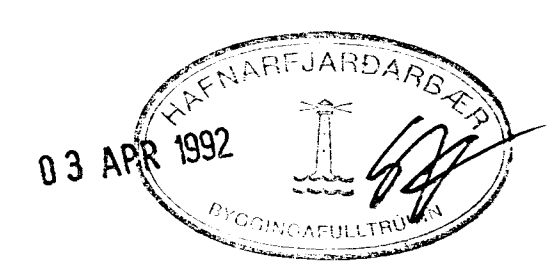


ÞUMMYND.

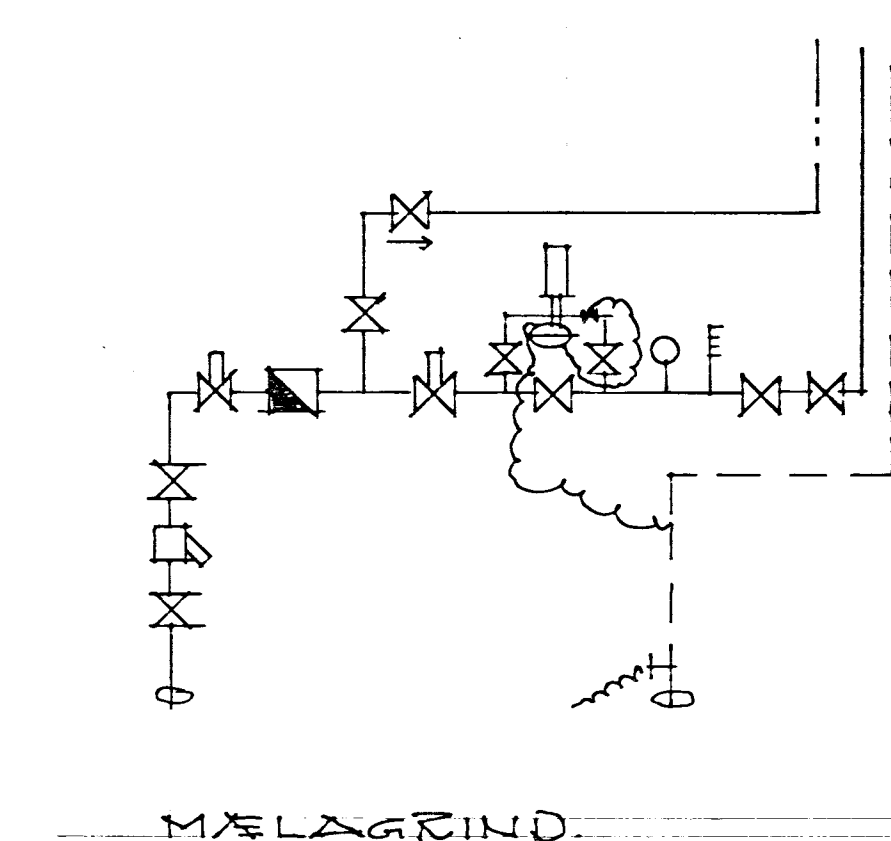

BREYTING	DAGS.	IGERT AF
HOEGSHOLT 17 LAFNARFIRÐI		
INGOLFUR ANTONSSON M. TFL.	VATHS OG HITALAGNIR	
BALDVIN EJARSSON M. Bf. I.	ÞUMMYND.	
teikn	yfir f.	bl. 2.
teikn	skamb	bl. 2.