





ÚTLIT AUSTUR MKV. 1:100

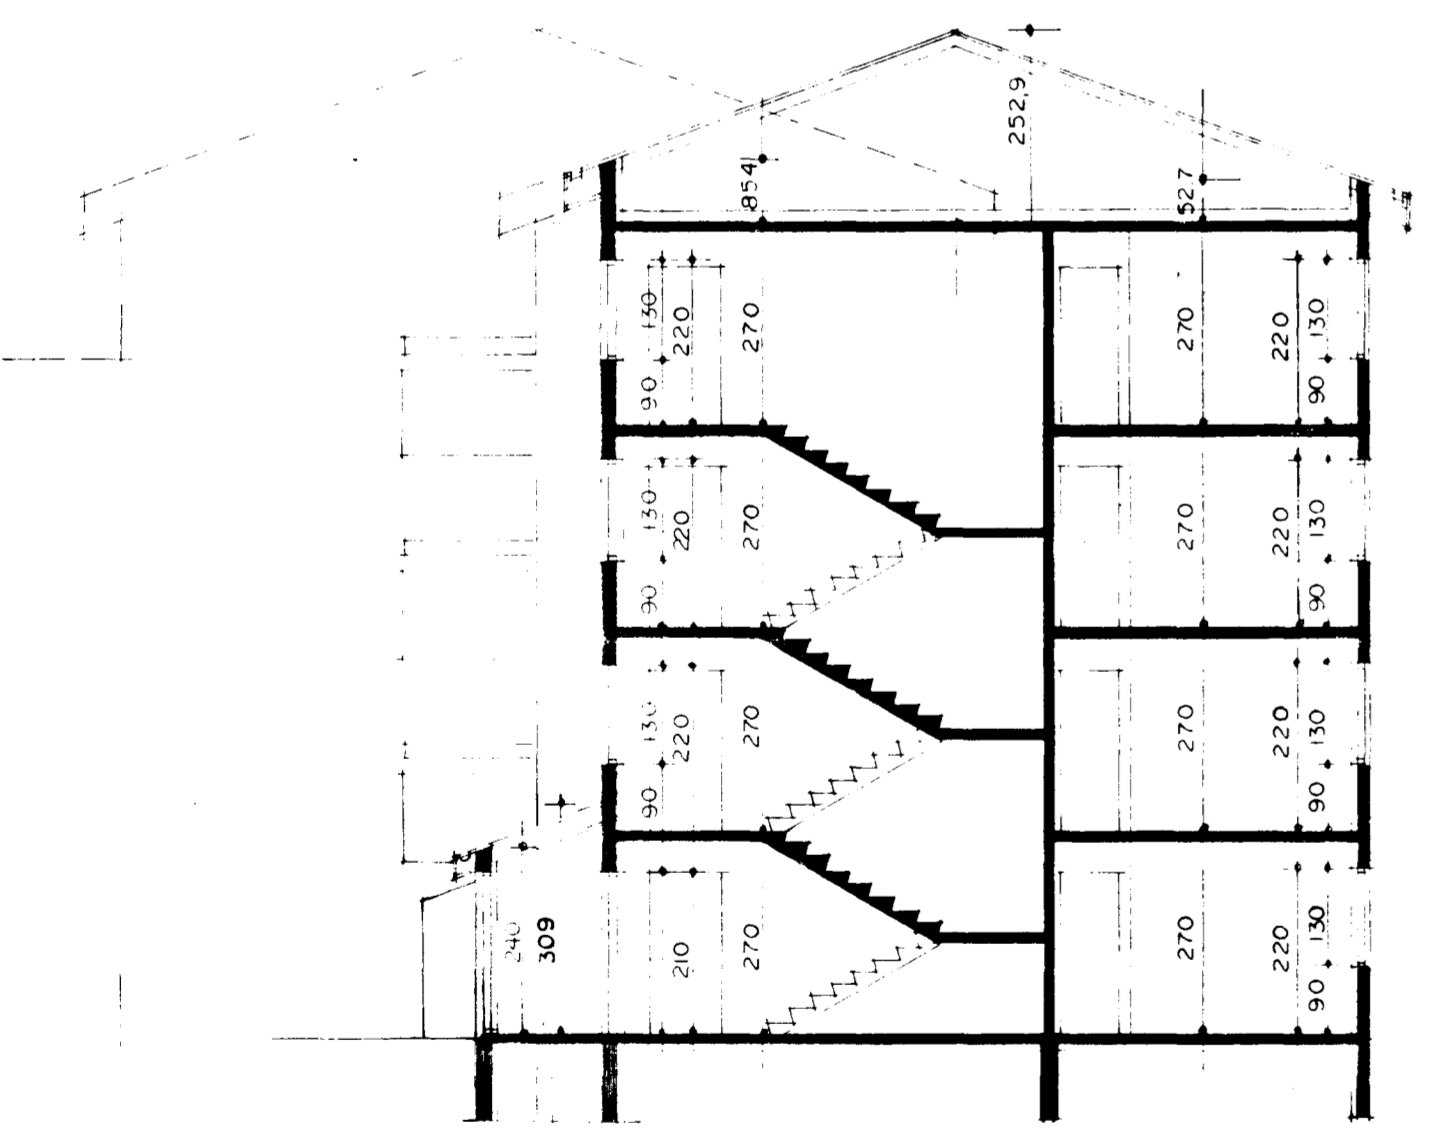

SNID B-B MKV. 1:100

40 87  
39 80

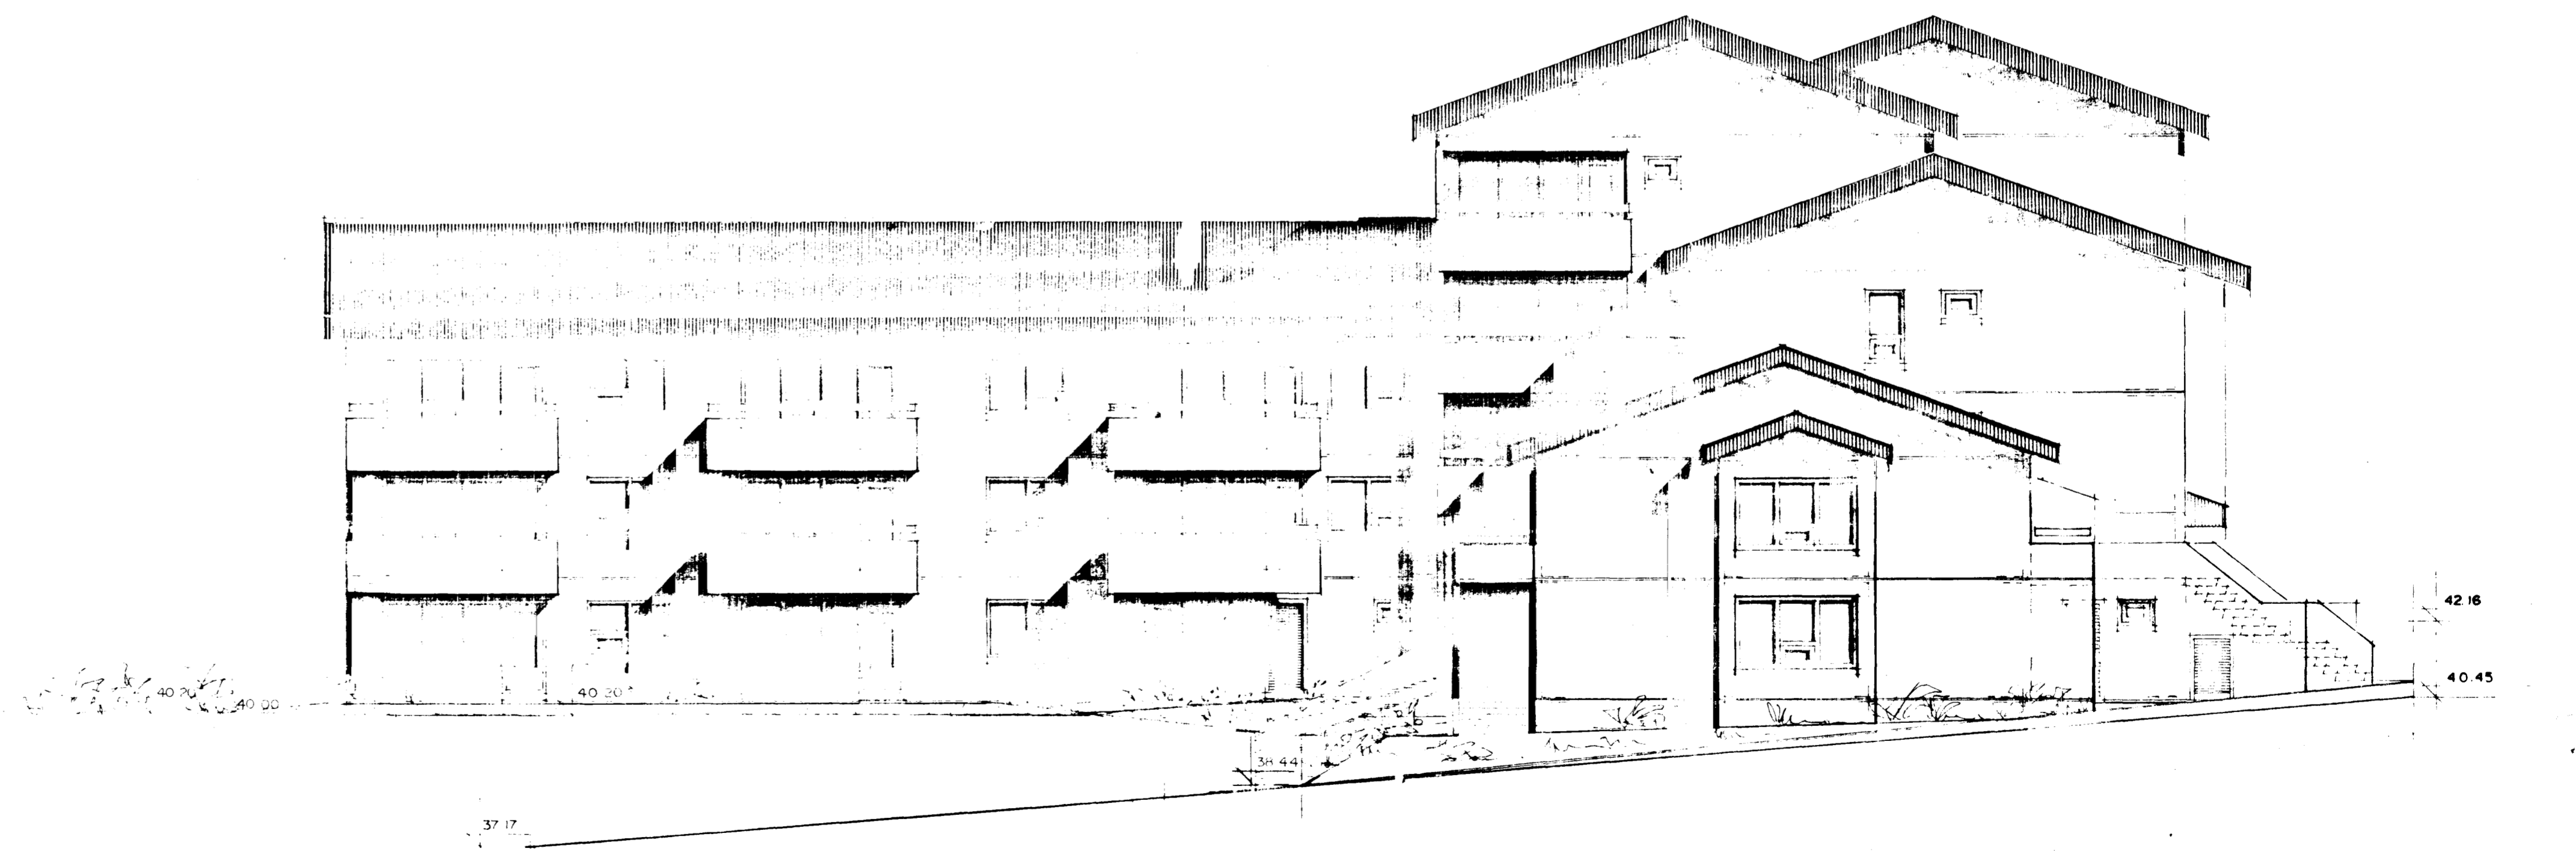

ÚTLIT SUÐUR MKV. 1:100

42 16  
40 45

23 BREYTT Í EBR. 1992  
SAMRÆMT BREYTTU LOKARBLAÐI Í FEB 91  
27 OG 29 BREYTT FEB 1991

H.25-31 NR.006

*Sigurki Hóll*