



CRUNNUMYND • 1 : 50



AFSTÖÐUMYND • 1 : 500

07 OCT 1991

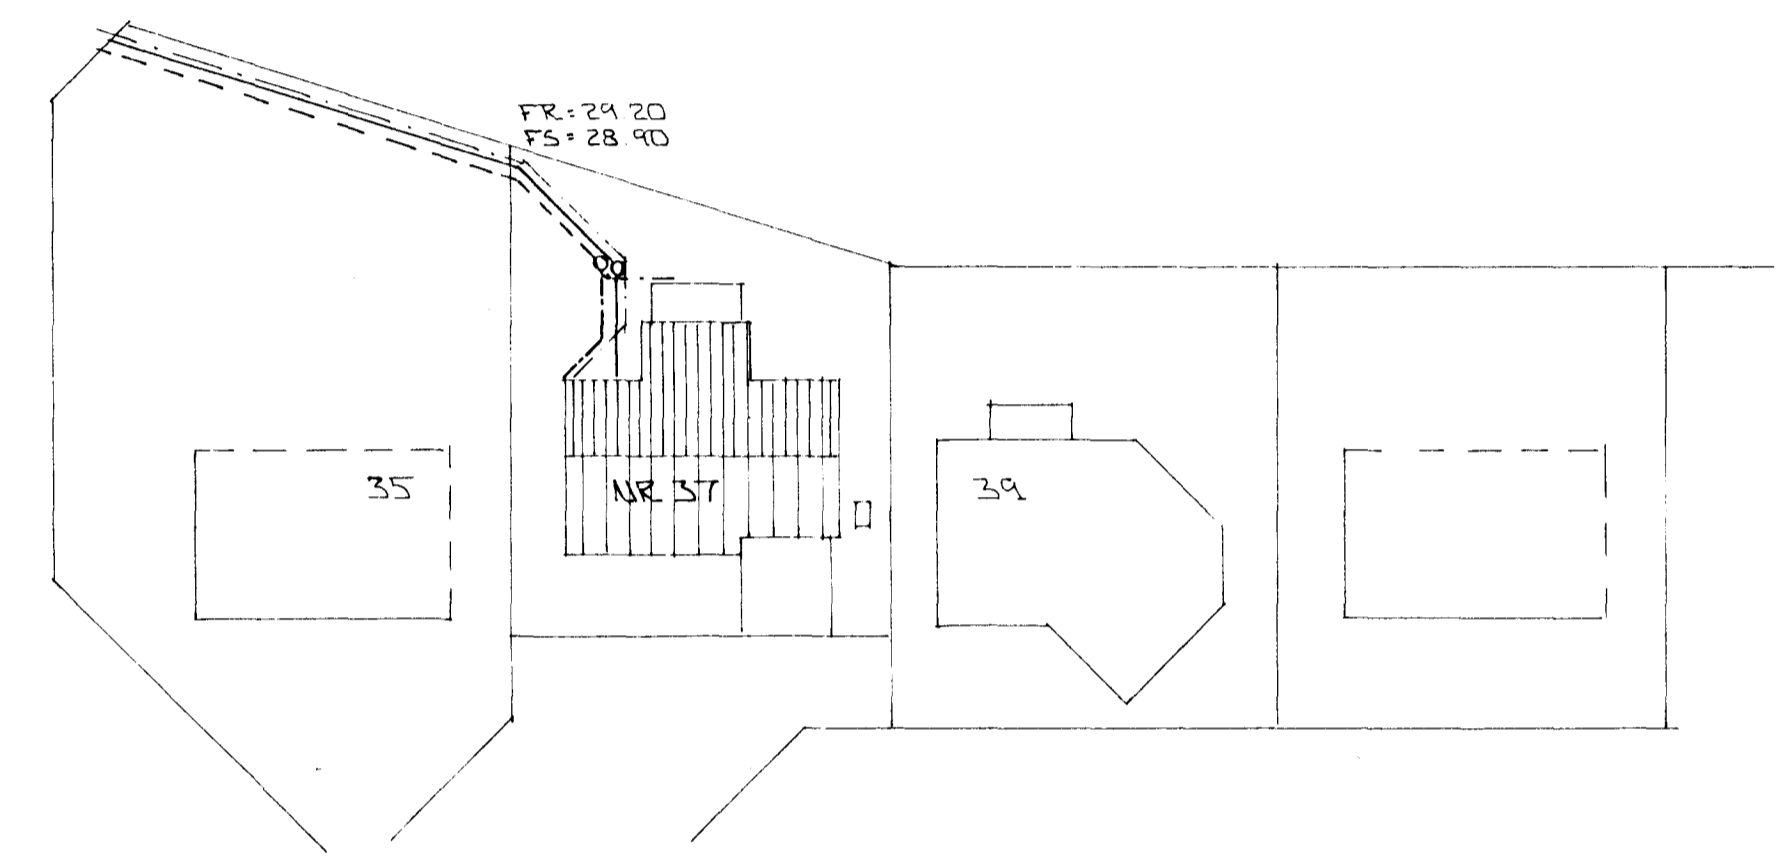

SKÝRINGAR

ALMENNAR SKÝRINGAR SÁ BL.NR. 2 - 01.

DS	29.08.91	JARÐVATNSLÖGN Breytt	GH
DZ	25.07.91	LEGU LAGNA Breytt	GH
DL	09.07.91	MEKINGUM BR. OG ÖÐRUM BÆTT VIÐ	GH
BR NR	DAGS	EDLI Breytingar	SIGN.
MÖRGSHOLT 37 HAFNARFJARDI			DAGS JÚLÍ '91
CRUNNUMYND - CRUNNLAGNA			HANJAR
AFSTÖÐUMYND			TEKNAÐGH
MELIKV. • L : 50 • L : 500			VERK NR
SIGURÐUR ÞORLEIFSSON TEKNIFRÆÐINGUR F.T.F.I.			9136
STRANDGÖTU 11 HAFNARFJARDI SÍMI 54751/54255			BLAD NR
			2 - 02