


RÚMMYND HITALAGNA 1:50

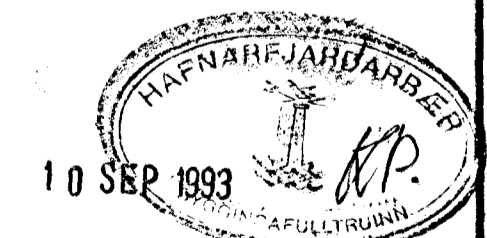

BR.NR.	DAGS	EDLI	BREYTINGAR	SIGN.
1	SEPT.93	BR. EINS OG LACT		29
<b>HÖRGSHOLT 3 HAFNARFREDI</b> RÚMMYND - HITALAGNA				DAGS NOV '91 HANNAÐ <i>cl</i> TEIKNAD VERK NR 9146
MELKV. & L: 50 <b>SIGURÐUR ÞORLEIFSSON</b> TEIKNIFREÐINGUR F.T.F.I.				BLADNR 2-05
STRANDGÖTU 11 HAFNARFREDI SIMI 54751/54255				