


GRUNNMYND 1:50

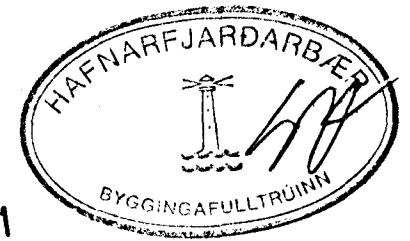

03 OCT 1991

SKÝRINGAR

ALMEINAR SKÝRINGAR SÁ BL.NR. 2-01

01	1.10.91	OFNUR 109 FÆRÐUR BR I HAUSKI OFN	67
BR.NR.	DAGS	EDLI BREVINGAR	SIGN.
HÖRGSHOLT 9 HAFNARFIRÐI			DAGS ÁGUSTI 91
HITA -VATNS OG FRÆDELNSLISLAGUR			HANNA
MÆLIKV. A L : 50			TEIKNAR
SIGURÐUR ÞORLEIFSSON TEKNIFRÆÐINGUR F.T.F.I.			VERK NR. 9120
STRANDGÖTU 11 HAFNARFIRÐI SÍMI 54751/54255			BLAD NR. 2-03