
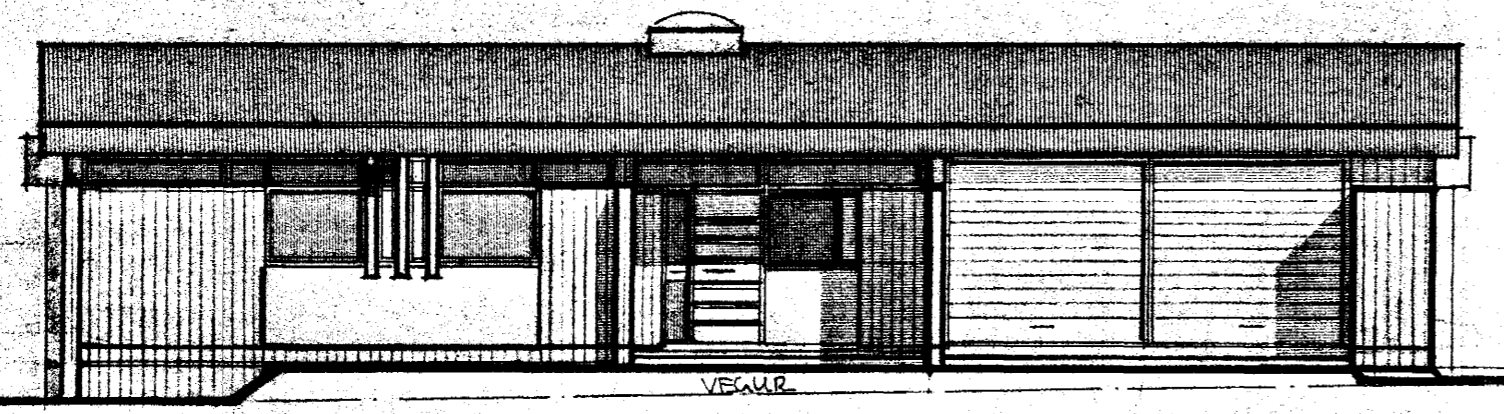
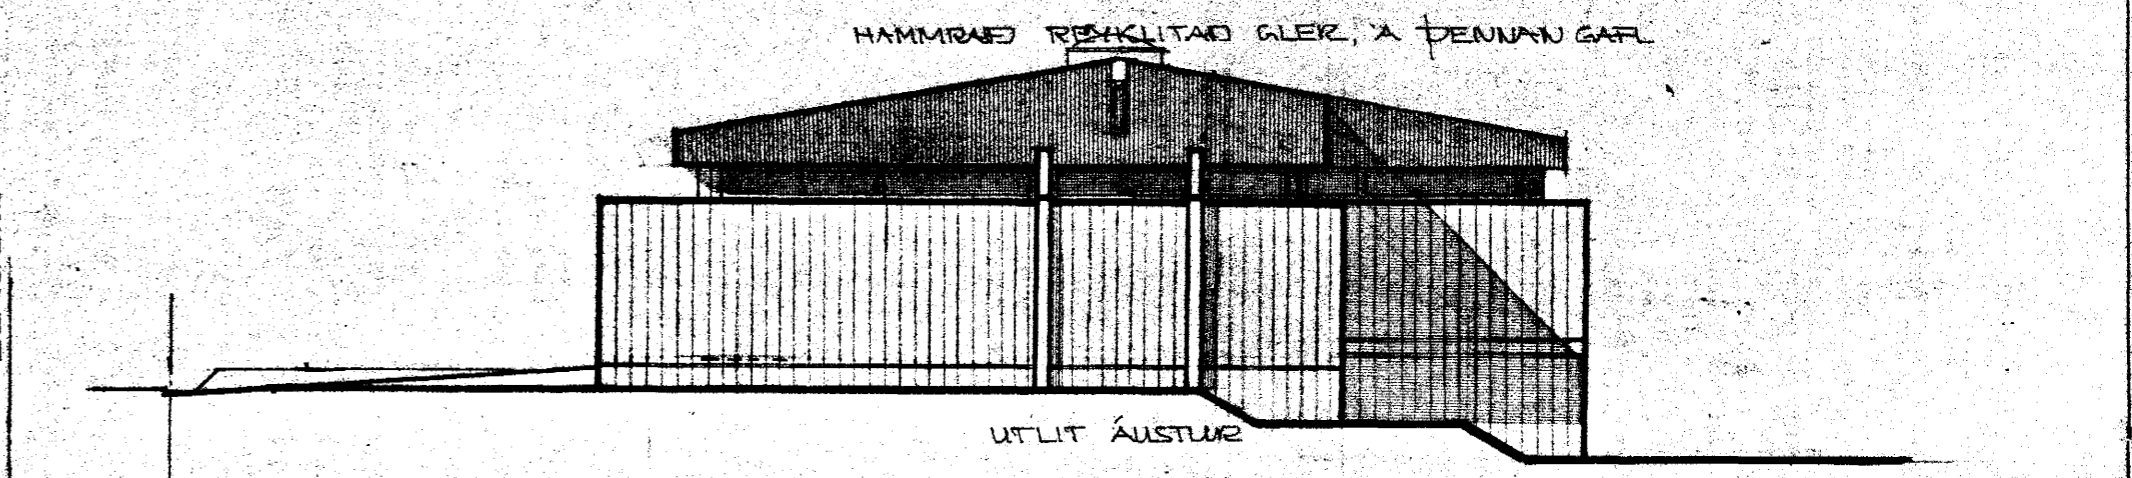
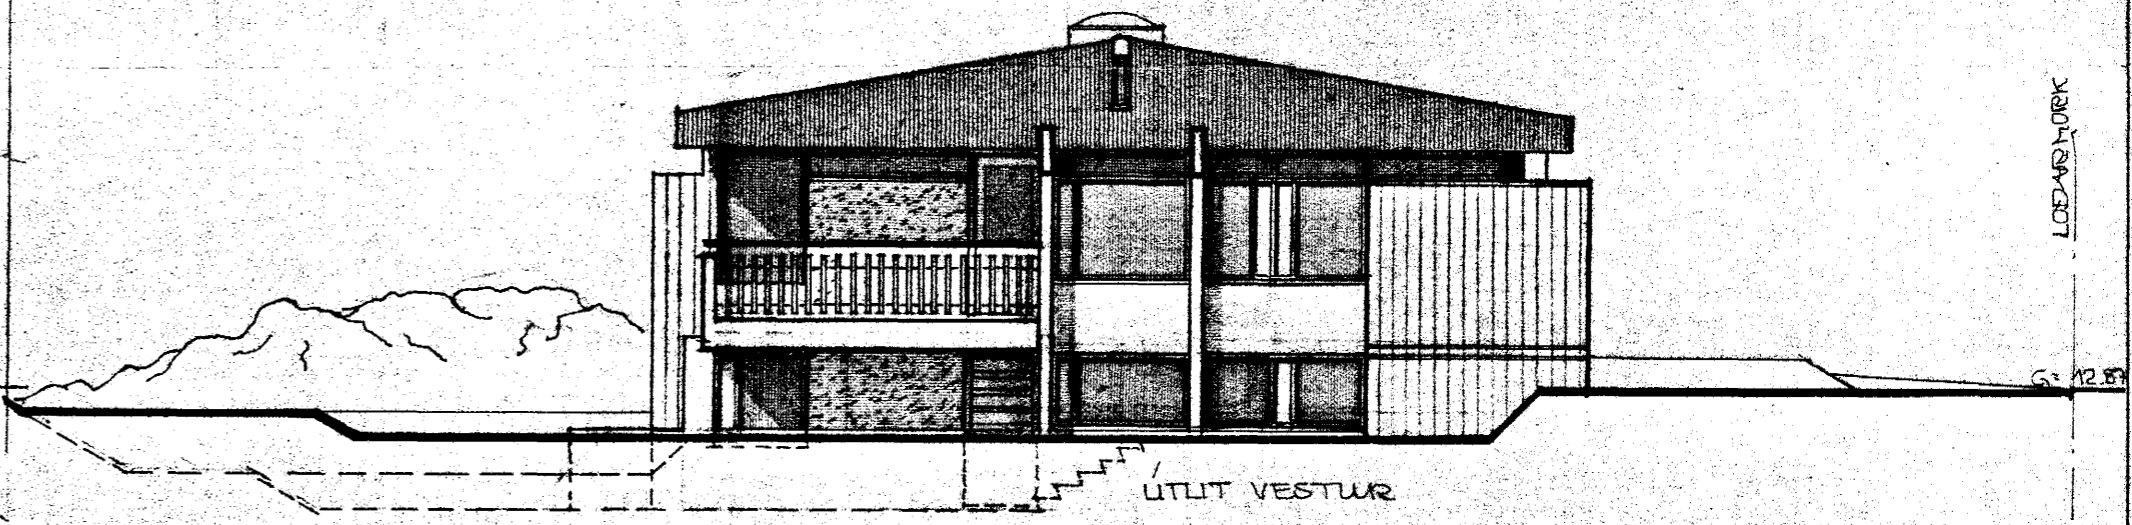
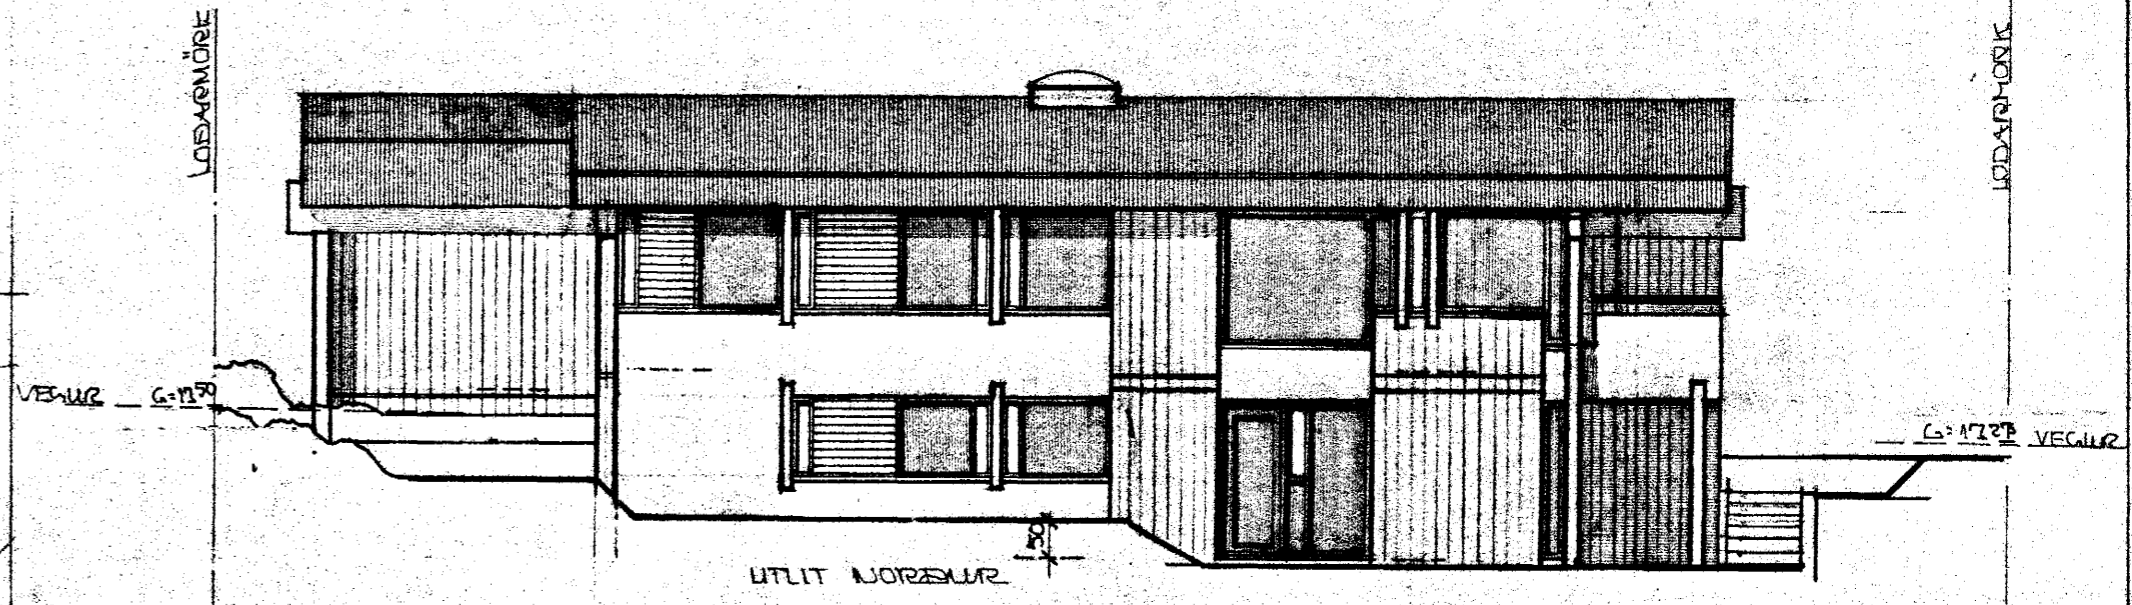


Samþykkt á fundi bygginga-
nefndar þ. 19/4 1978
BYGGINGAFULLTRÚGIN
Í HAFNARFIRDI
[Signature]

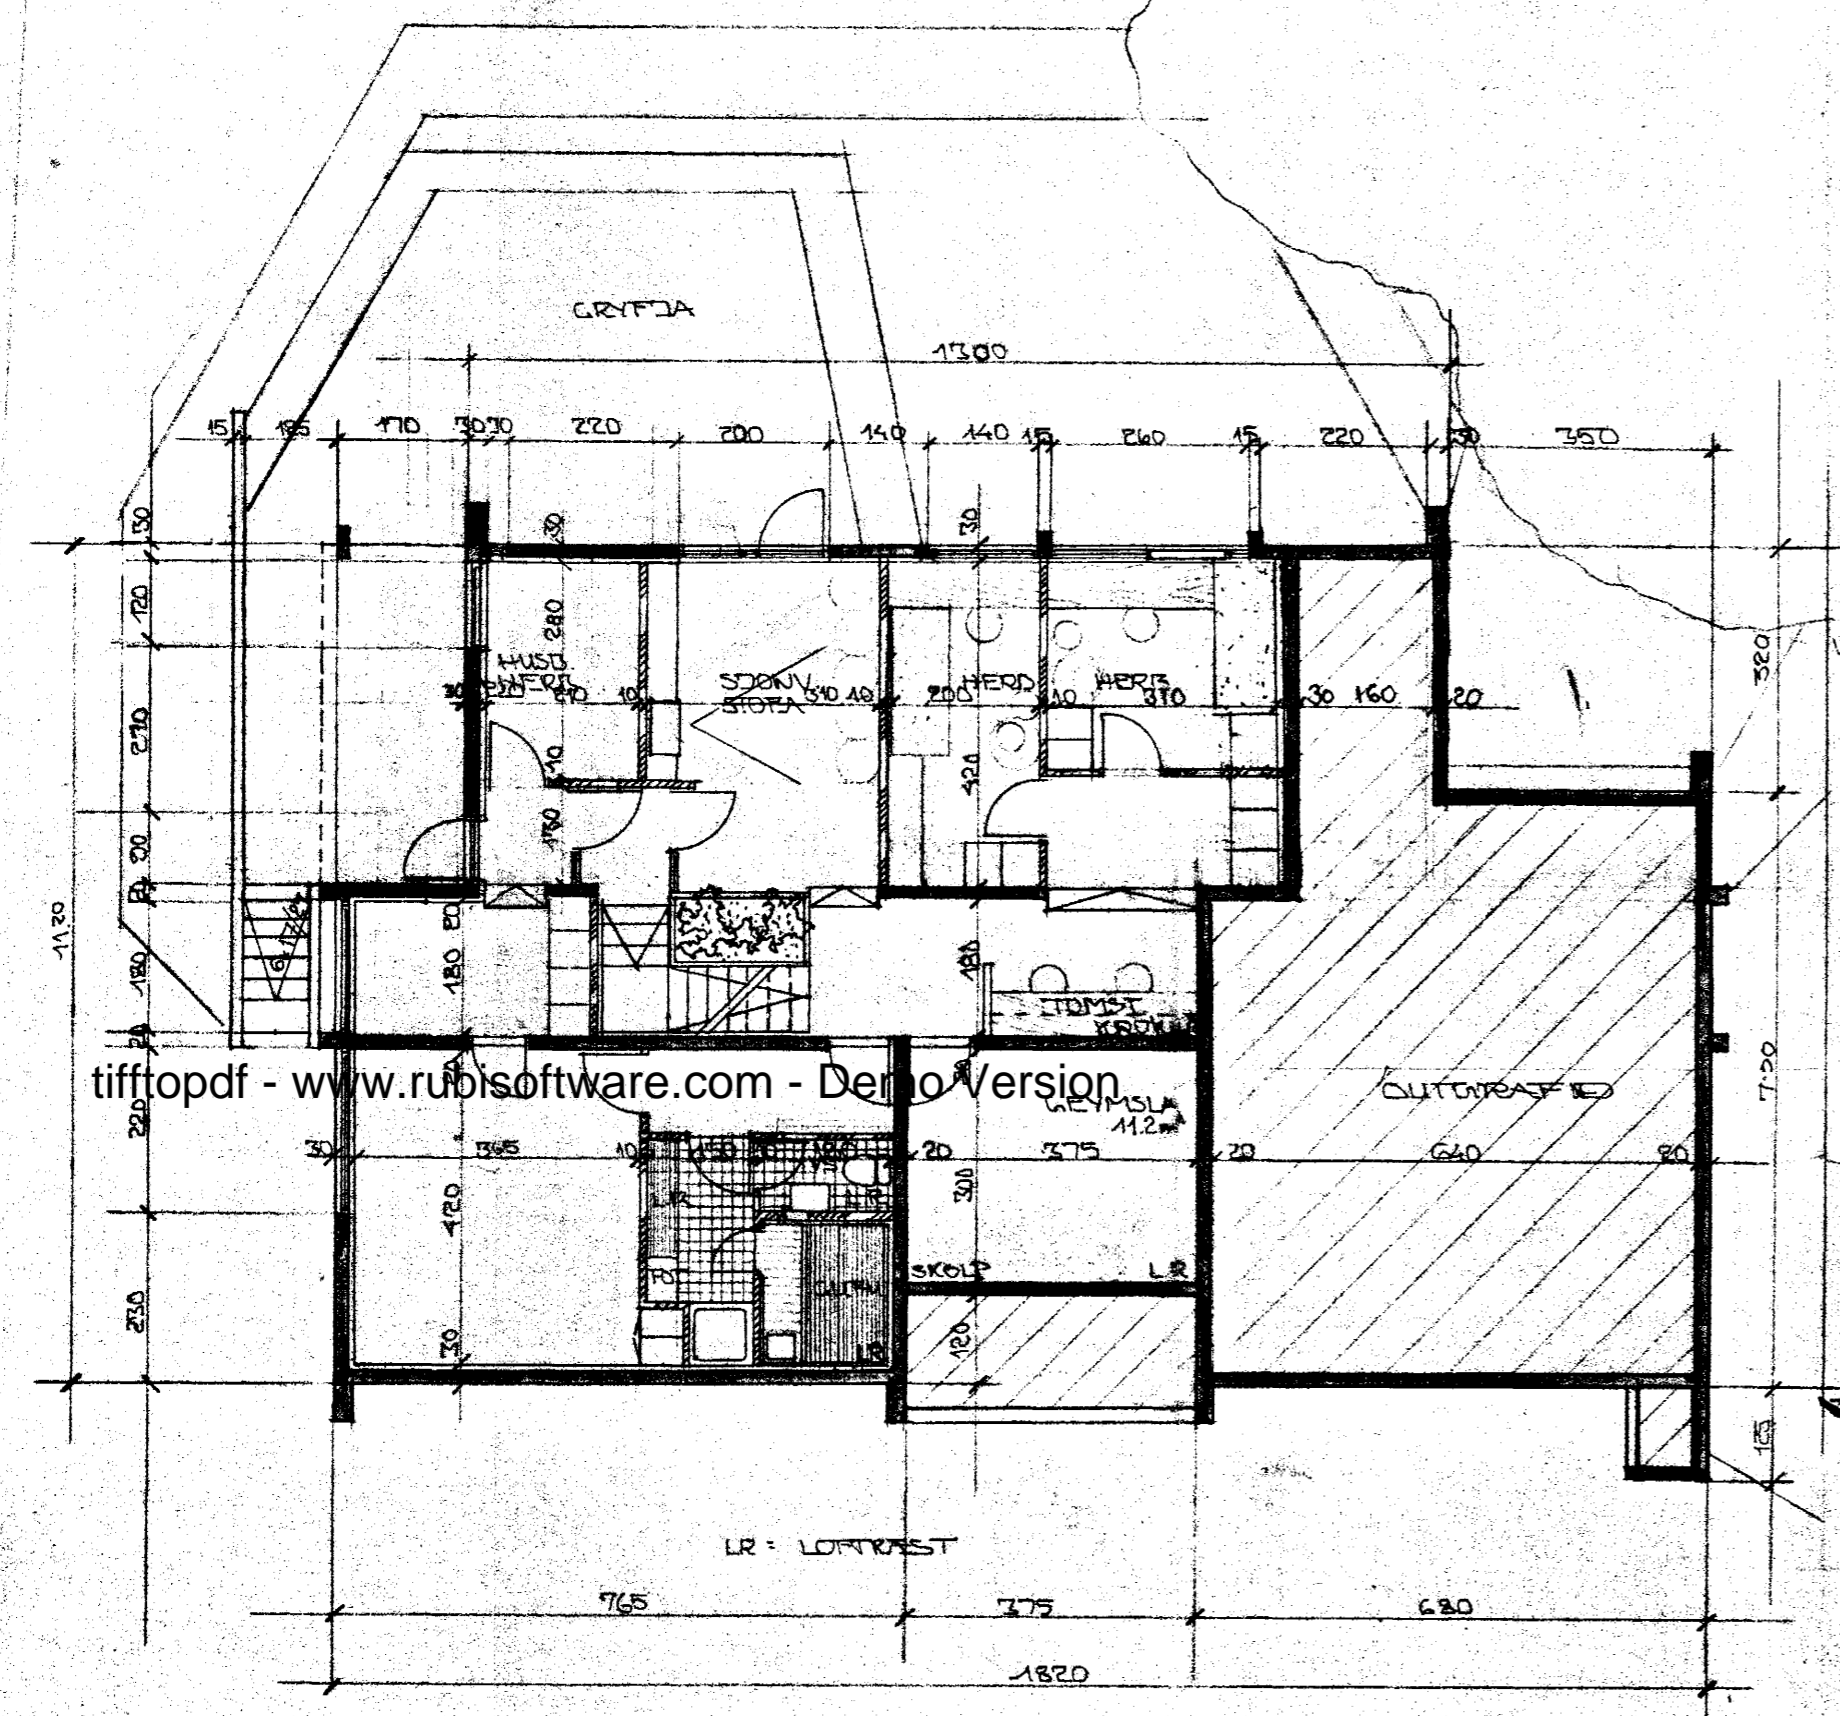

MAI 76 DREYTT MAI 76 AVO MELLI KVARESI -1:50	HRAUNBRUN 19 KJALLARI ÚTLIT	TEIKN NR 102
DREYTT APRIL 78 AVO	HÖNNUN A VIEÐAR OLSEN TÆKURFR TPI <i>[Signature]</i>	VERK NR