
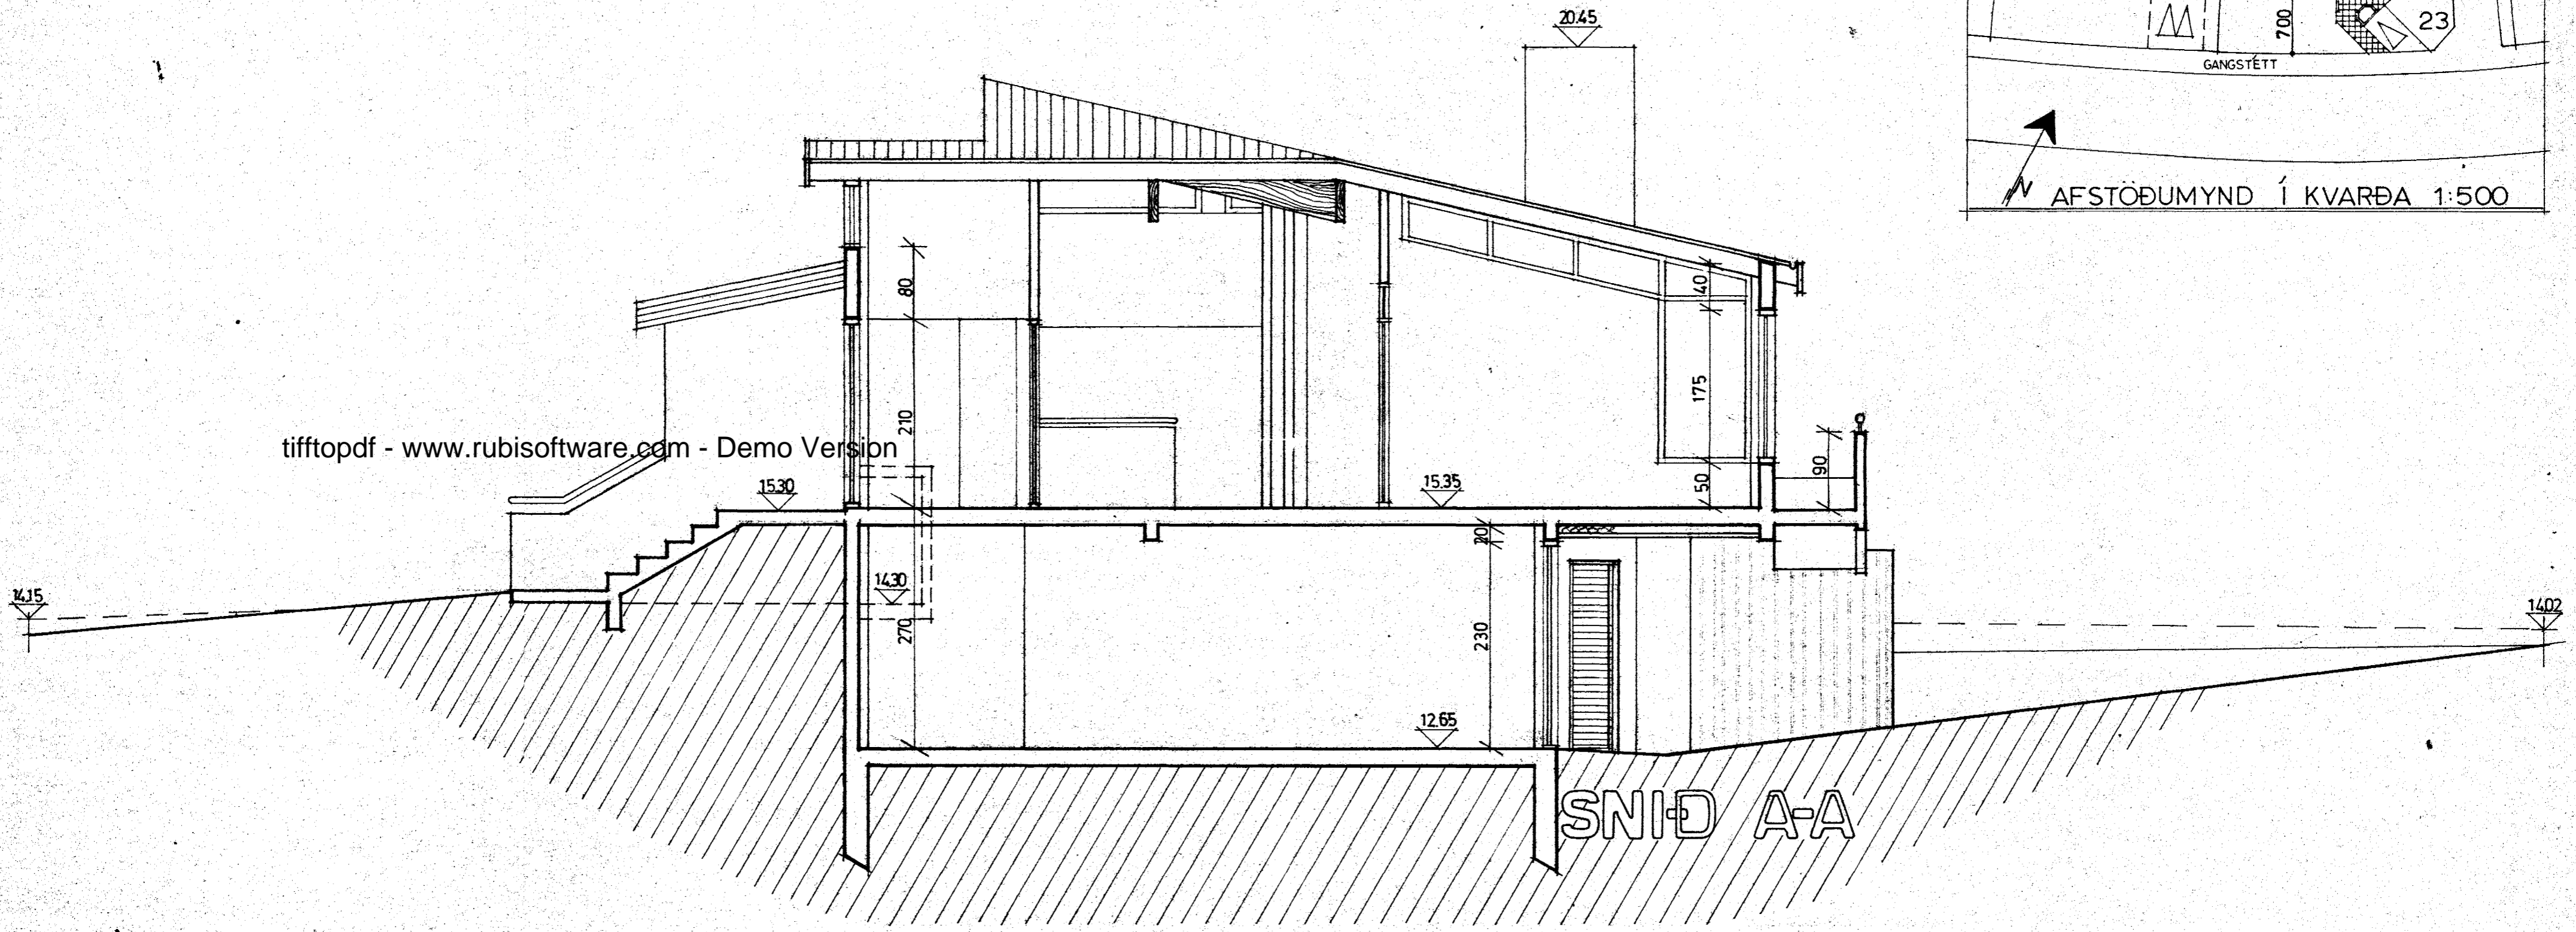


Samþykkt á fundi bygginga-
nefndar þ. 29.6.1977
BYGGINGAFULLTRÚINN
29. HAFNARFIRDI

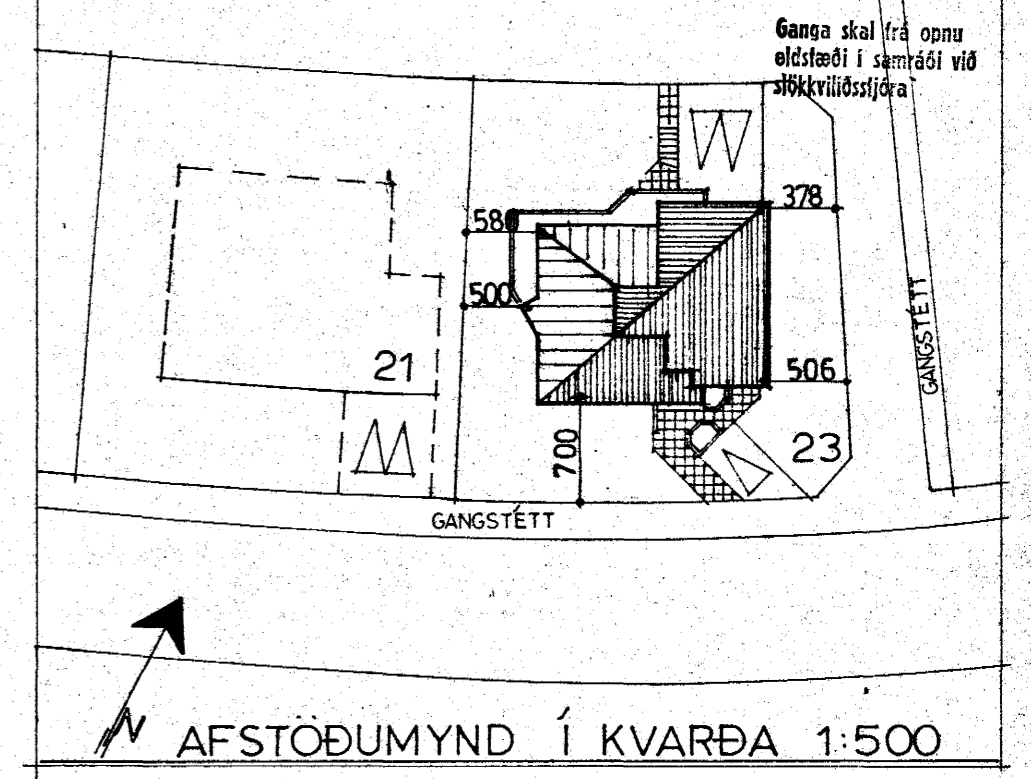

tifftopdf - www.rubissoftware.com - Demo Version

Hraunbrún 23, Hf.	KVARÐI : 1:50 DAGS : 27.6.77 VERKNR : TEKNNR :
sneiðing A-A	LIÑIÐ : einar/lára BR JÚN.77
	TEKNIÐ SF ARKITEKTASTOFA FELLSMULA 26 105 R. S.82022