

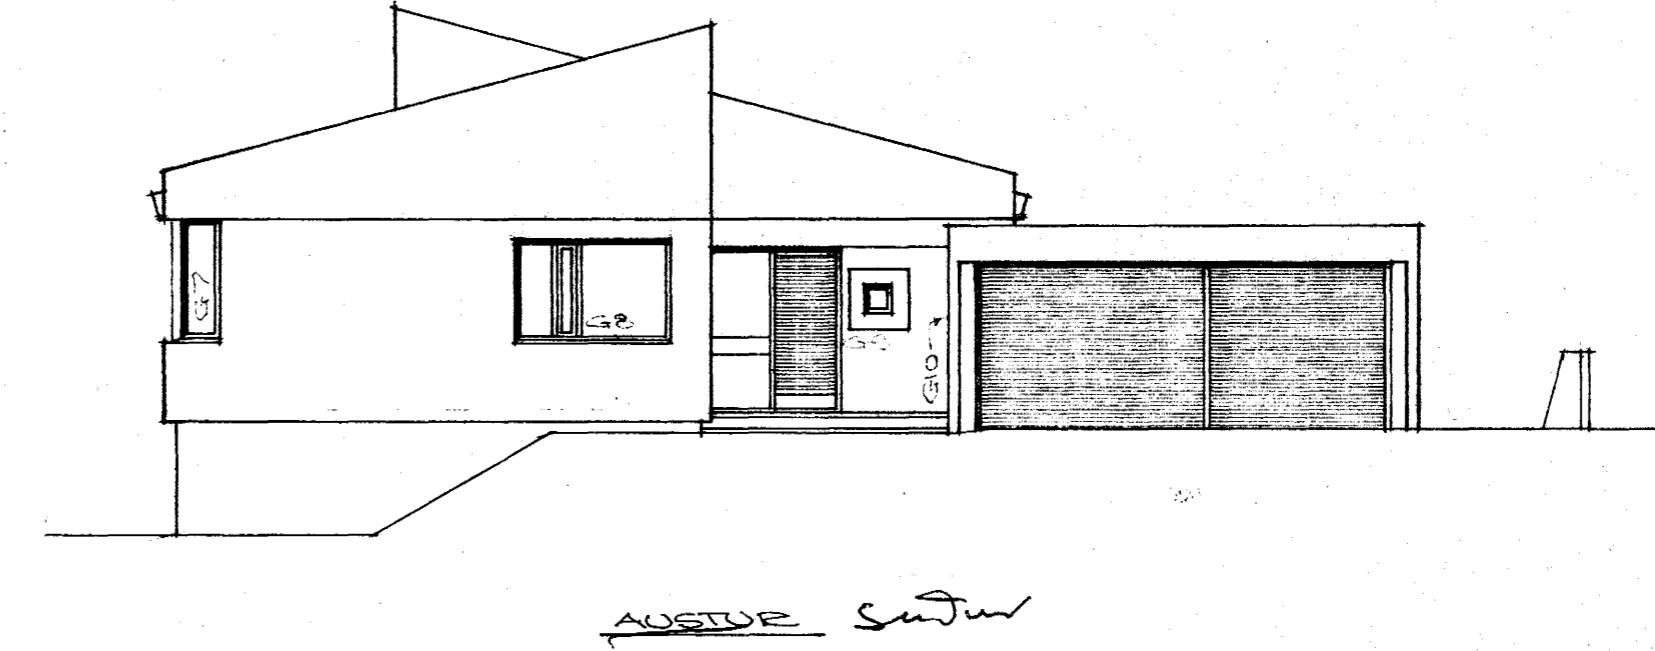
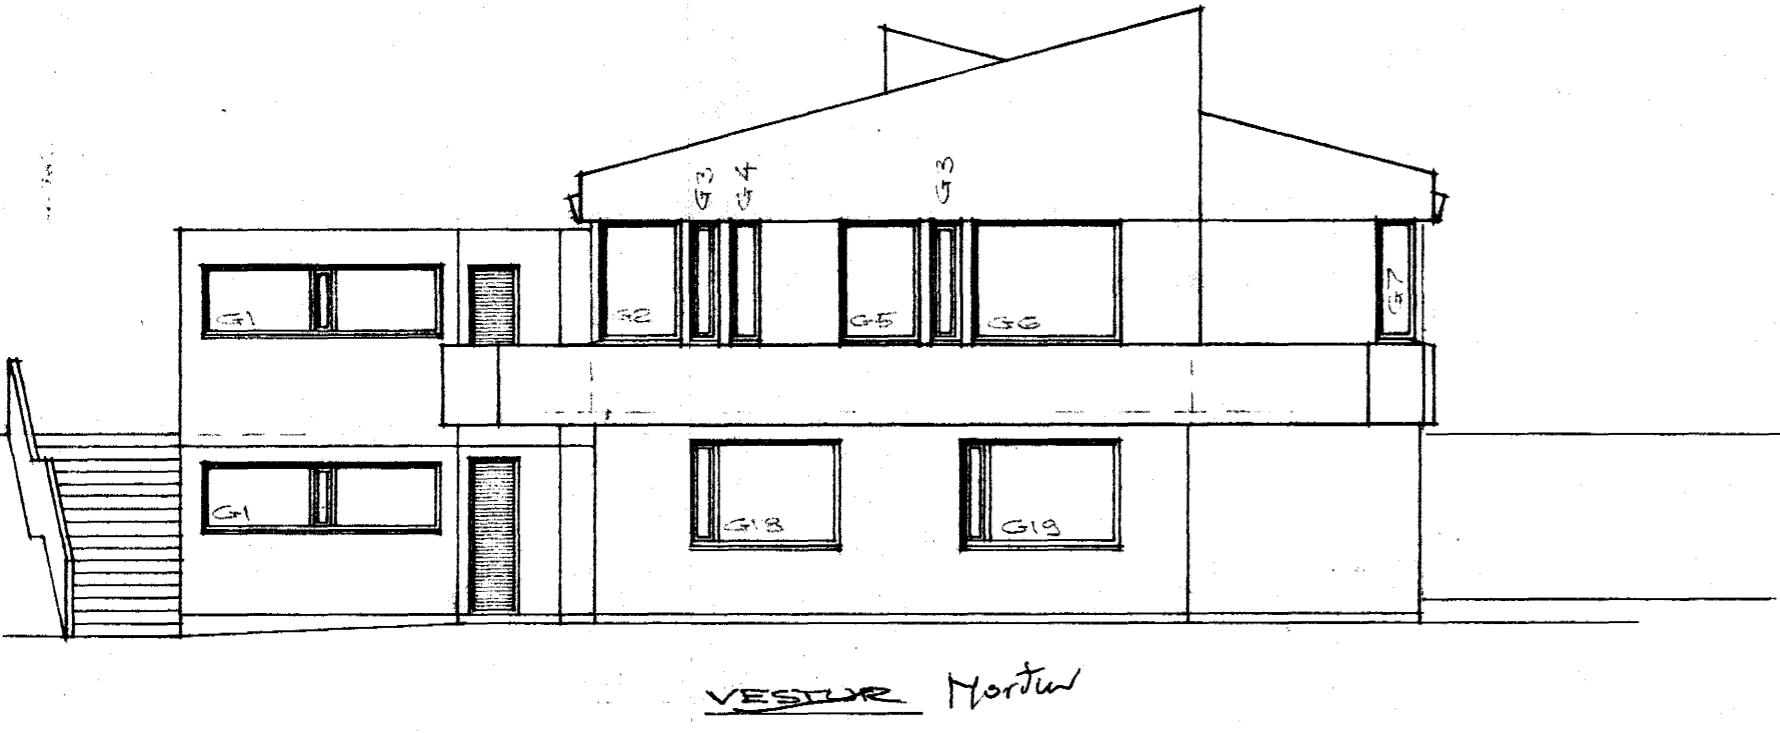


Samþykkt á fundi bygginga-
 nefndar þ. 1416 1978
 BYGGINGAFULLTRÚINN
 Í HAFNARFIRDI
 S. Garðsson

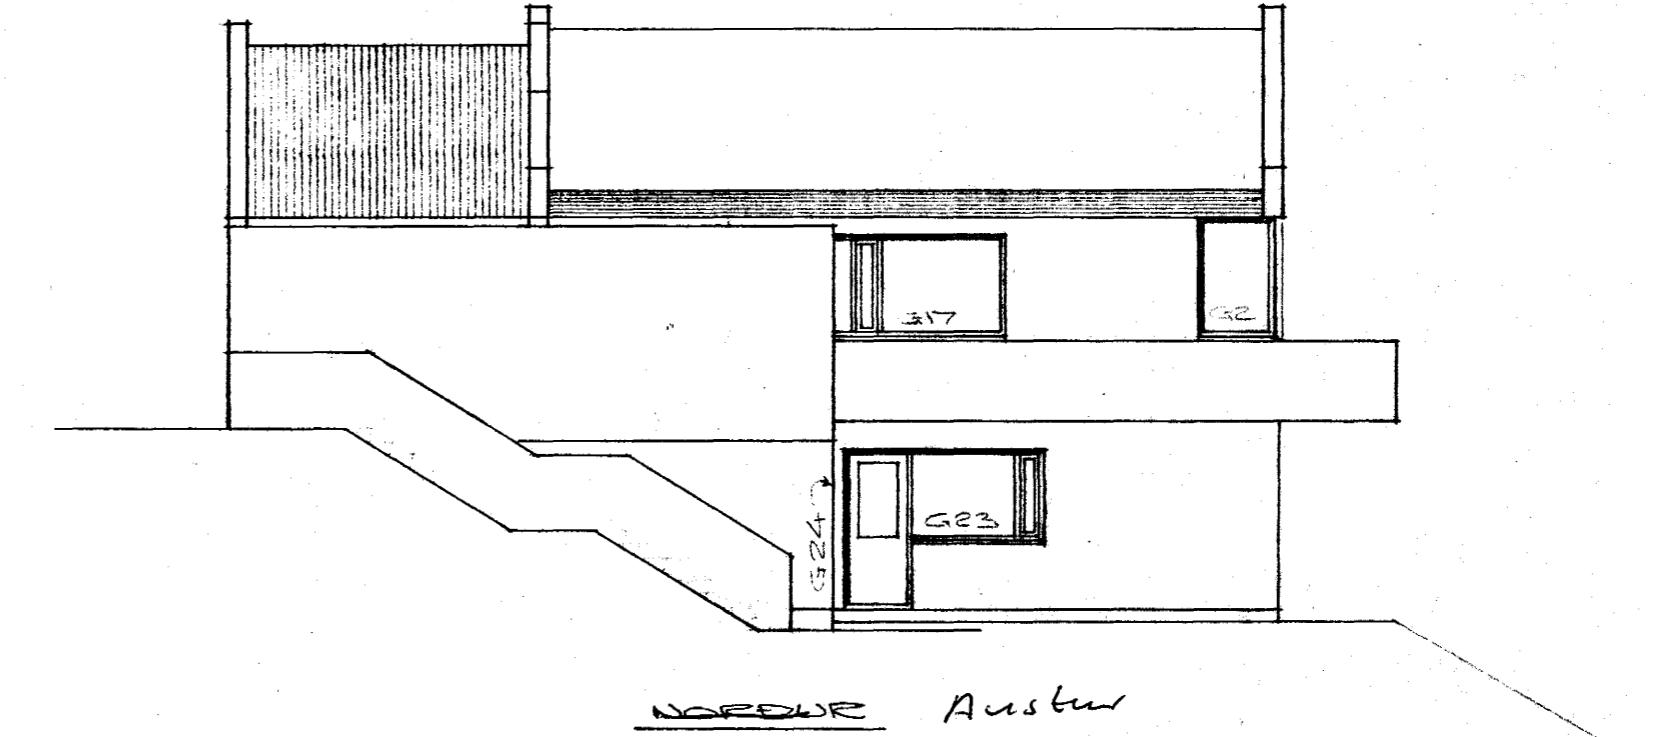

tifftopdf - www.rubissoftware.com - Demo Version

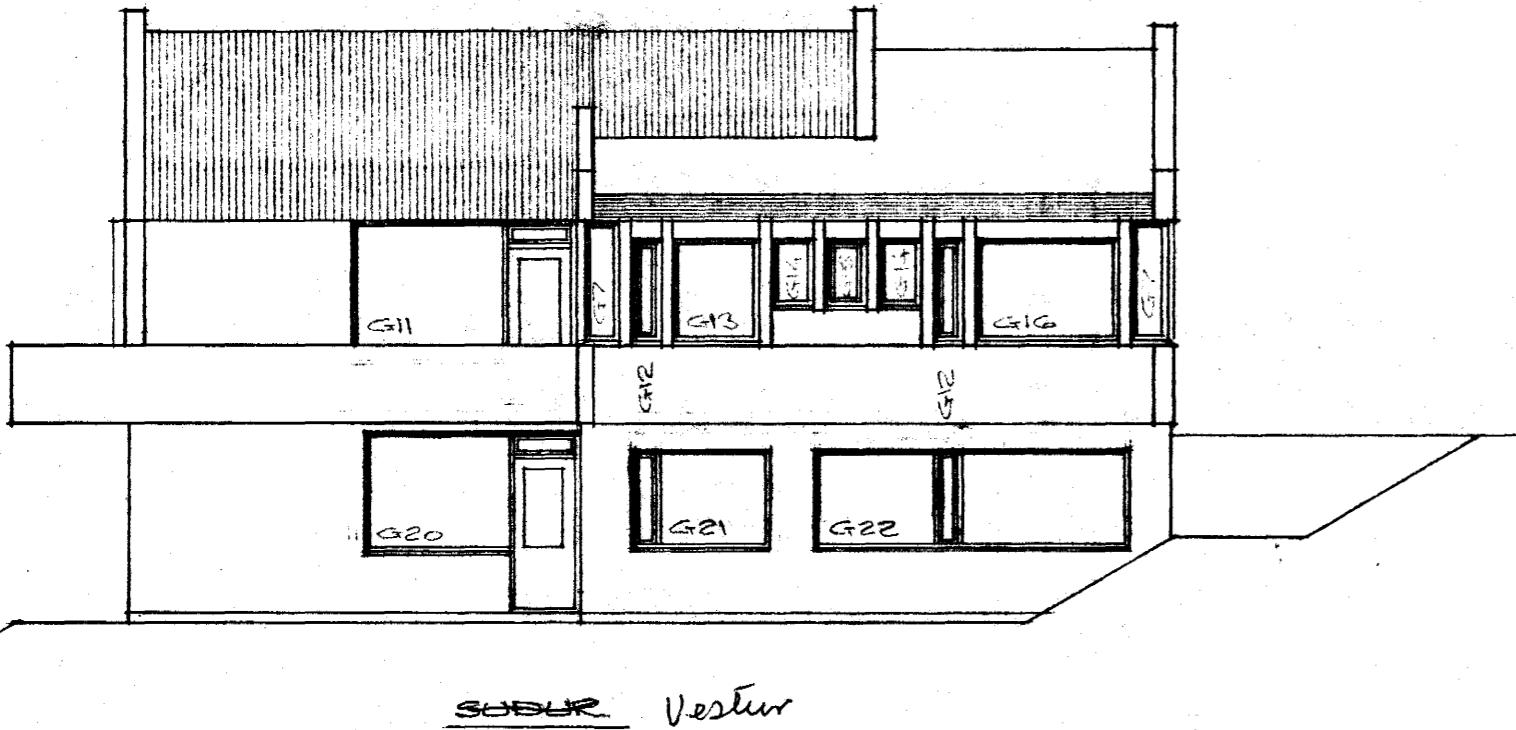

HRAUNBRODUR NR. 25 . M=1:100
 HAFNARFIRDI 1 SEPTEMBER 1977
 ARVARCHRAUNDI 47 60587

Aegar Magnússon FVF