

Hús Linnubrunn 2.





Björgvins Sveinssonar
og

Gretars Pálssonar

Ónefndgata

Jfr
19/9'58

Húsaom.
Múvaram.

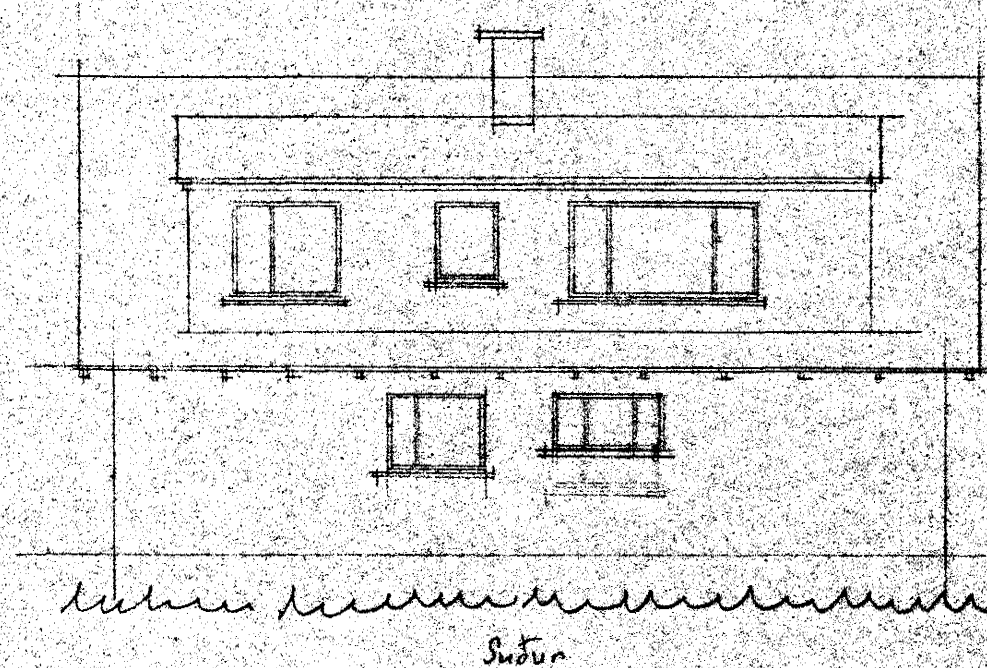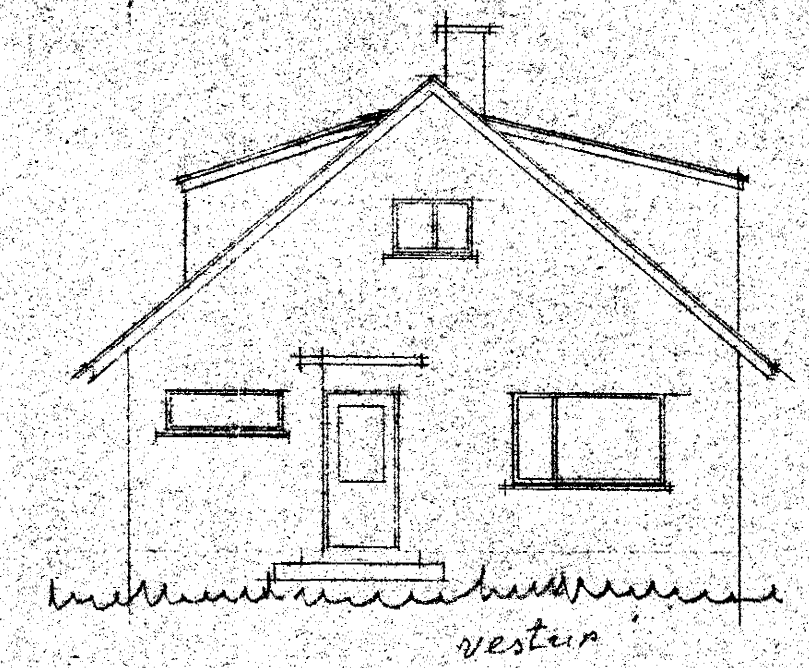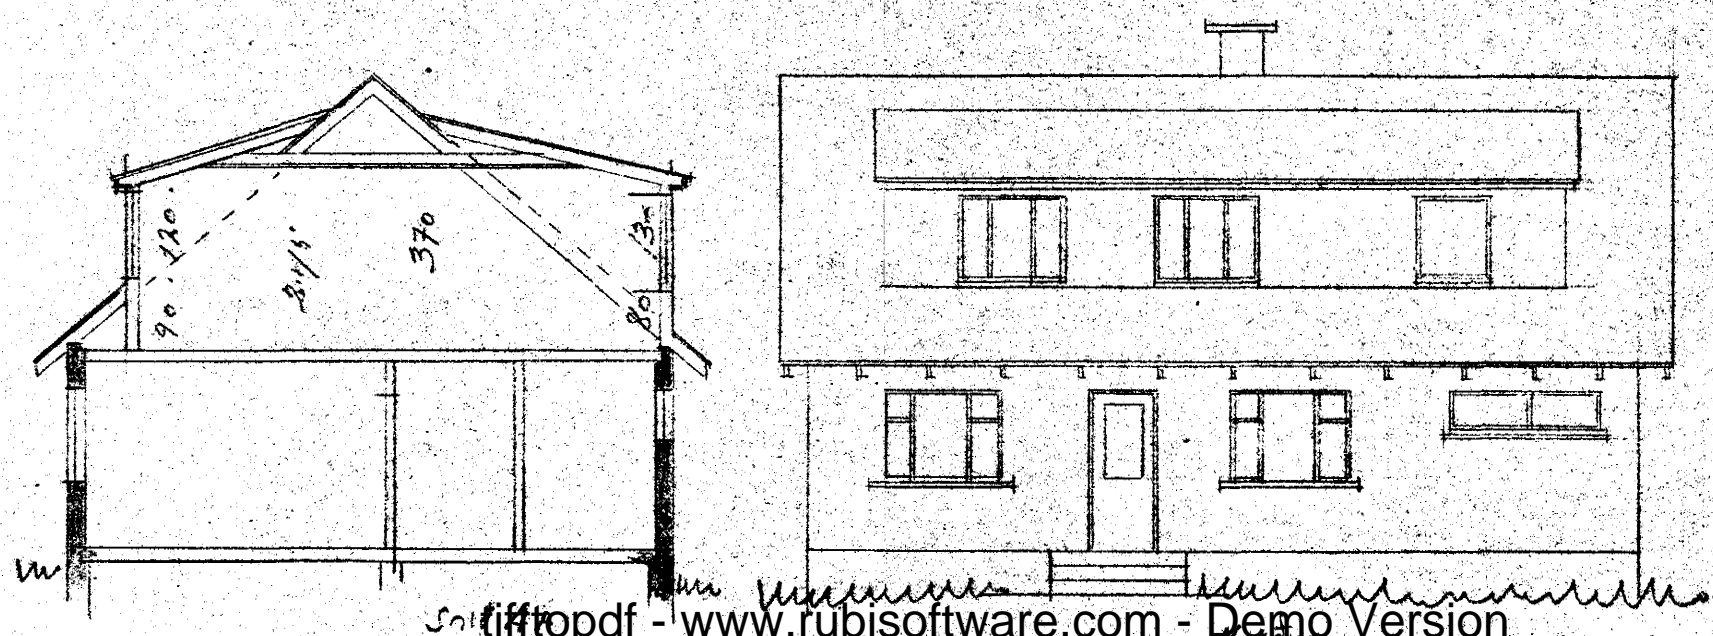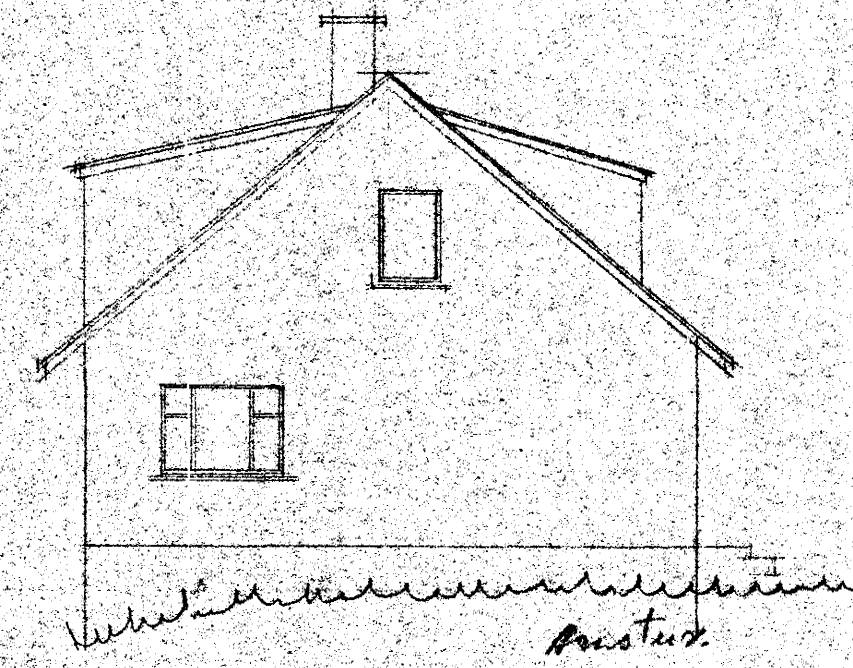




Snittopdf - www.rubissoftware.com - Demo Version

Malikv 1:100

Afstöðumynd
1:2000

Brayðberg

Kvistur á bakhlö
stakken a kvisti
á gölu hlöt.
24. m² stakken
við Vestur. gopl.
um stega hús geymsla
og aldheis.
S. G.

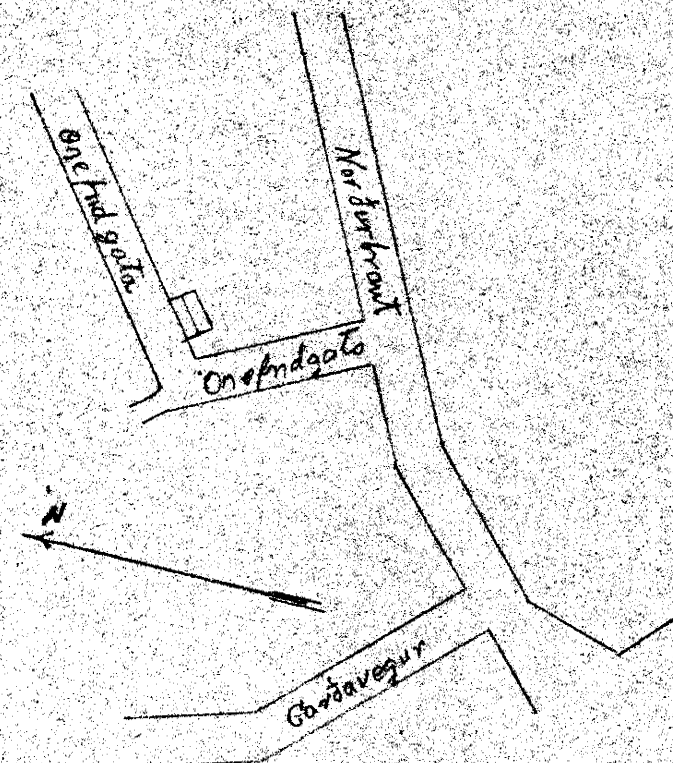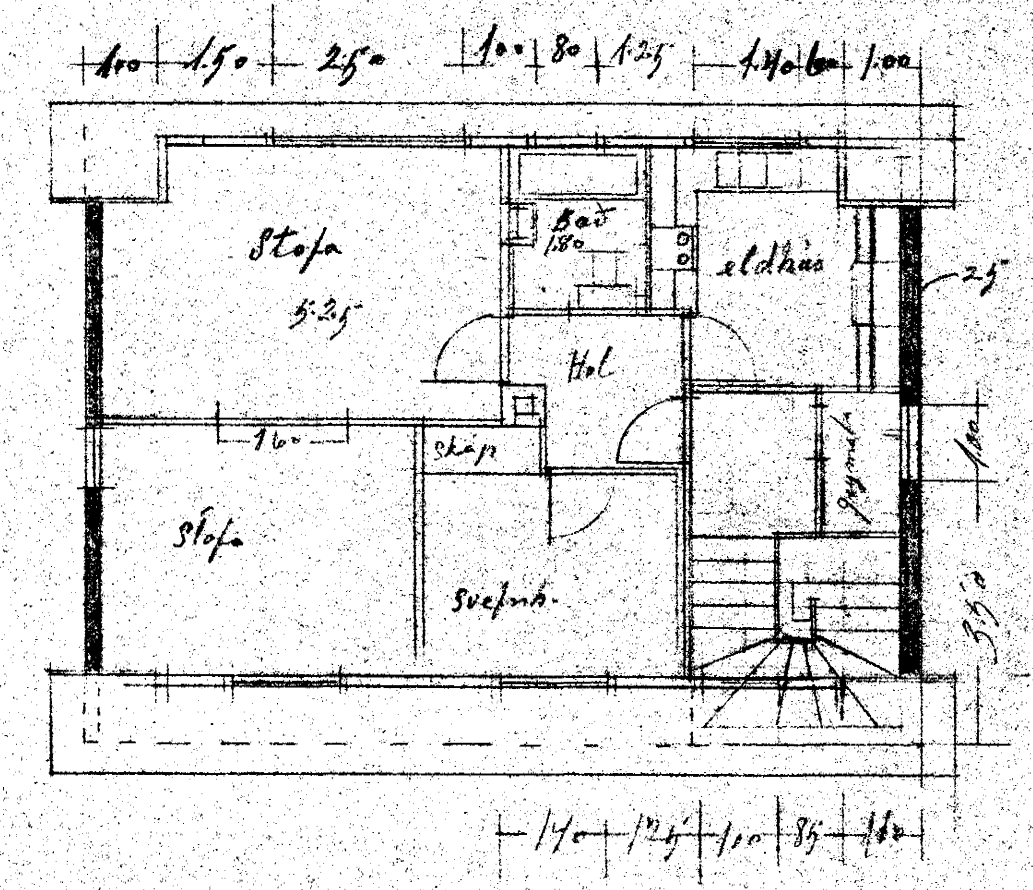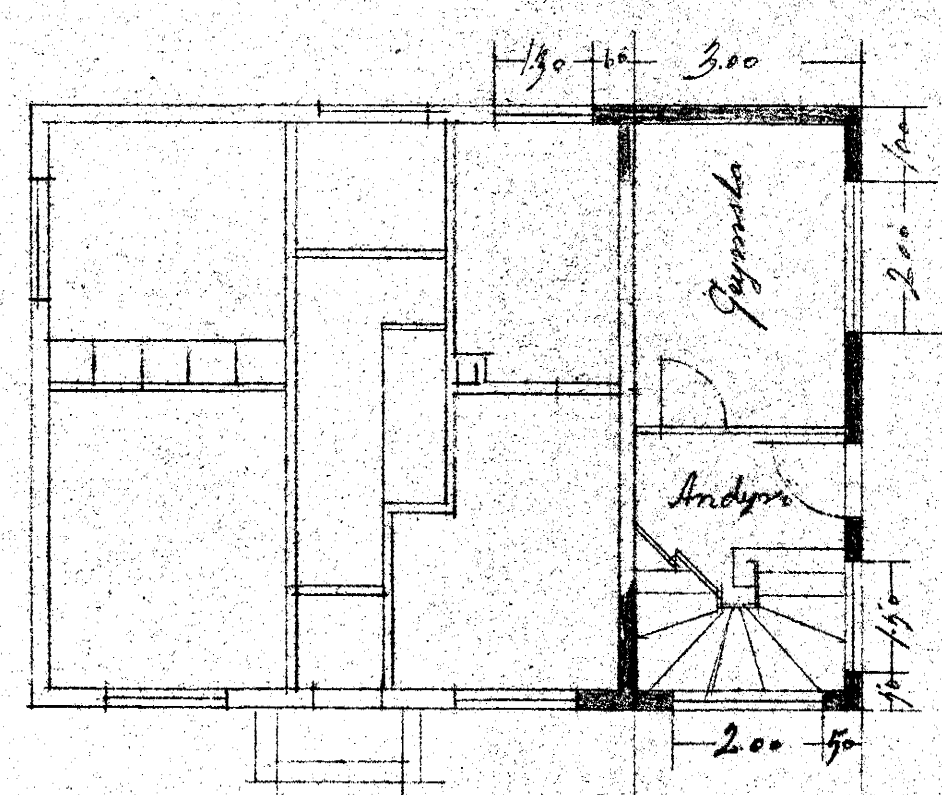

Reykjavík 14-9 '58
Sigmundur Guðmundsson