



Samþykkt á fundi bygginga-
nefndar þ. 9/3 1983
45-1983
BYGGINGA 27/16 RÚM N 84
I HAFNARFIRDI
Björn S. Hallsson

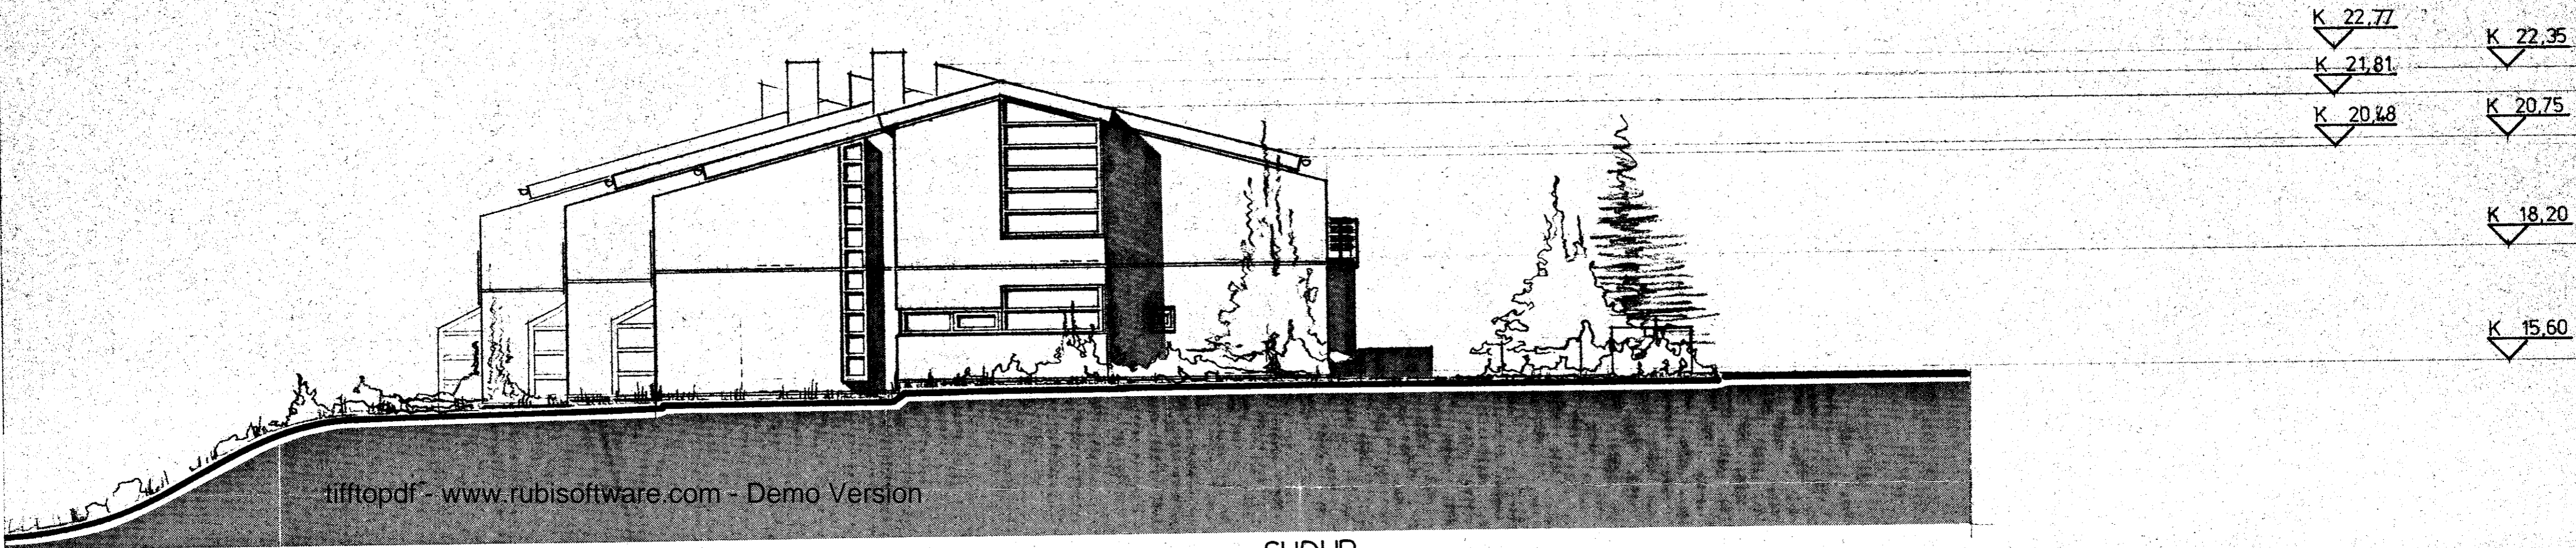

SUDUR

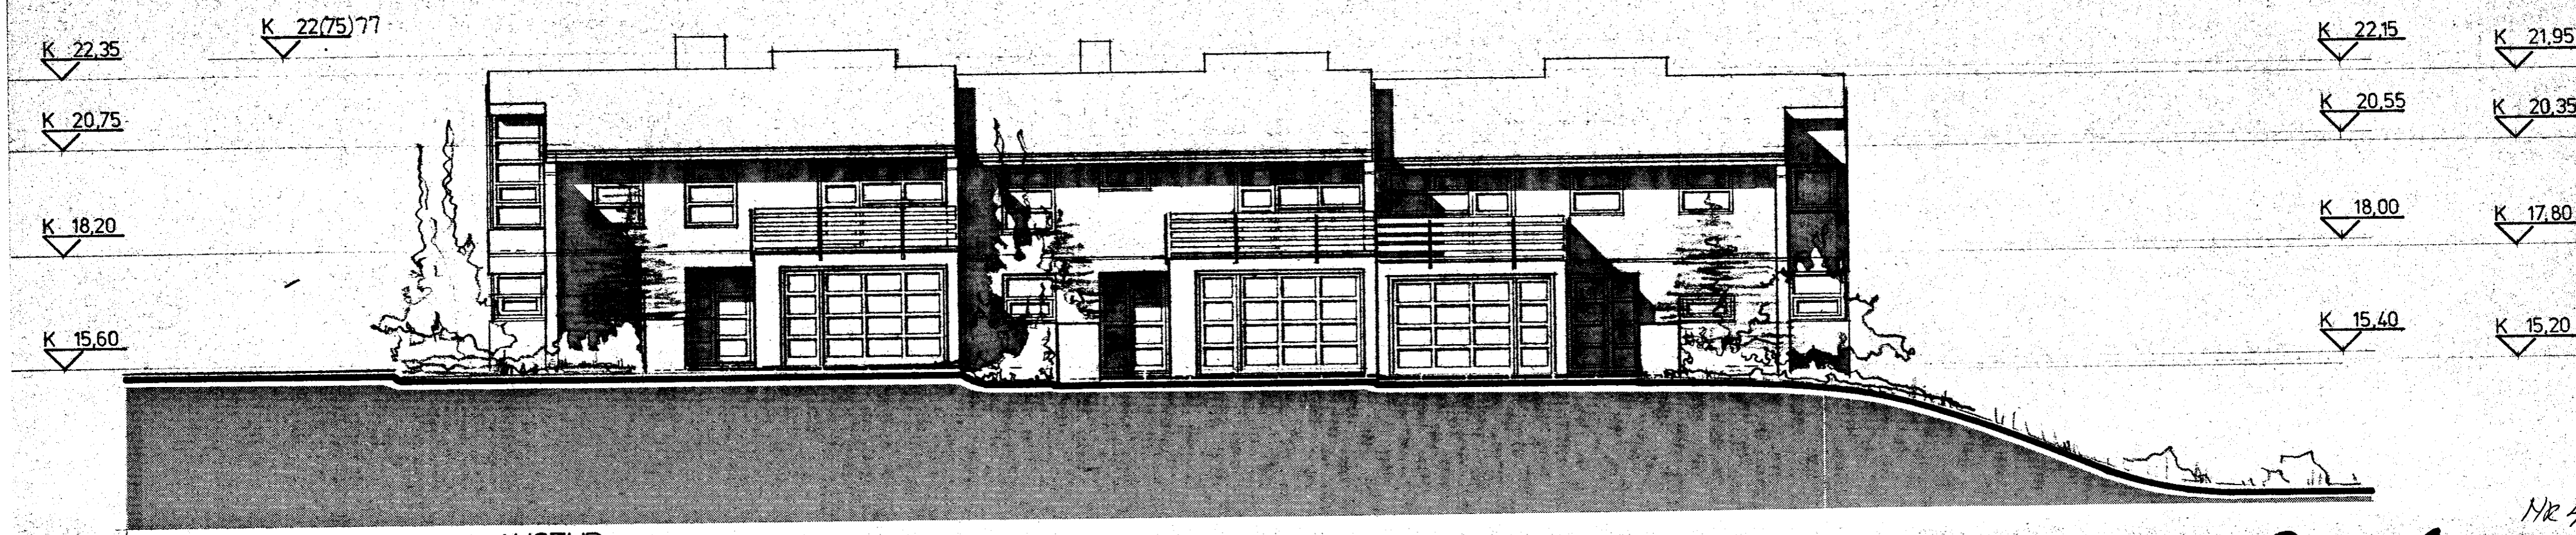

AUSTUR

03 HRAUNBRÚN. 39-41-43 'IBUDARHUS, ÚTLIT M. 1:100

BREYTT 26.05'84
BREYTT 02.06'83
05.03'83

4250-0390-03
HÖNNUN: BJÖRN S HALLSSON STRANDGÖTU 11 54660

Nr 43
Björn S. Hallsson