






KJP

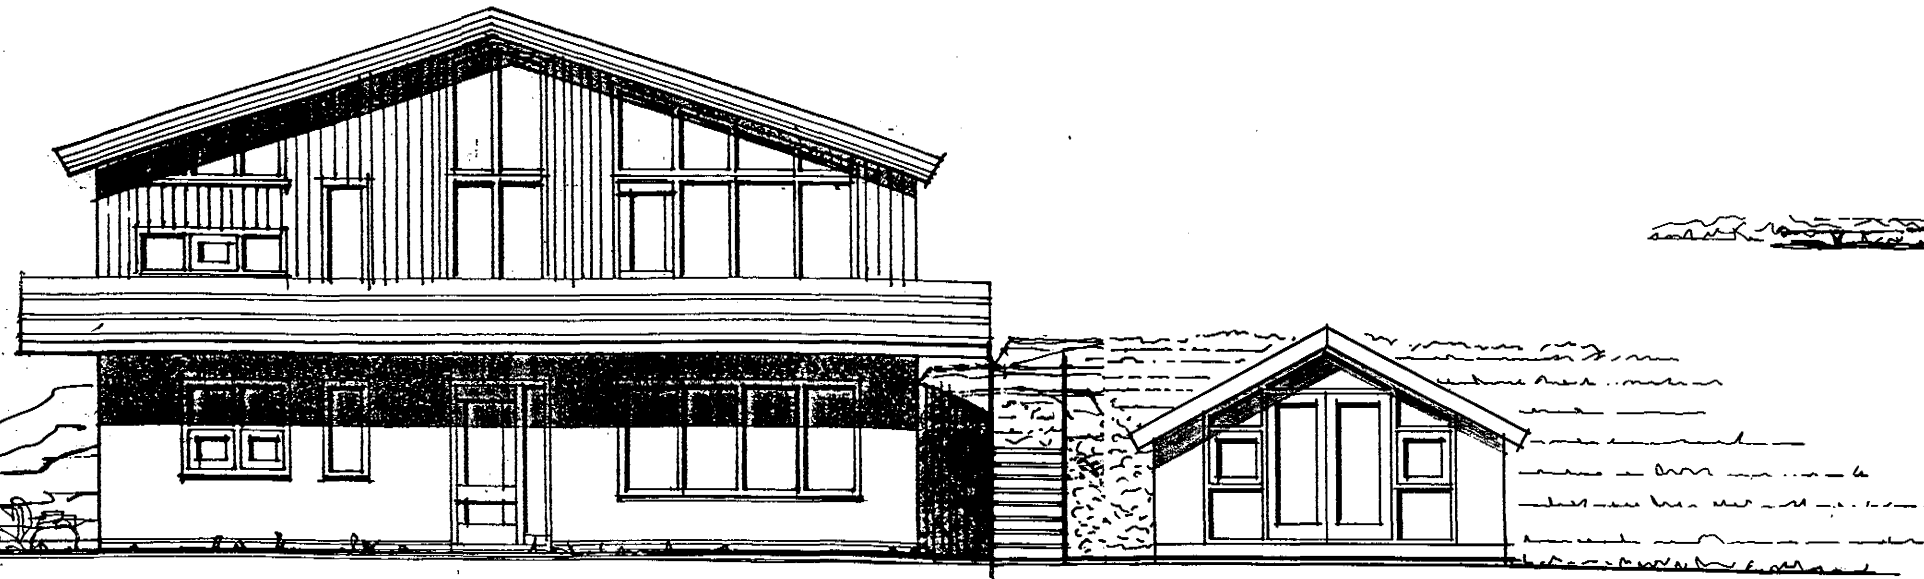


SUBVESTUR M. 1:100

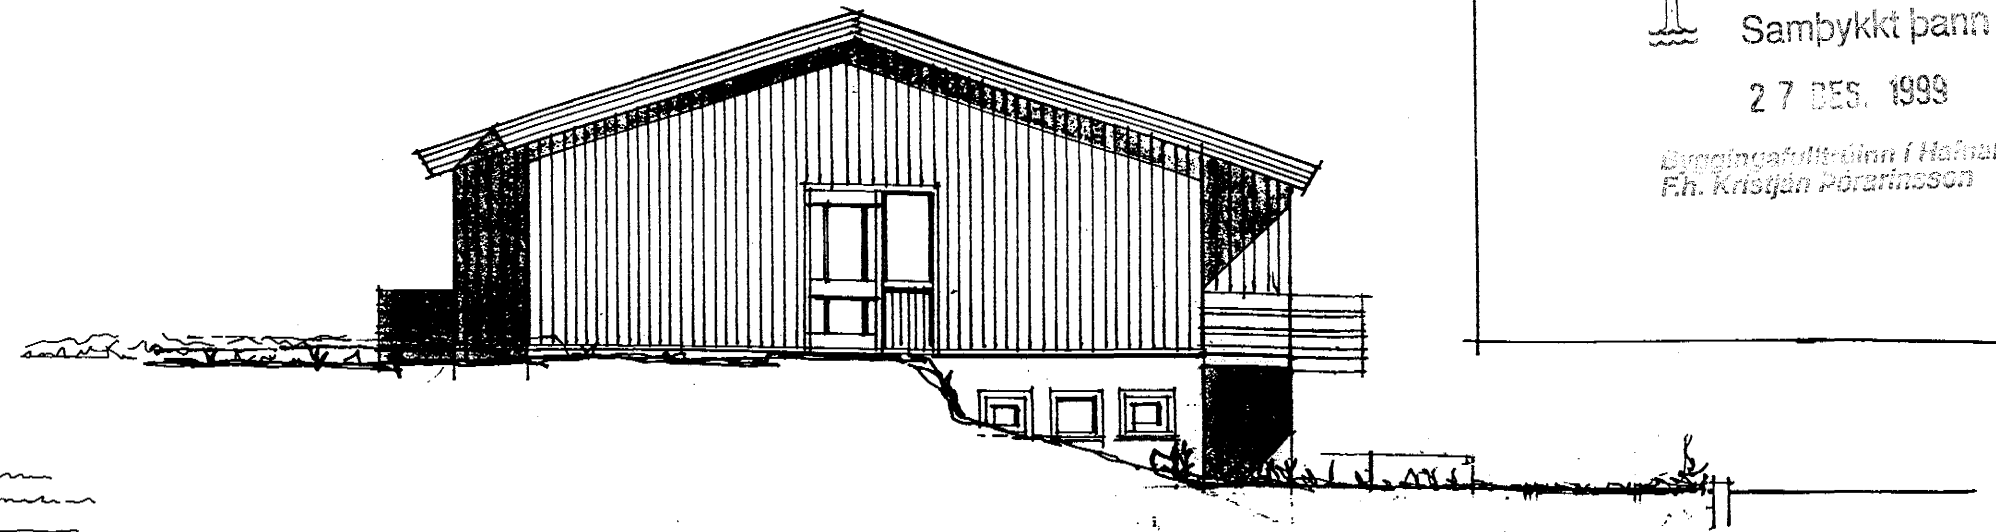

NORBAUSTUR M. 1:100

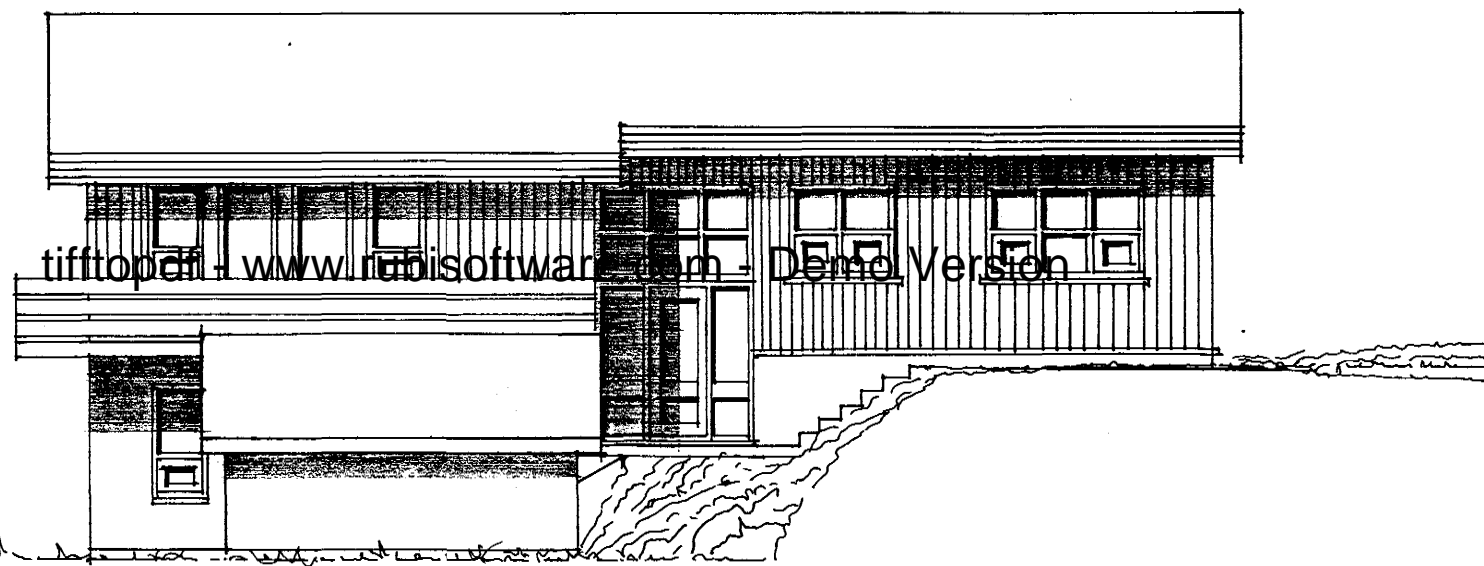


SUDAUSTUR MEÐ YFIRBYGGINGU YFIR HEITUM POTTI M. 1:100.

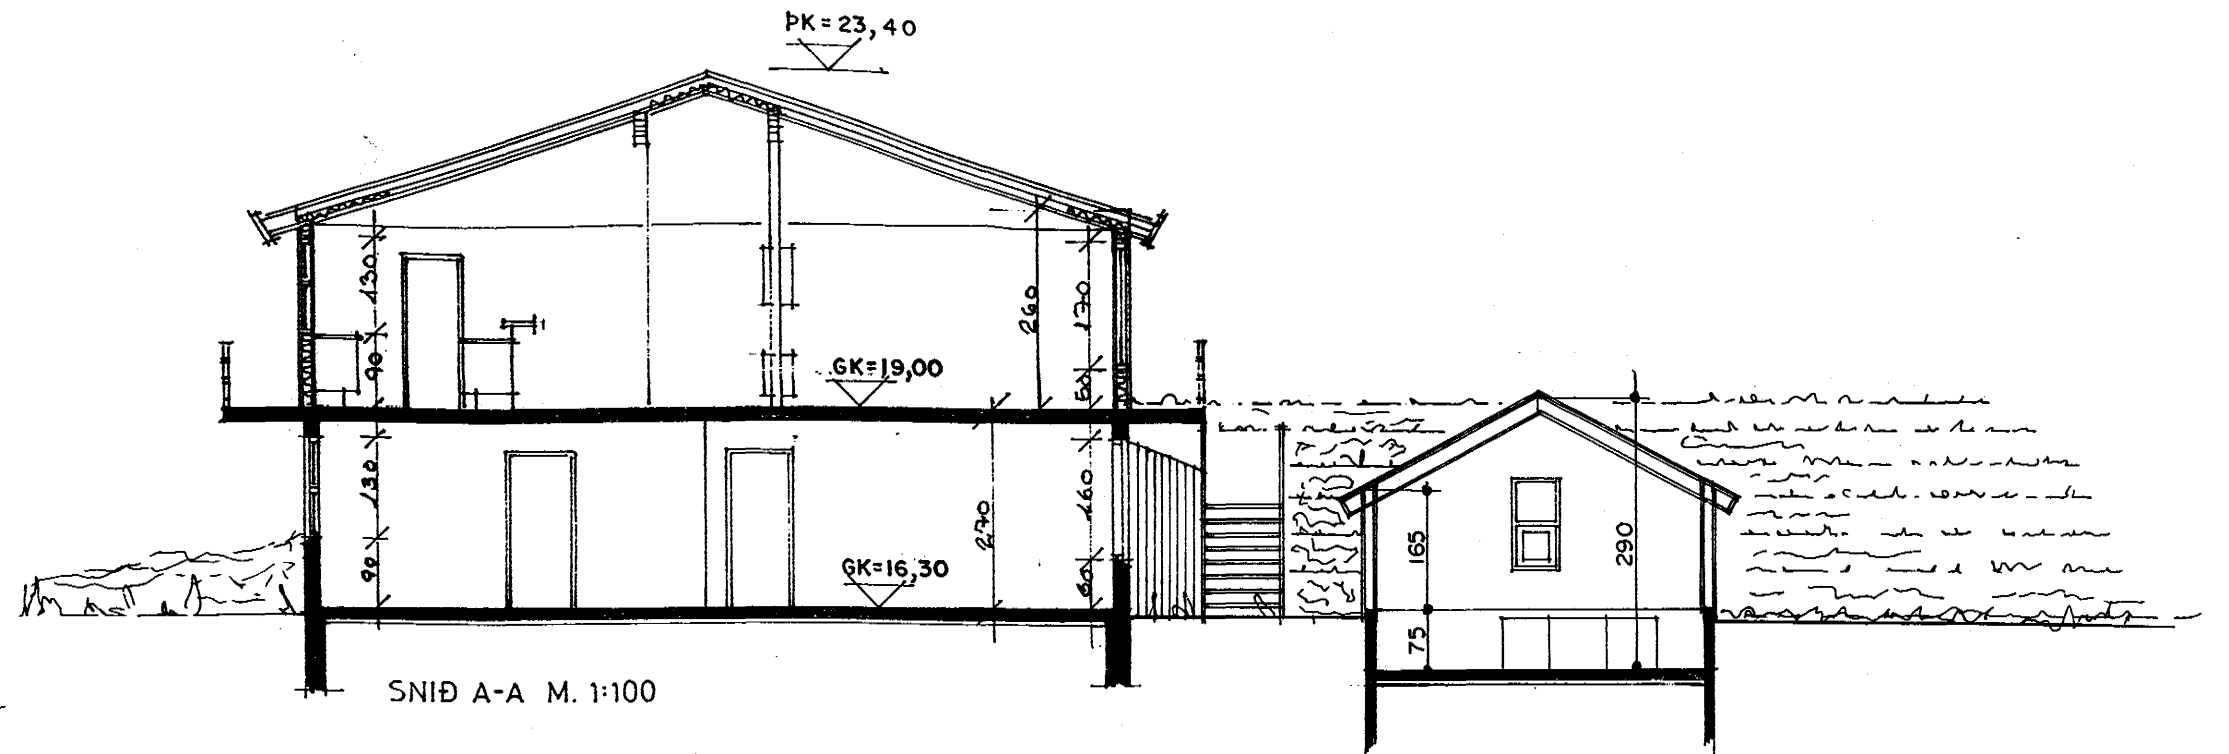

SNID A-A M. 1:100



NORB VESTUR M. 1:100.

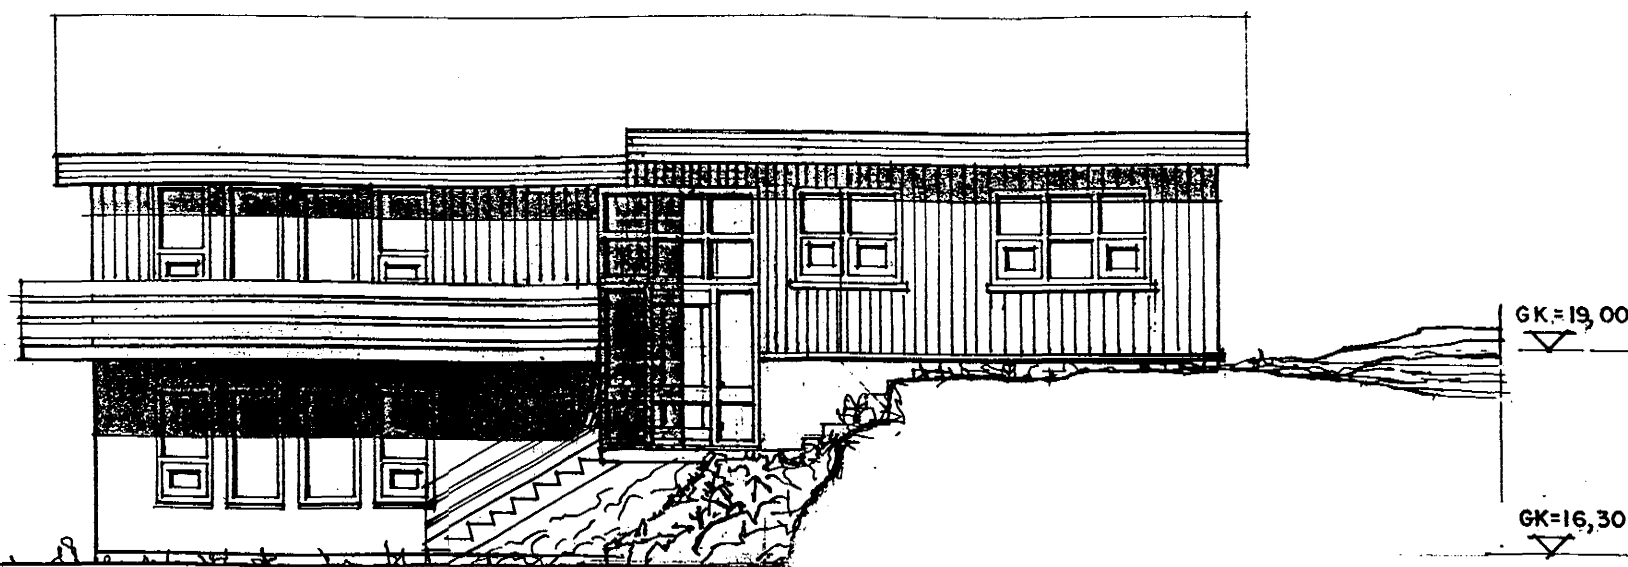

SUDAUSTUR M. 1:100

BREYTT 10. OCT 97  
Lj. Þ.

21/12 99 / M. Þ.