


F. Sig.

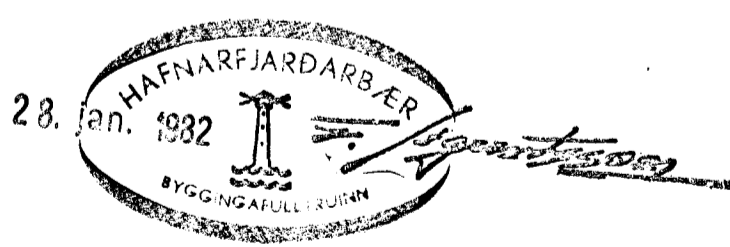

RVIK I REIKN. TEIKN. YFIR. 303 MÆLIKV. 1: 50: 500	HÚSASMÍÐJAN H SÚÐAVOGI 3-5, RVIK. SÍMI 88322 FÍFUHVAMMI KÓPAV. SÍMI 43521	GERÐ NR. VERK NR. 104641 TEIKN NR. 21
	BRAUNDRÚU 51, HAFNARFIRÐI.	
	JARÐLAGNIR	