



RÚMMYND HITALAGNA M=1:50

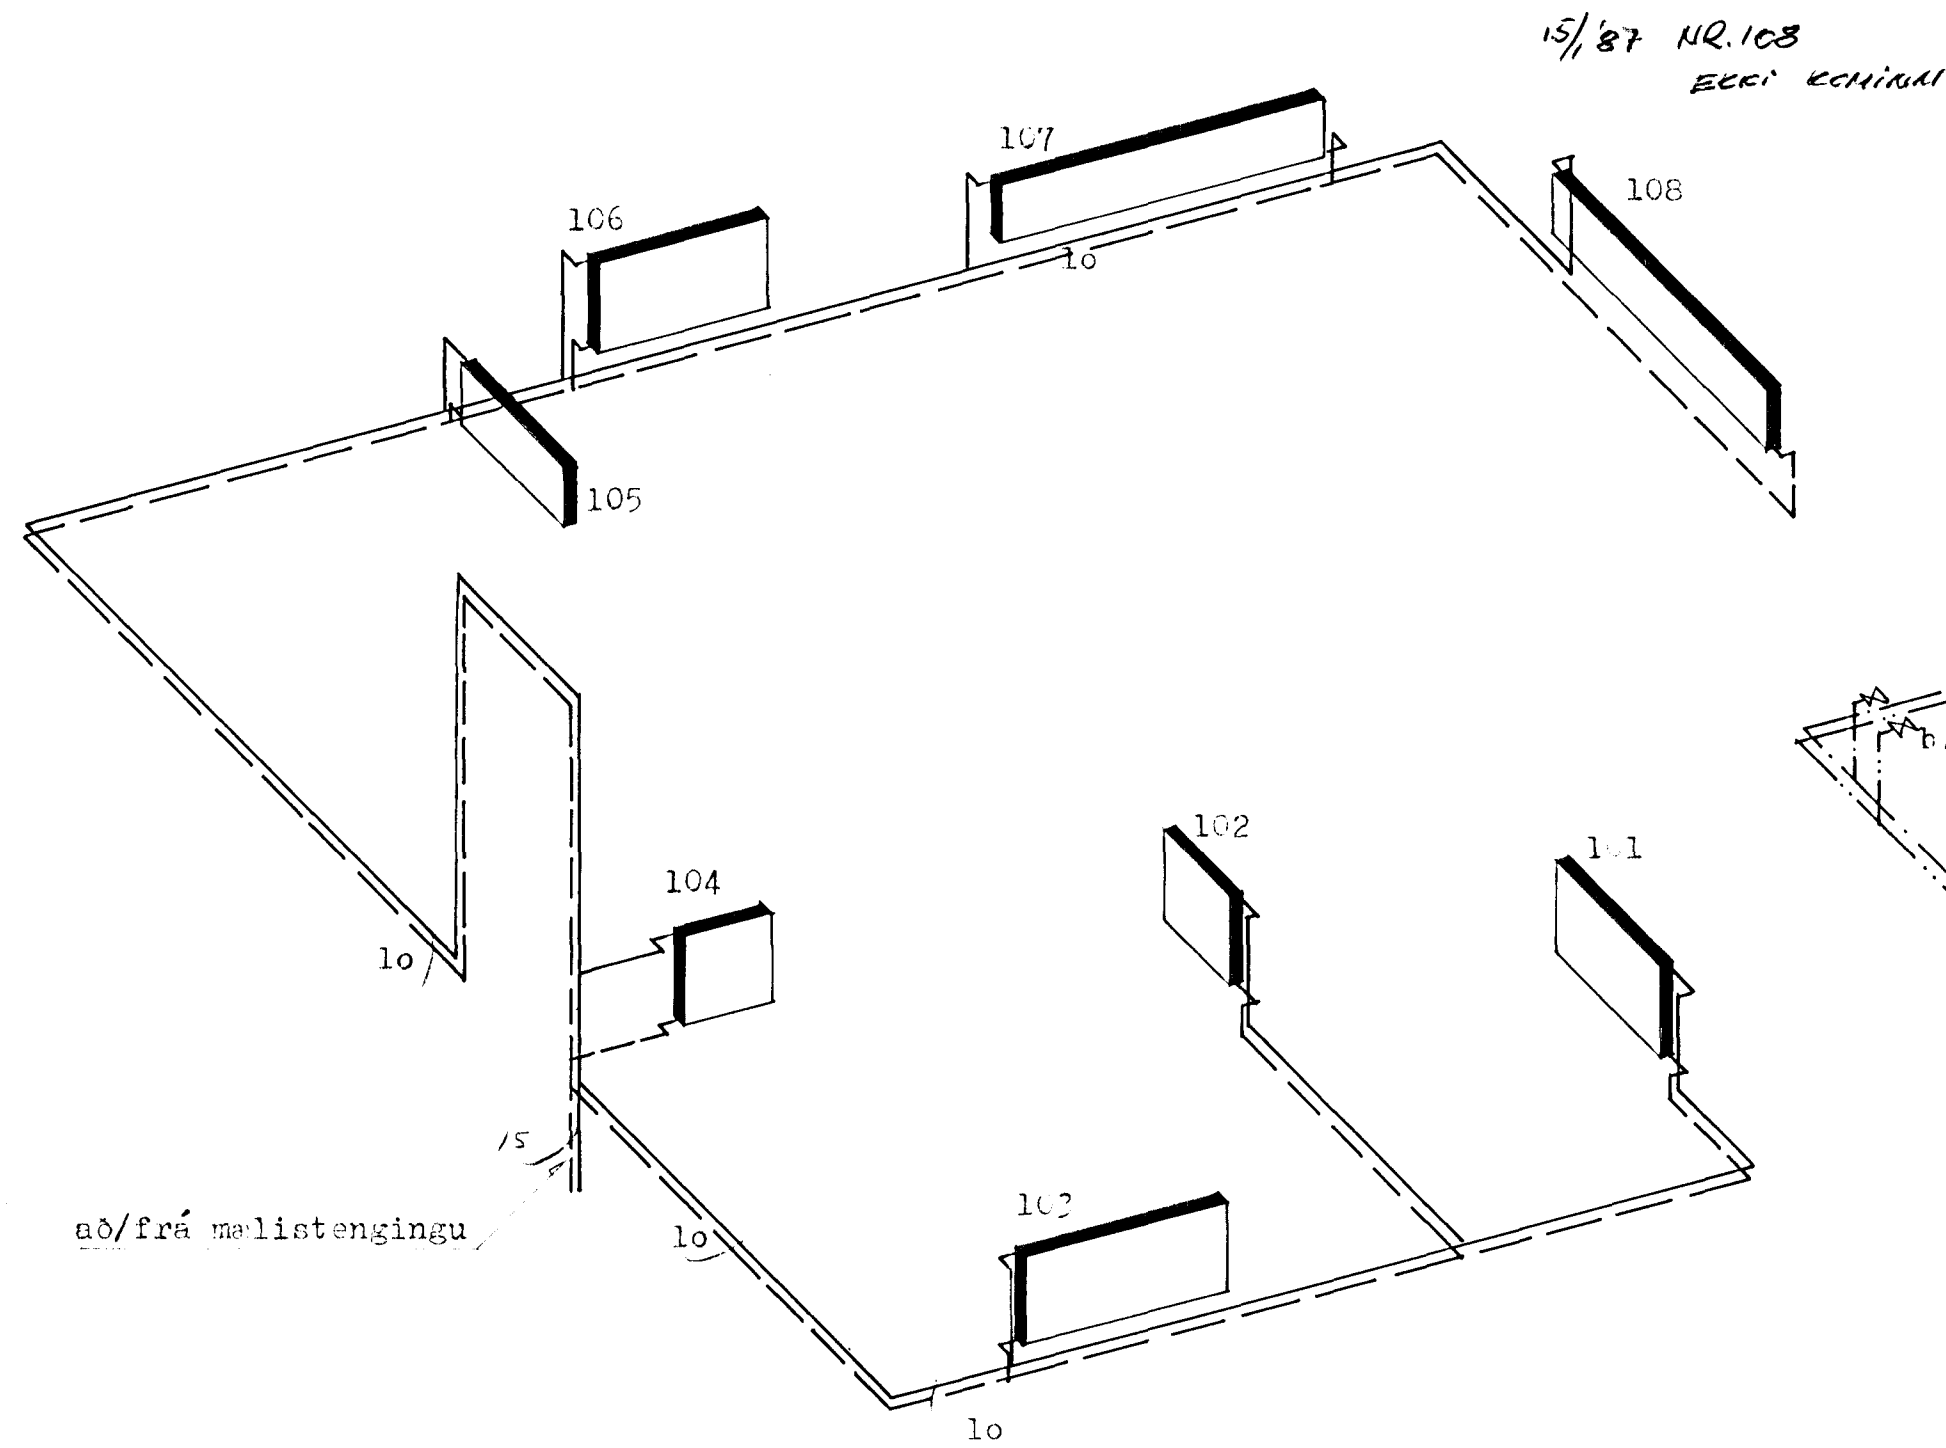



RÚMMYND VATNSLAGNA M=1:50

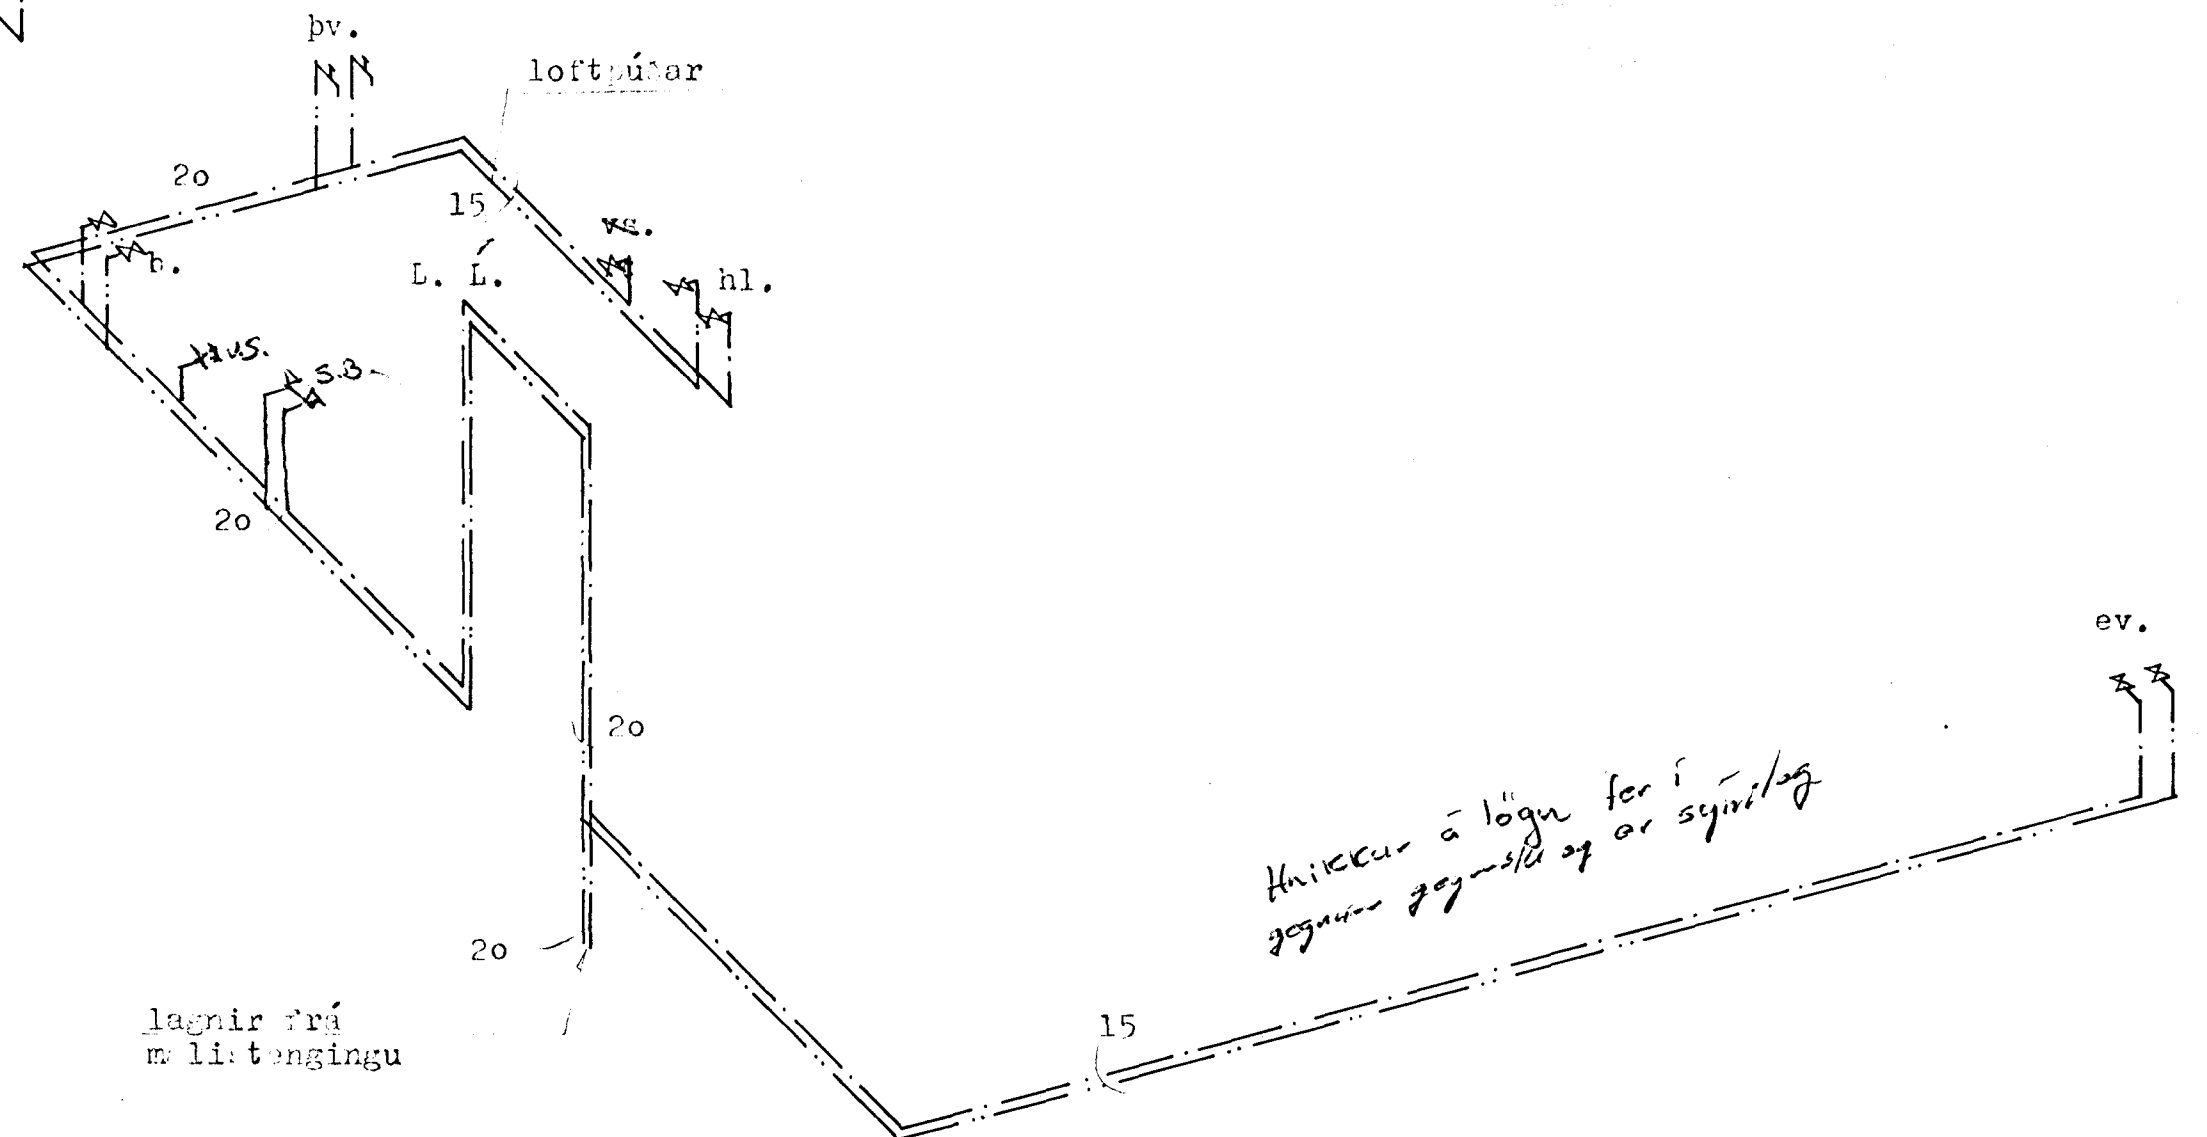

OFNATAFLA

ÖFN NÚM.	VALDIR	ÖFNAR	PHDEL	TENGINGAR
101	P20	L=1000	H=600	A-B
102	P11	L= 600	H=600	A-E
103	P11	L=1400	H=600	C-F
104	P10	L= 600	H=600	C-D
105	P20	L=1000	H=600	A-E
106	P11	L=1200	H=600	A-F
107	P22	L=2200	H=600	A-D
108	P11	L=2000	H=600	A-D

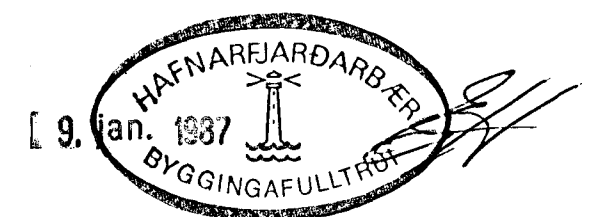



**TEIKNISTOFAN RÖDULL**  
ARMULA 36 - 108 REYKJAVÍK - SÍMI 33950 & 33577

**HRAUNHVAMMUR I, HAFNARFIRÐI**

Lagnir - rúmmýndir

TEIKN: AMH	DAGS: Jan. '87
REIKN: H.G.	VERK: 86056
YFIRF: M.S.J.	BLAD: 2.02
MKV: 1:50	

*Adolf Gunnarsson*