





Samþykkt á fundi bygginga-
nefndar 9.10.1974
BYGGINGAULLTRÖKK
Í HAFNARFIRDI
F. Sigurðsson

*Scorpy skul vera fyrir
þetta ábúttinn.*


AFSTÖÐUMYND M = 1:500

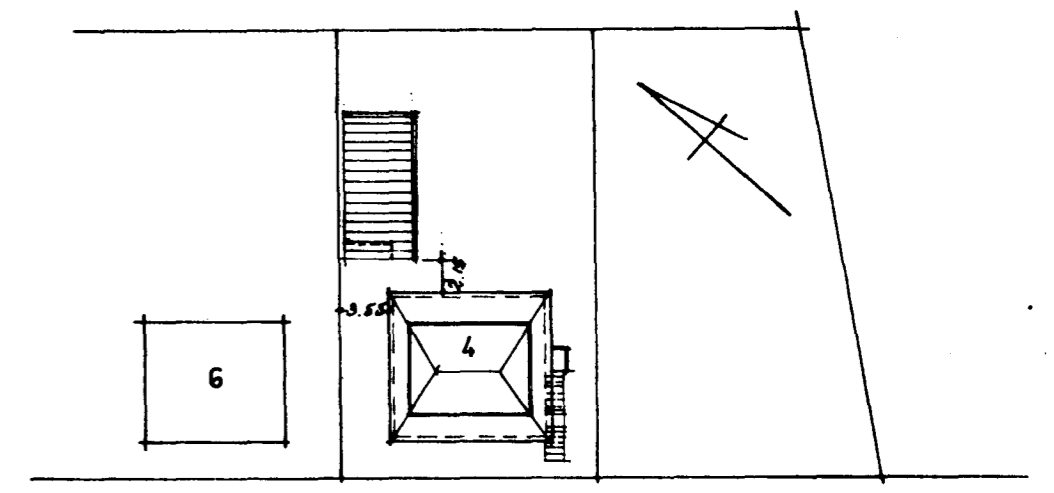



HRAUNKAMBUR

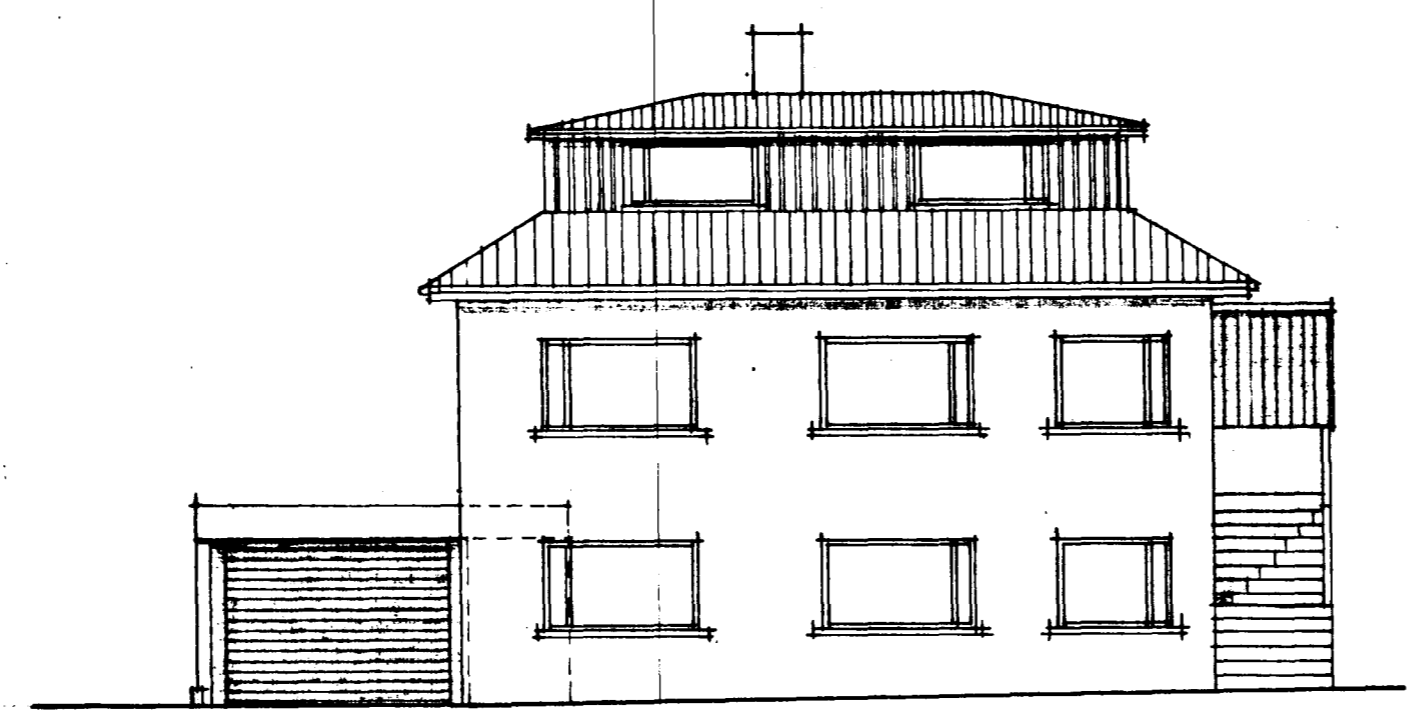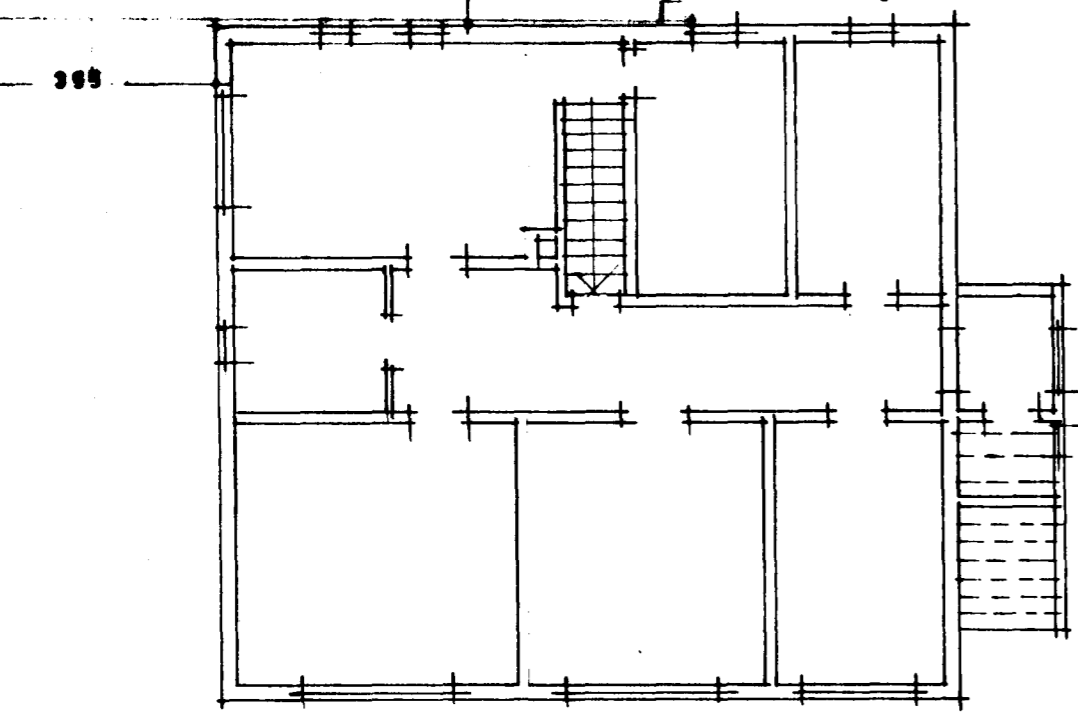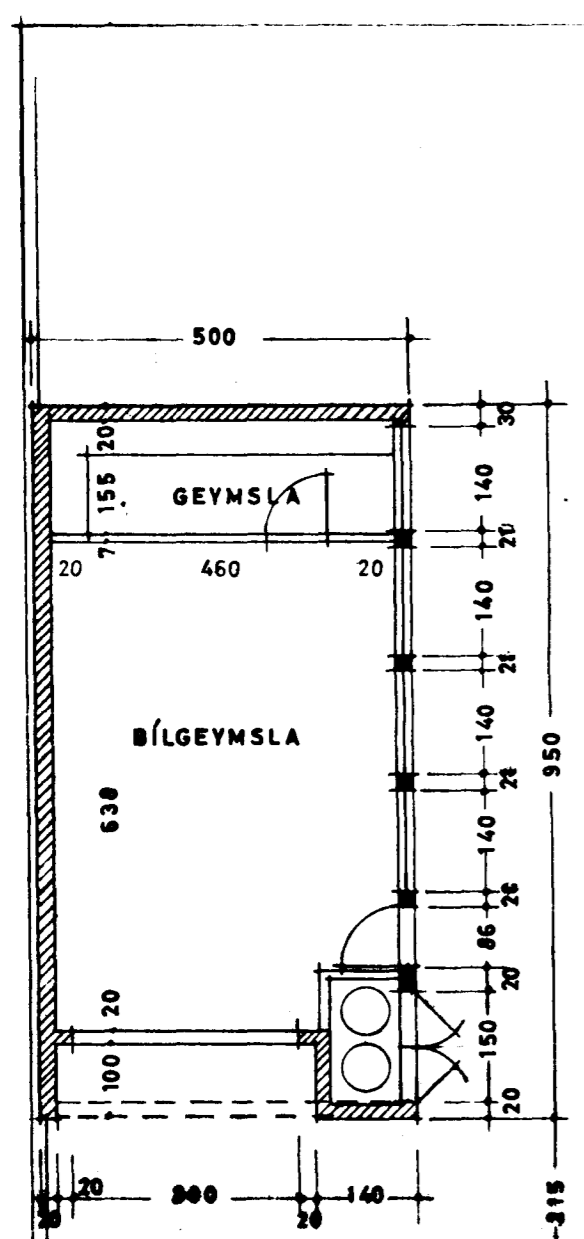

SUÐVESTUR

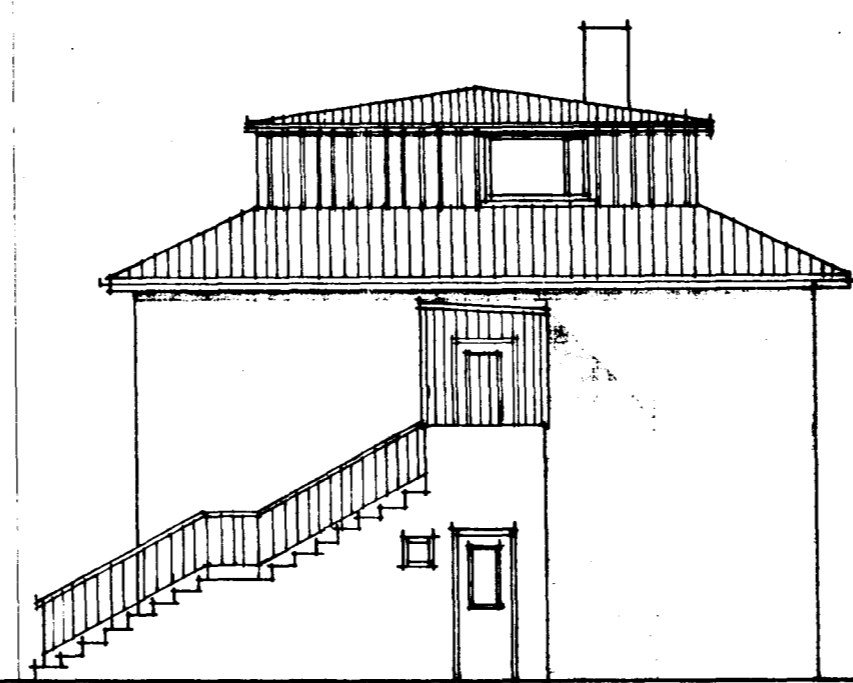

SUÐAUSTUR

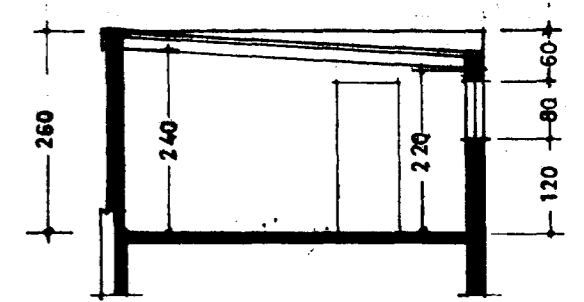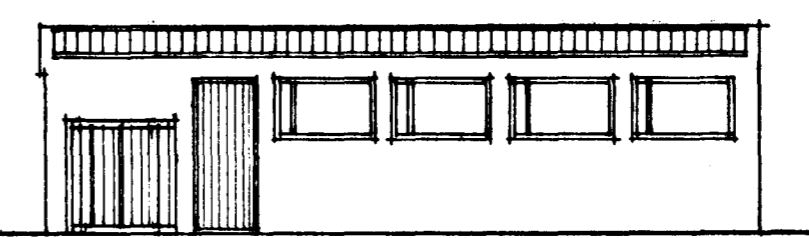

SNEIÐING

$$\begin{aligned}
 &9.5 \times 5.00 = 47.50 \\
 &\div 1.00 \times 3.4 = \frac{340}{47.10 \text{ m}^2} \\
 &\times 2.50 = \frac{110 \text{ m}^2}{110 \text{ m}^2} \\
 &\text{@ } 7/92 = 871,-
 \end{aligned}$$

SVEINBJÖRN SIGURÐSSON TEKNIFR. MTFÍ		
MIÐVANGI 116 SÍMI 52256		
HRAUNKAMBUR 4	1:100	DAGSETN.
	1:500	16.9.74
BÍLGEYMSLA GRUNNMYND ÚTLIT OG SNIÐ	BREYTING	DAGS.
	HÆÐ Á BÍLG	4.10.74
	HANNAÐ	DREGIÐ <i>FS</i>
<i>Sveinbjörn Sigurðsson</i>		7406-1