




SKÝRINGAR ERU Á BLADI NR 5

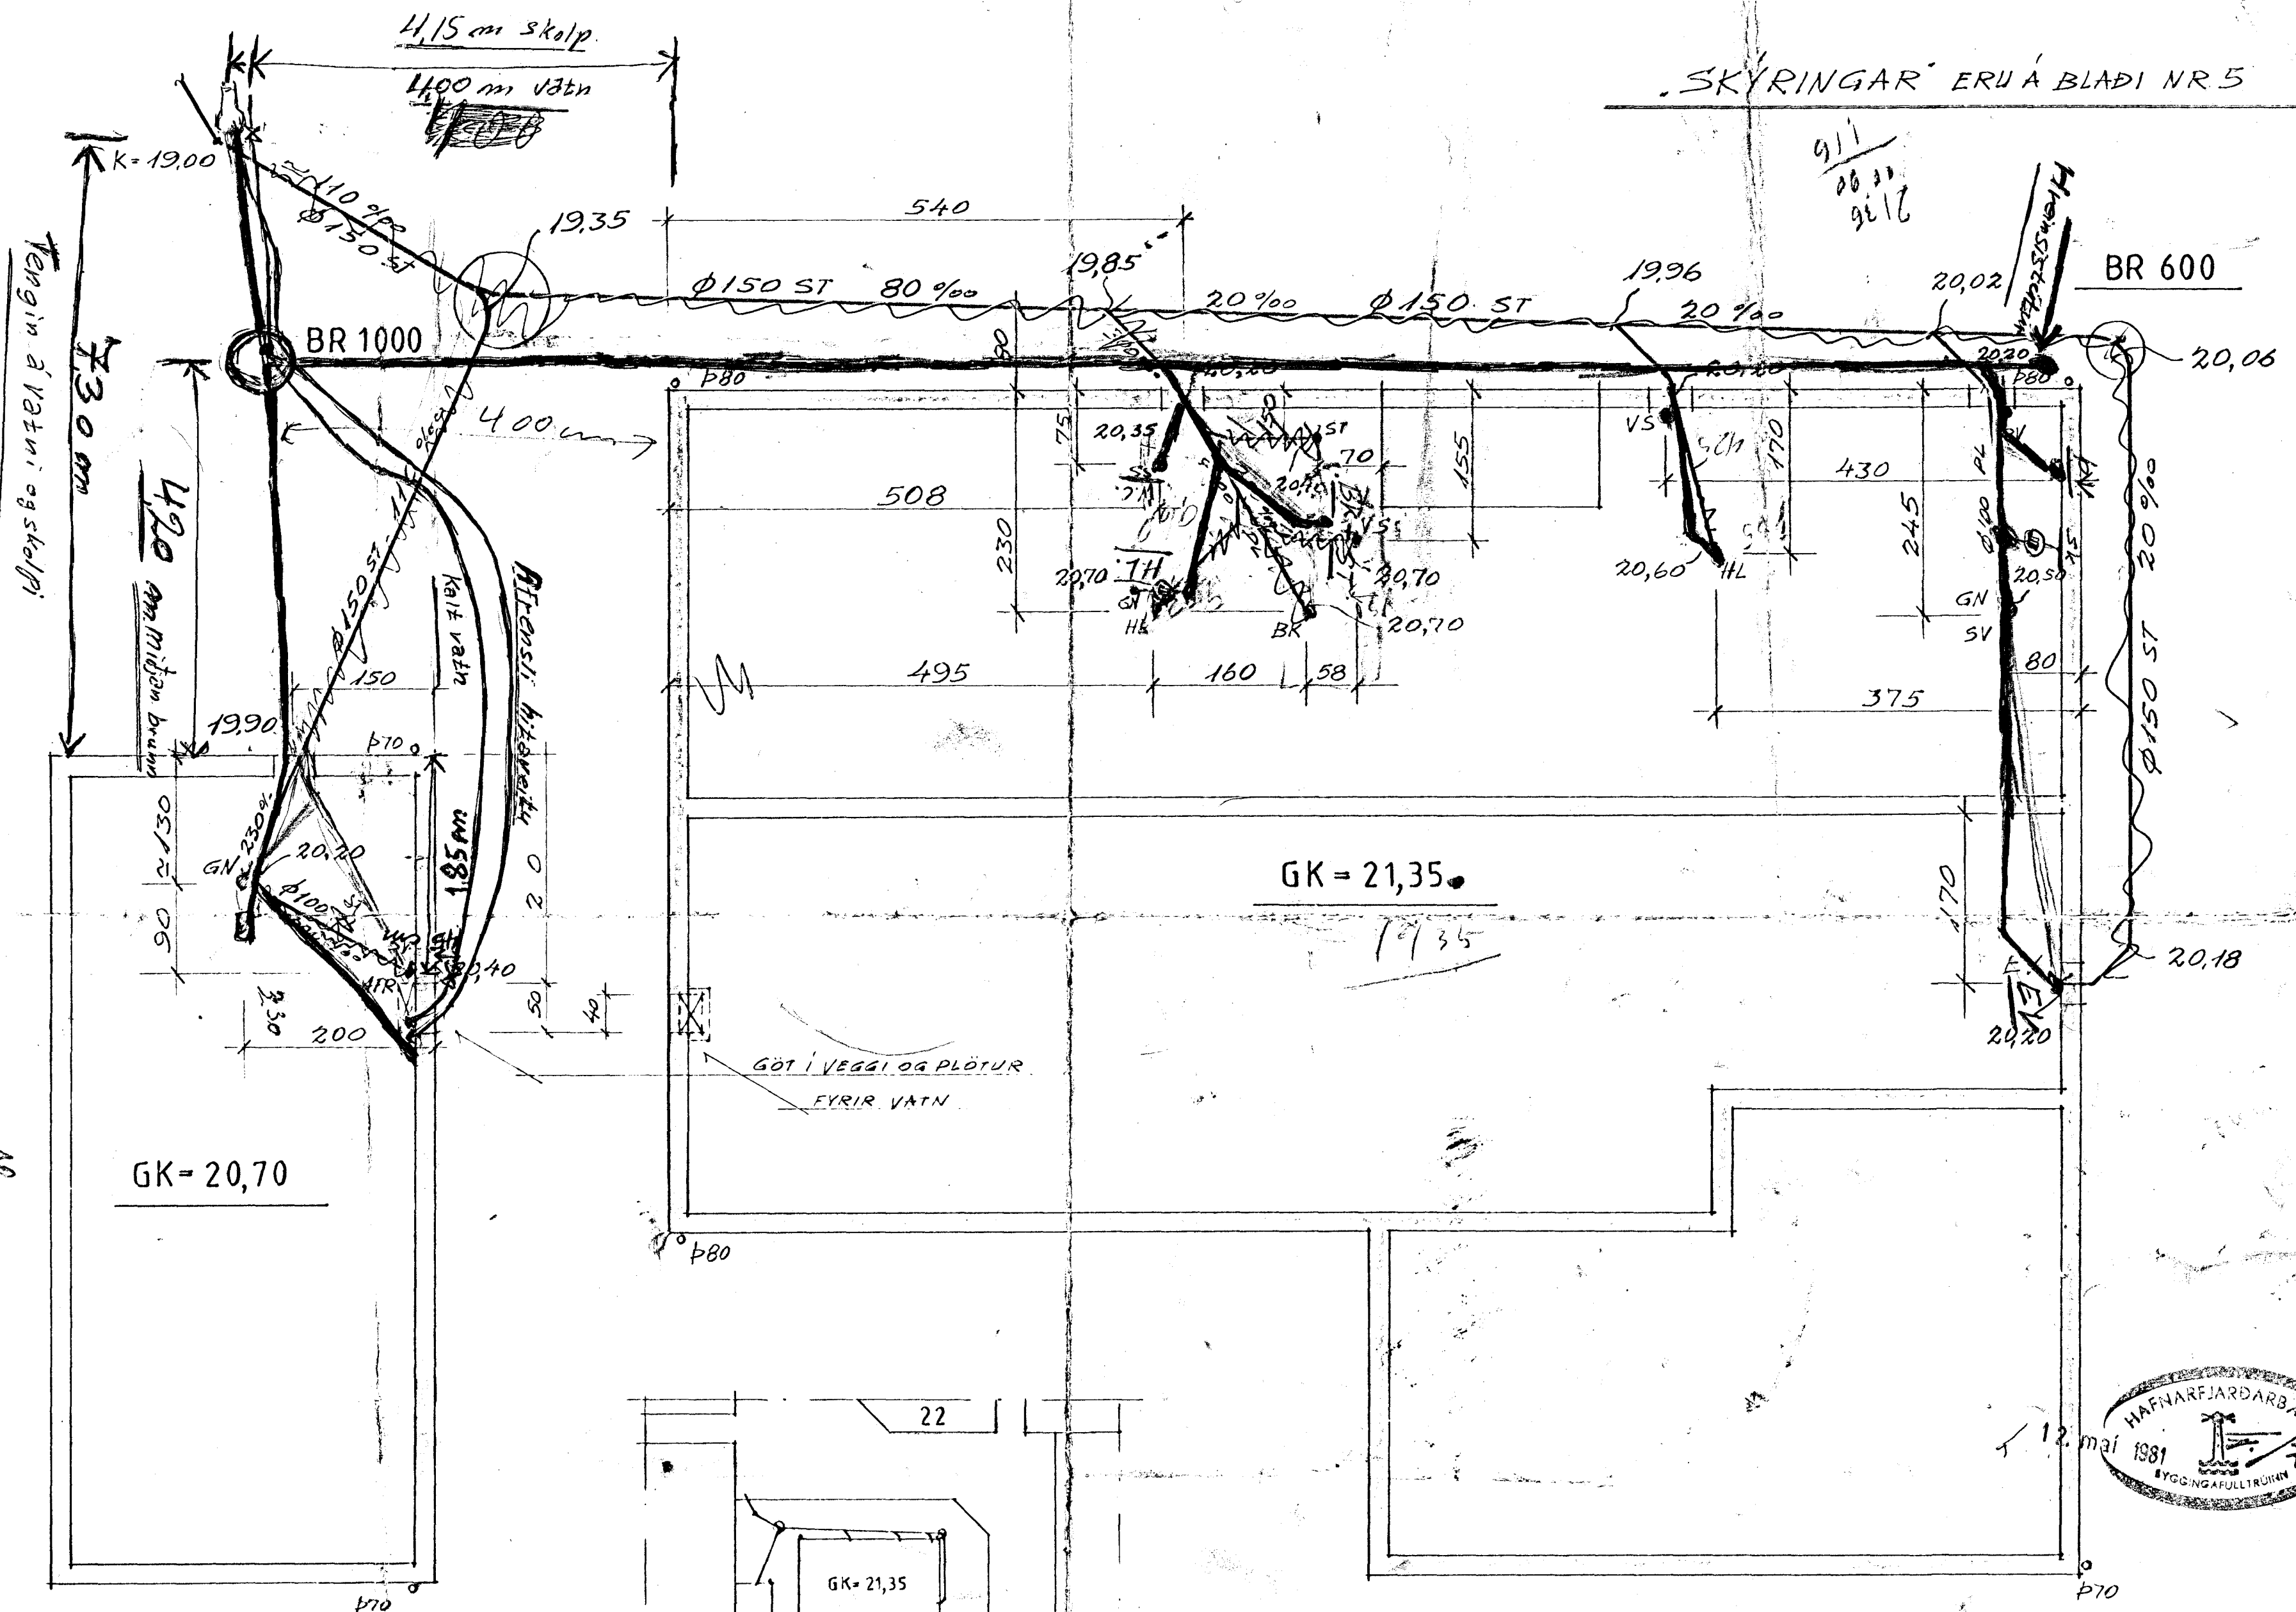

Tengin á vatni og skelpi

GK = 20,70

GK = 21,35

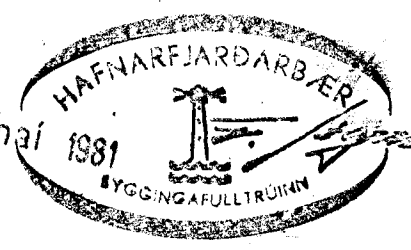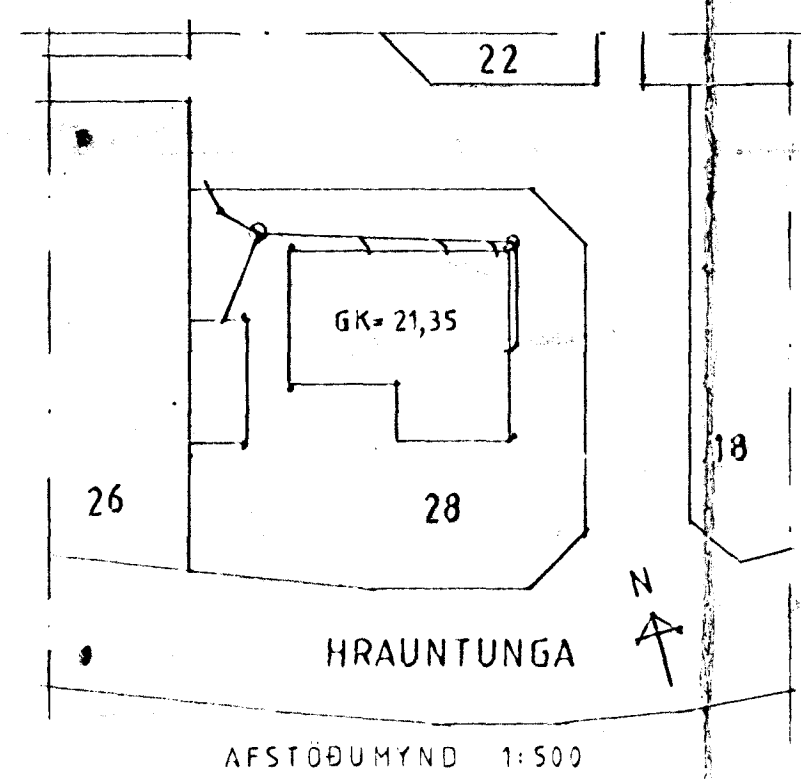

VERKFRÆÐISTOFA SUÐURLANDS
Heimahaga 11 Selfossi sími 99-1778

HRAUNTUNGA 28 HAFNARFIRÐI

FRÁRENNSLISLAGNIR PLAN
AFSTÖÐUMYND

BLAD	4
KVARDI:	1:50
REIKN.	
TEIKN:	E S
DAGS:	MARS 82
NR	

NR	DAGS	BREYTING	AF	SAMB
1	13-3-82	REGNVATN, LAGVIR BILSKÚR, LAGVIR		

David Skulþórsson

08
15.4.82

N