
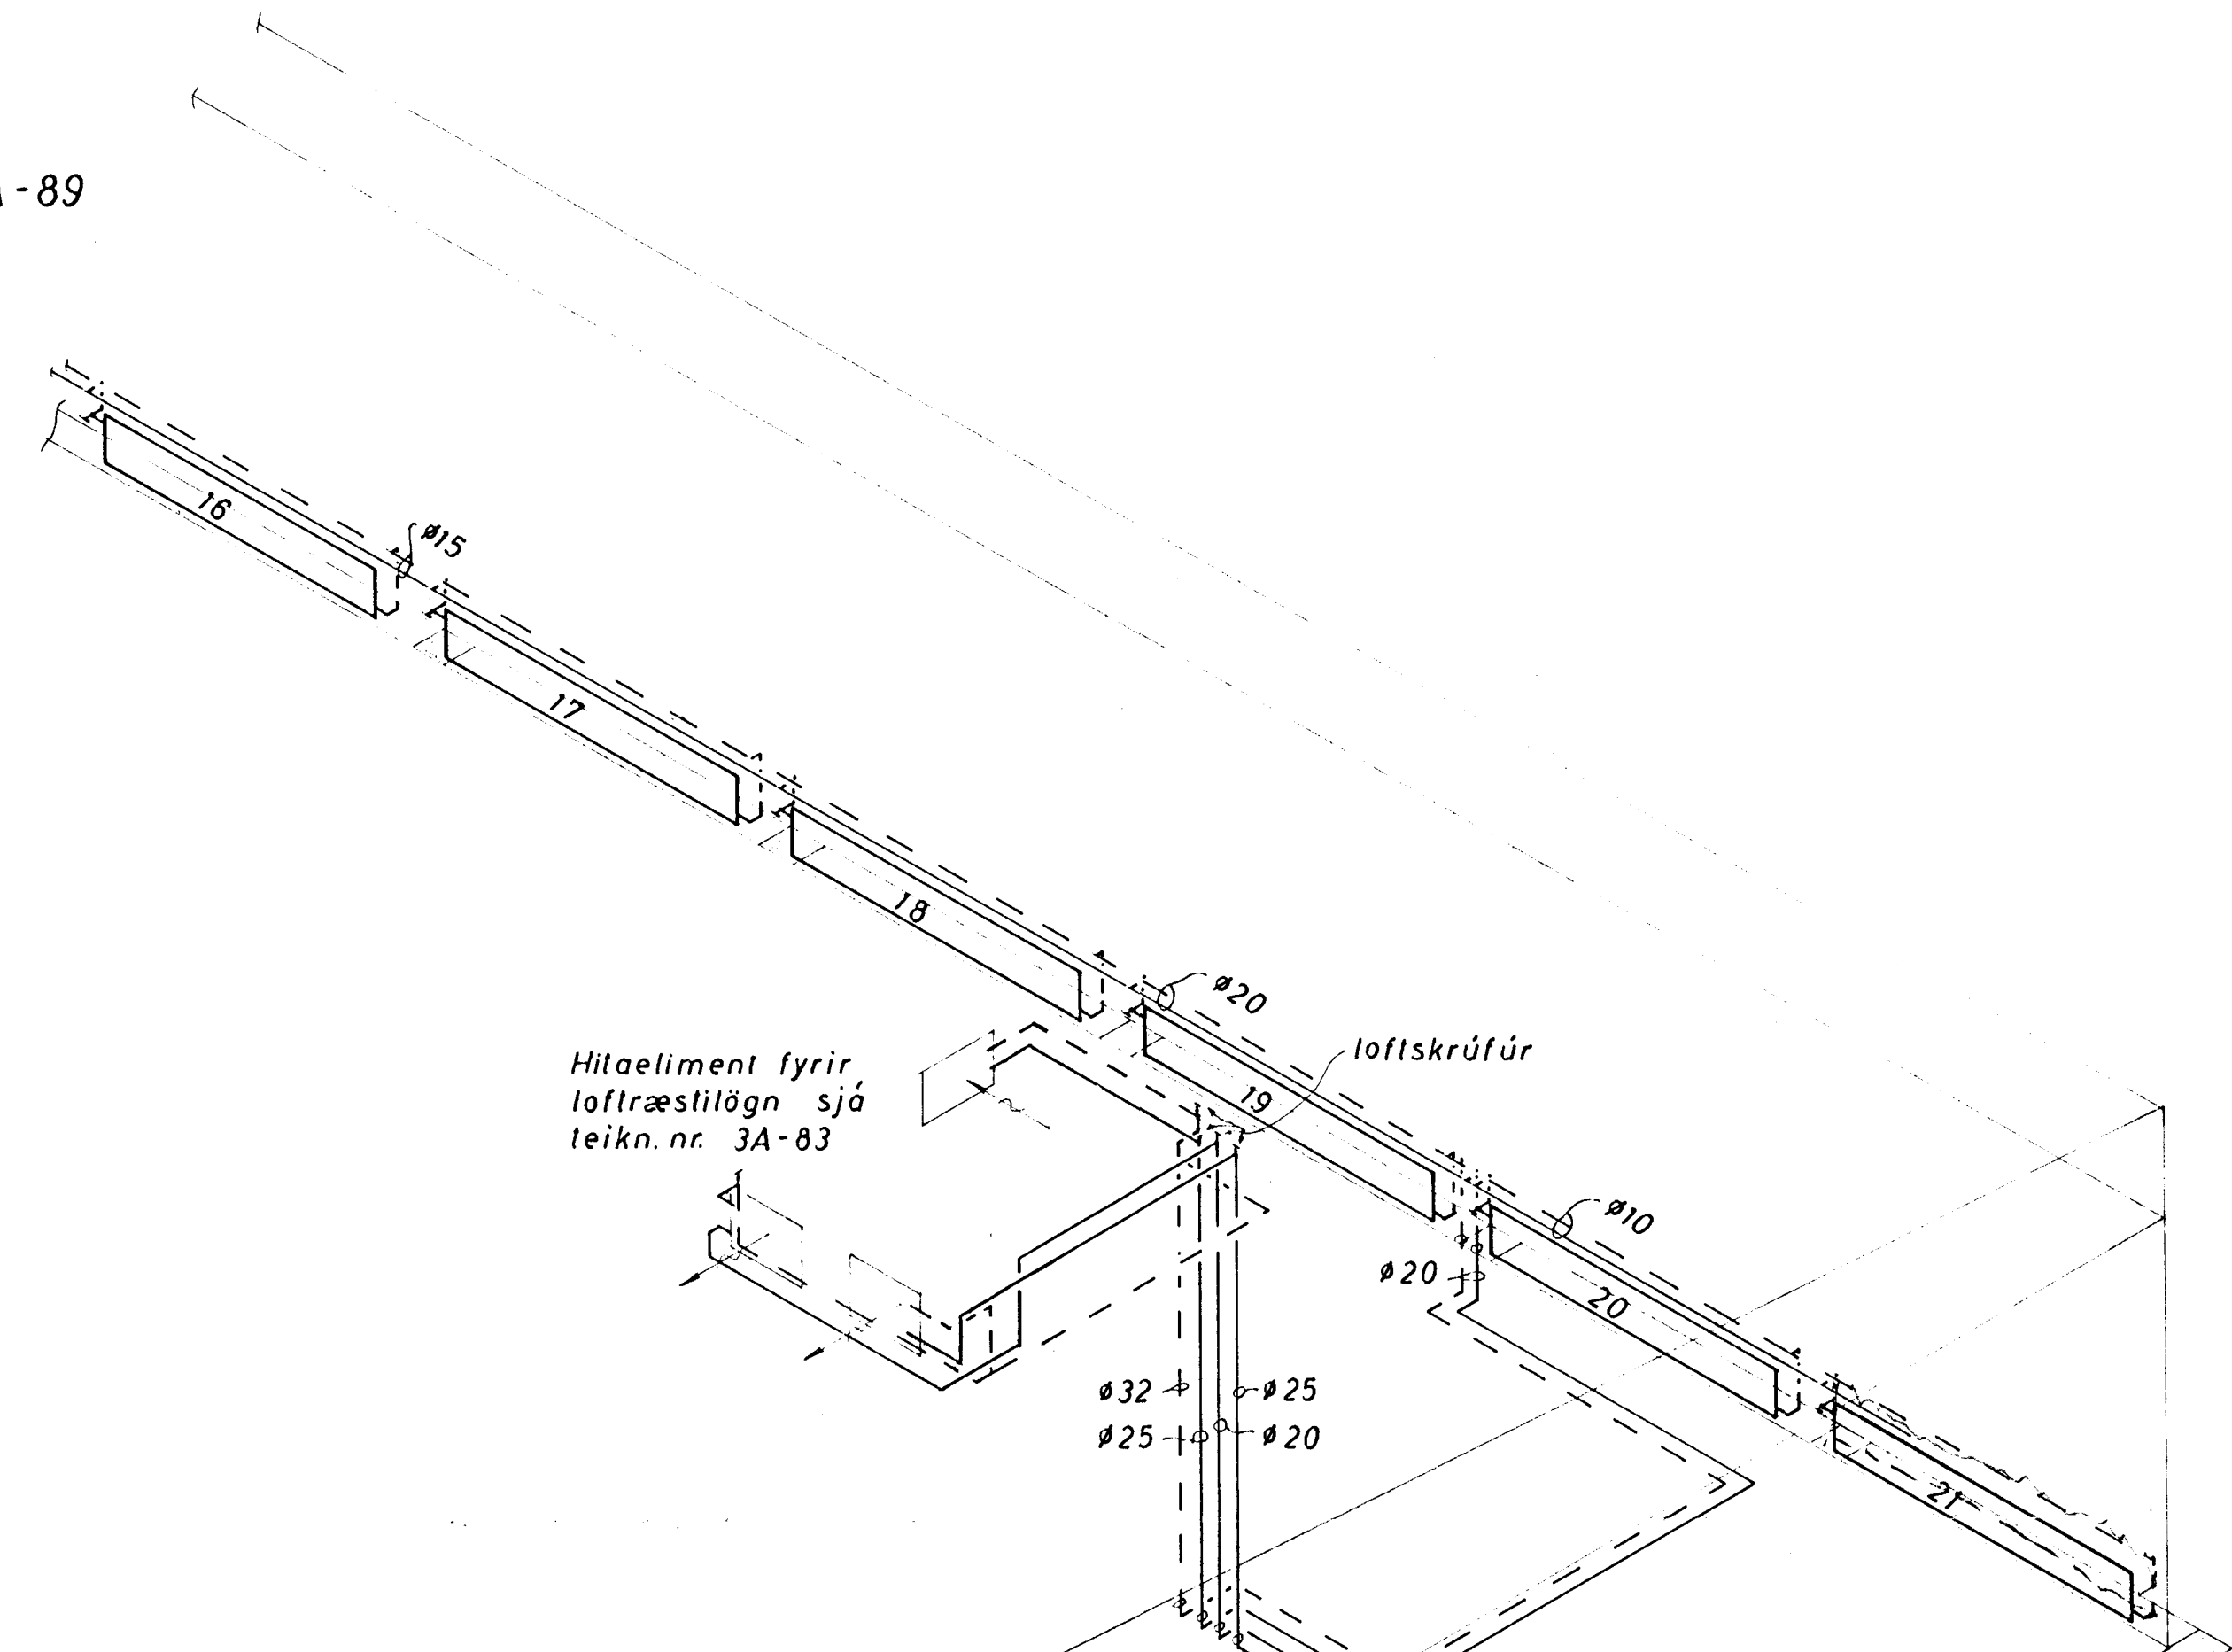



Framhald sjá teikn. 3A-89

Tenging hitaelimenta fyrir loftræstilögn

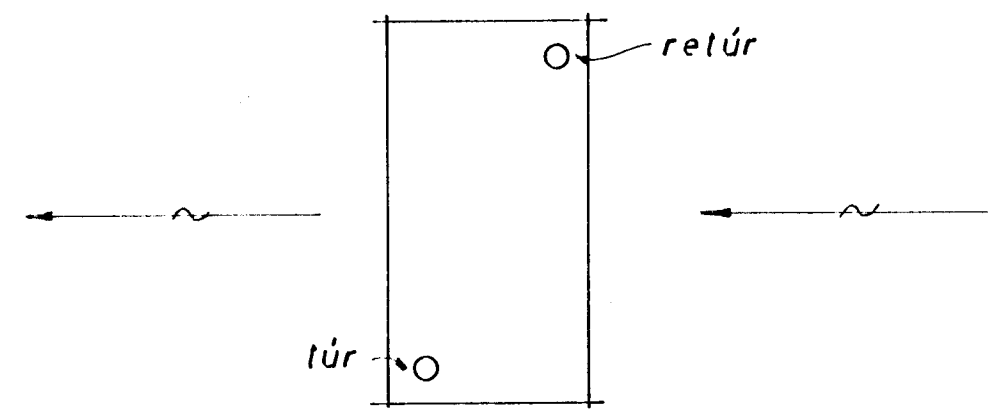

Tengingar í hitaklefa sjá teikn. 3A-90

- ①
- ②
- ③
- ④
- ⑤

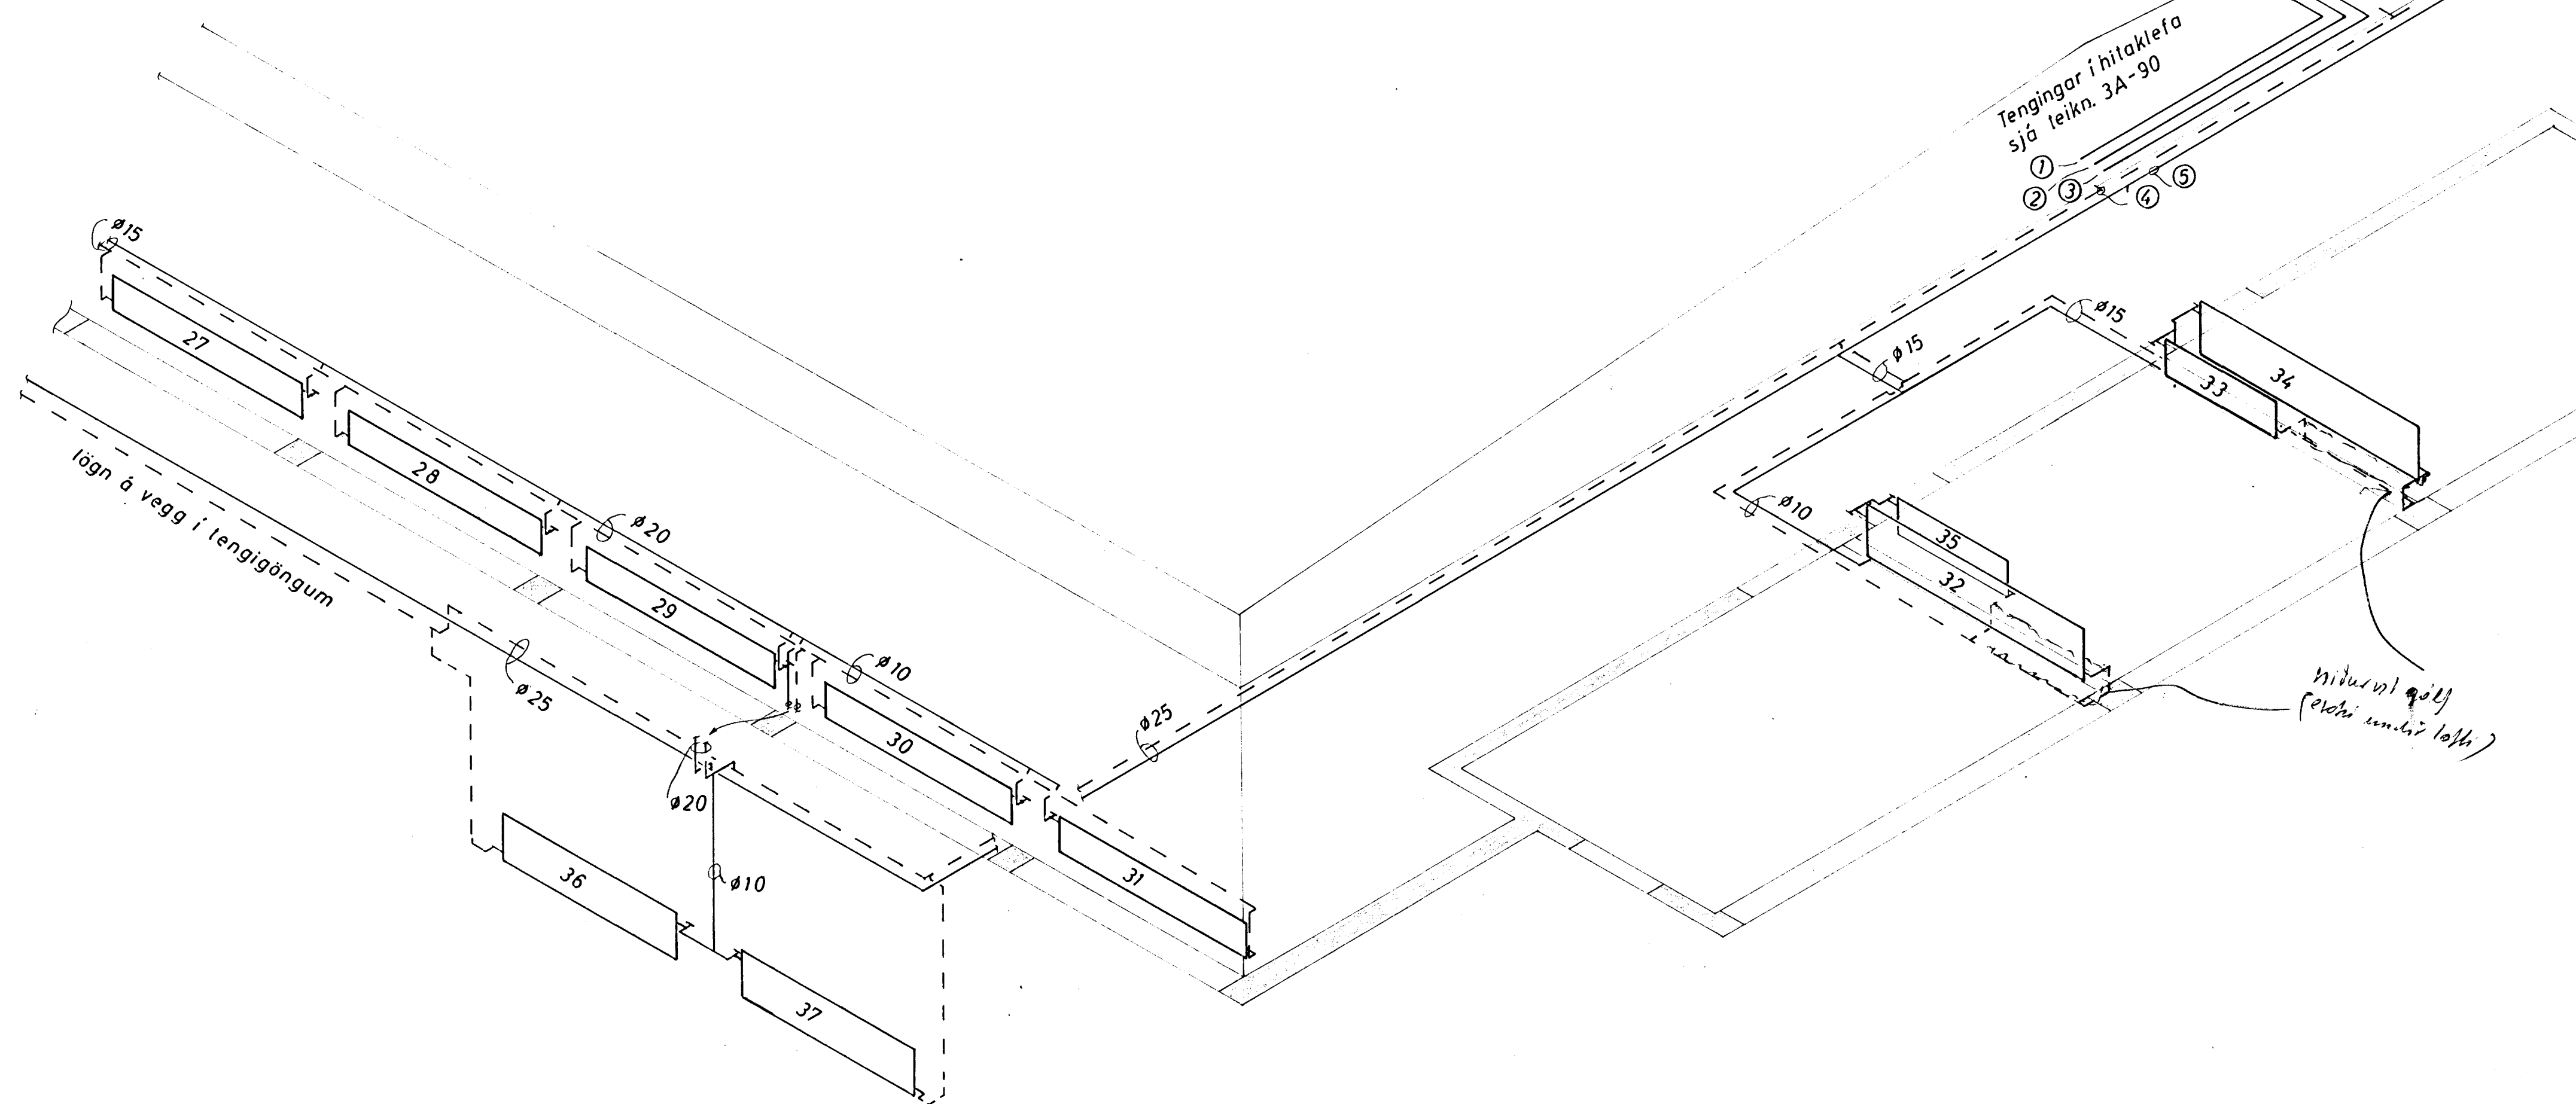

Fr.	Heiti		Hl.nr.		Tökn.nr.		Efn.		Alth.			
	Dags.	Loðbréttling	Dags.		Dags.		Dags.		Dags.			
Breyting												
VERKFRÆÐISTOFA GUDMUNDAR & KRISTJÁNS Laufáavegi 19 Sími 14426								Mhv.	Verkf.	11-74	1:50	1:50
VÍÐISTADASKÖLI, HAFNARFIRDI RUMMYND HITALÖGN								Dagbók nr.	TEIKNING NR.		3A-88	
								Verk nr.	Blöð of			