




Samþykkt þann

11 JUNI 2002


Byggingafultrúinn í Hafnarfirði
F.h. Sigurbjartur Halldórsson

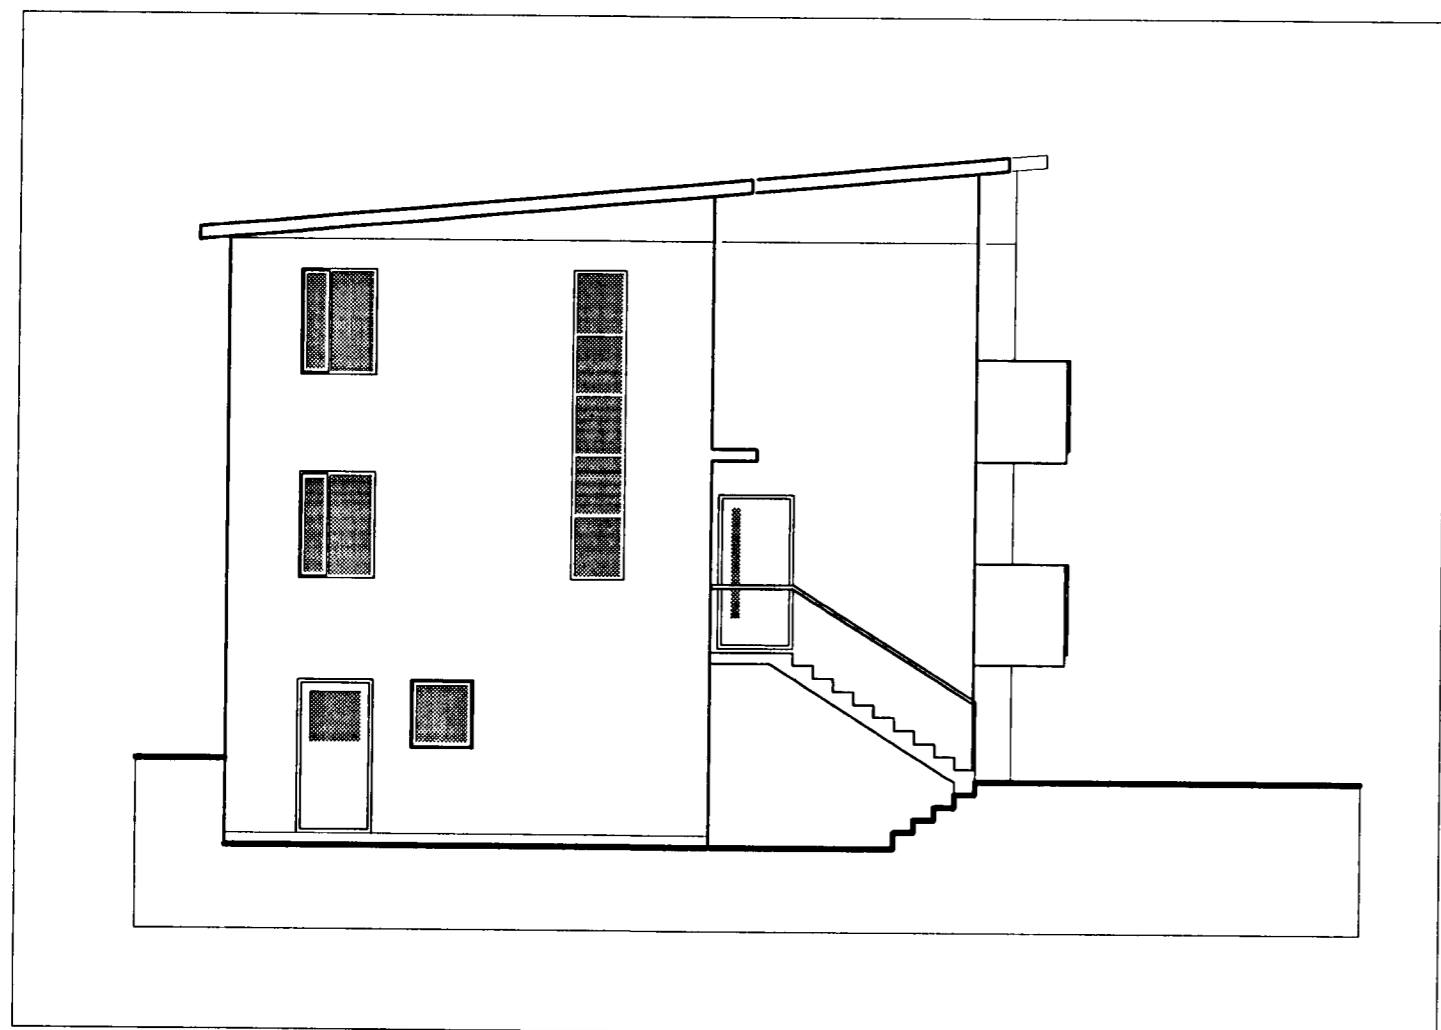


Útlit Norður 1:100



Útlit Vestur 1:100

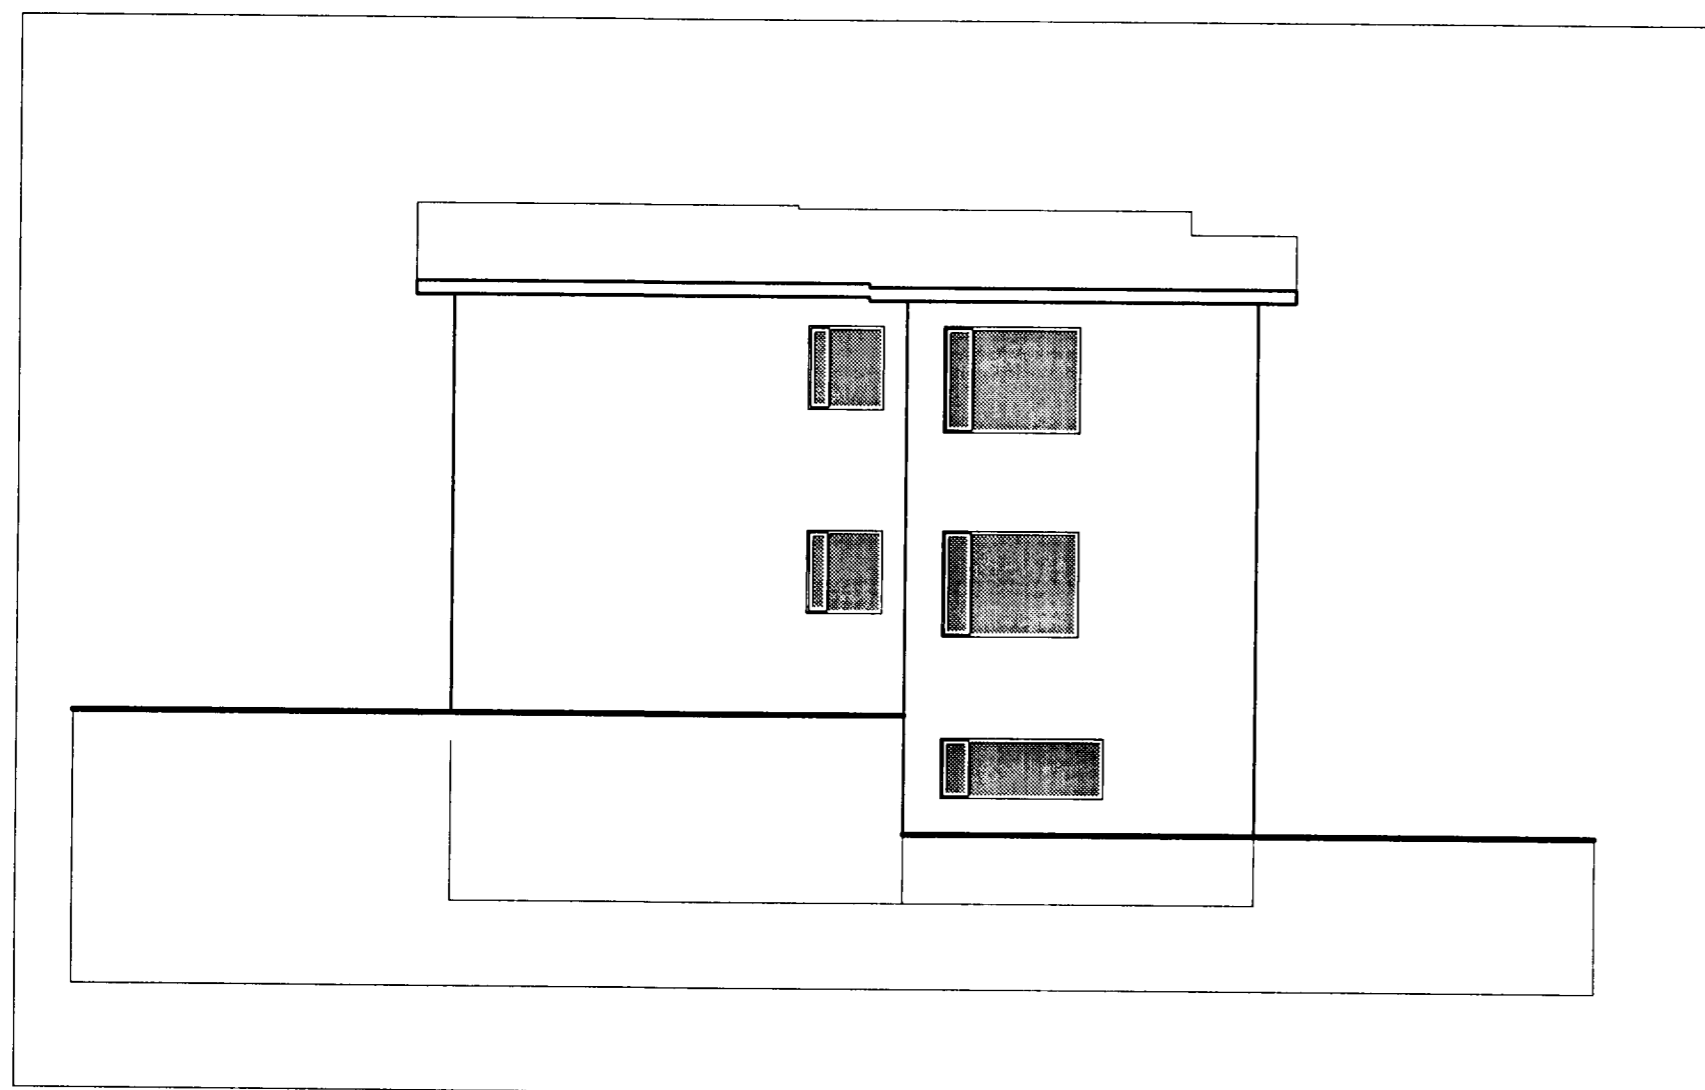

Útlit Austur 1:100

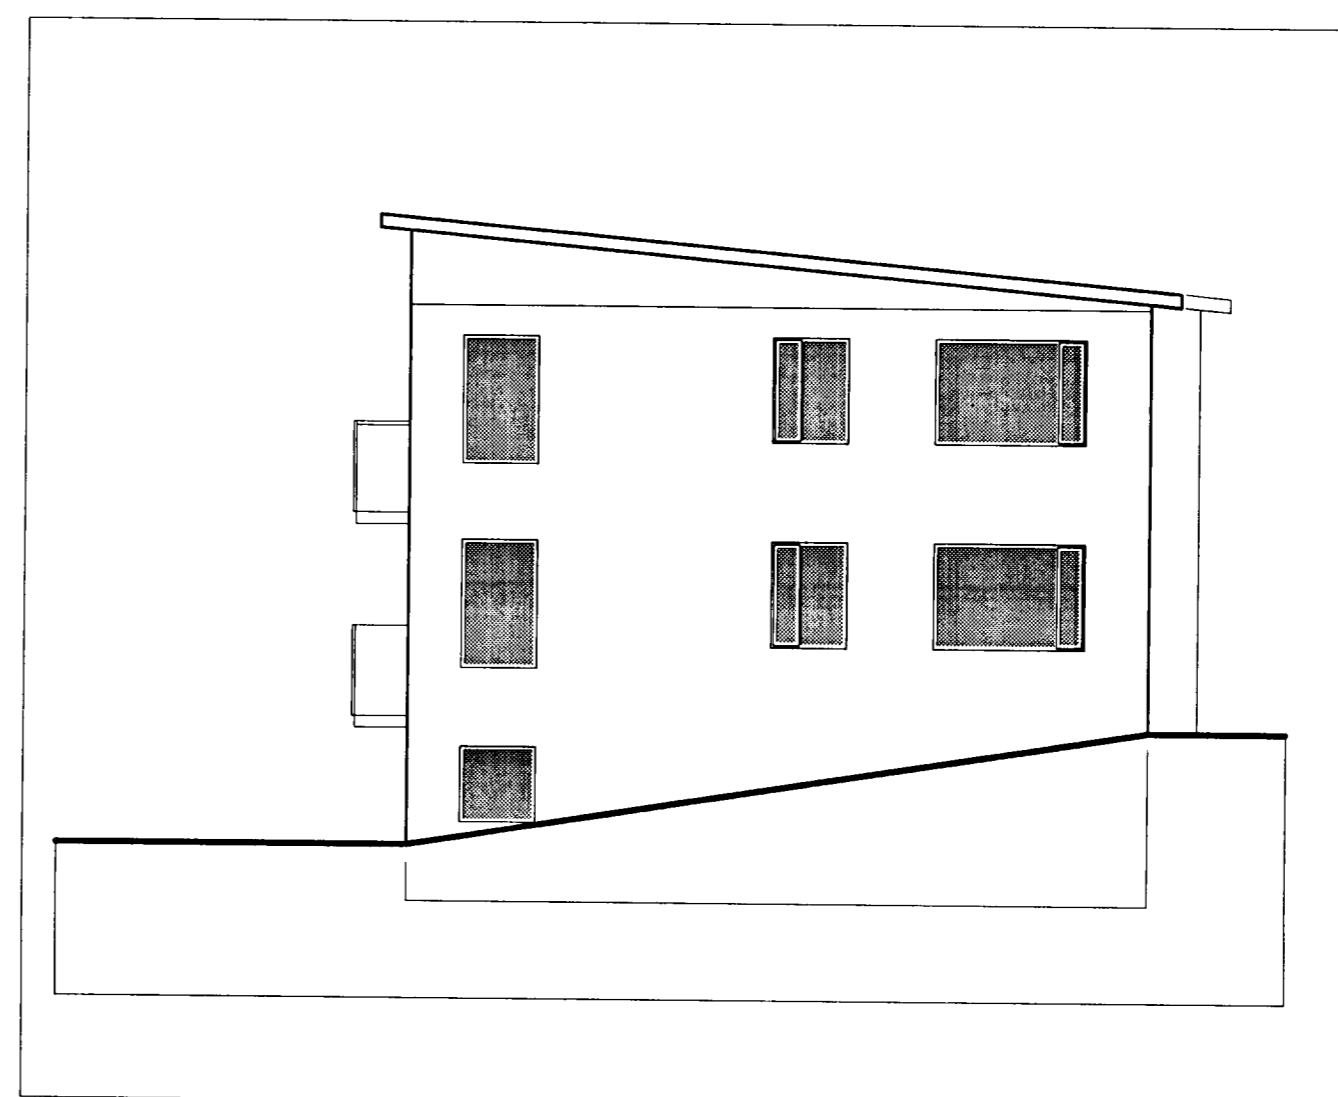

Útlit Suður 1:100

Reyndarteikningar

verkhæti

Hringbraut 31, Hafnarfirði

besta teikningar

Útlit

dagur
6.2.2002

m.v.
1:100

Nr.
A 103

Ársæll Vignisson Arkitekt
Strandgata 26-28
220 Hafnarfjörður 555 4795

Ársæll Vignisson