



Grunnmynd kjallara 1:100

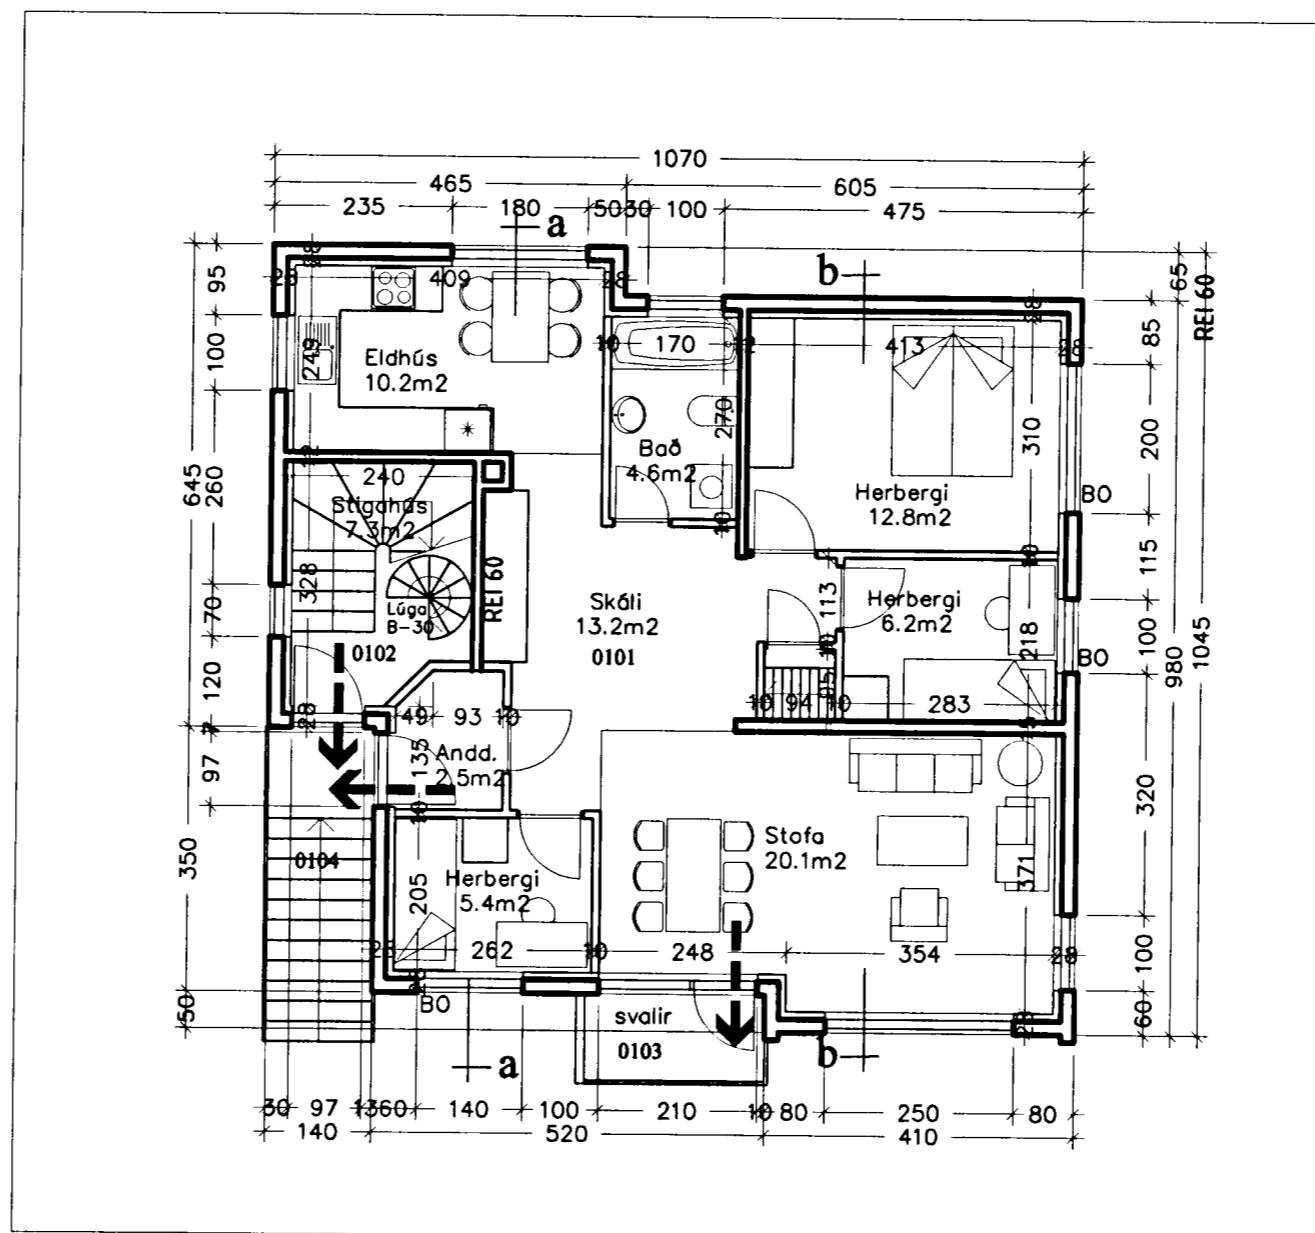

Grunnmynd 1.hæð 1:100

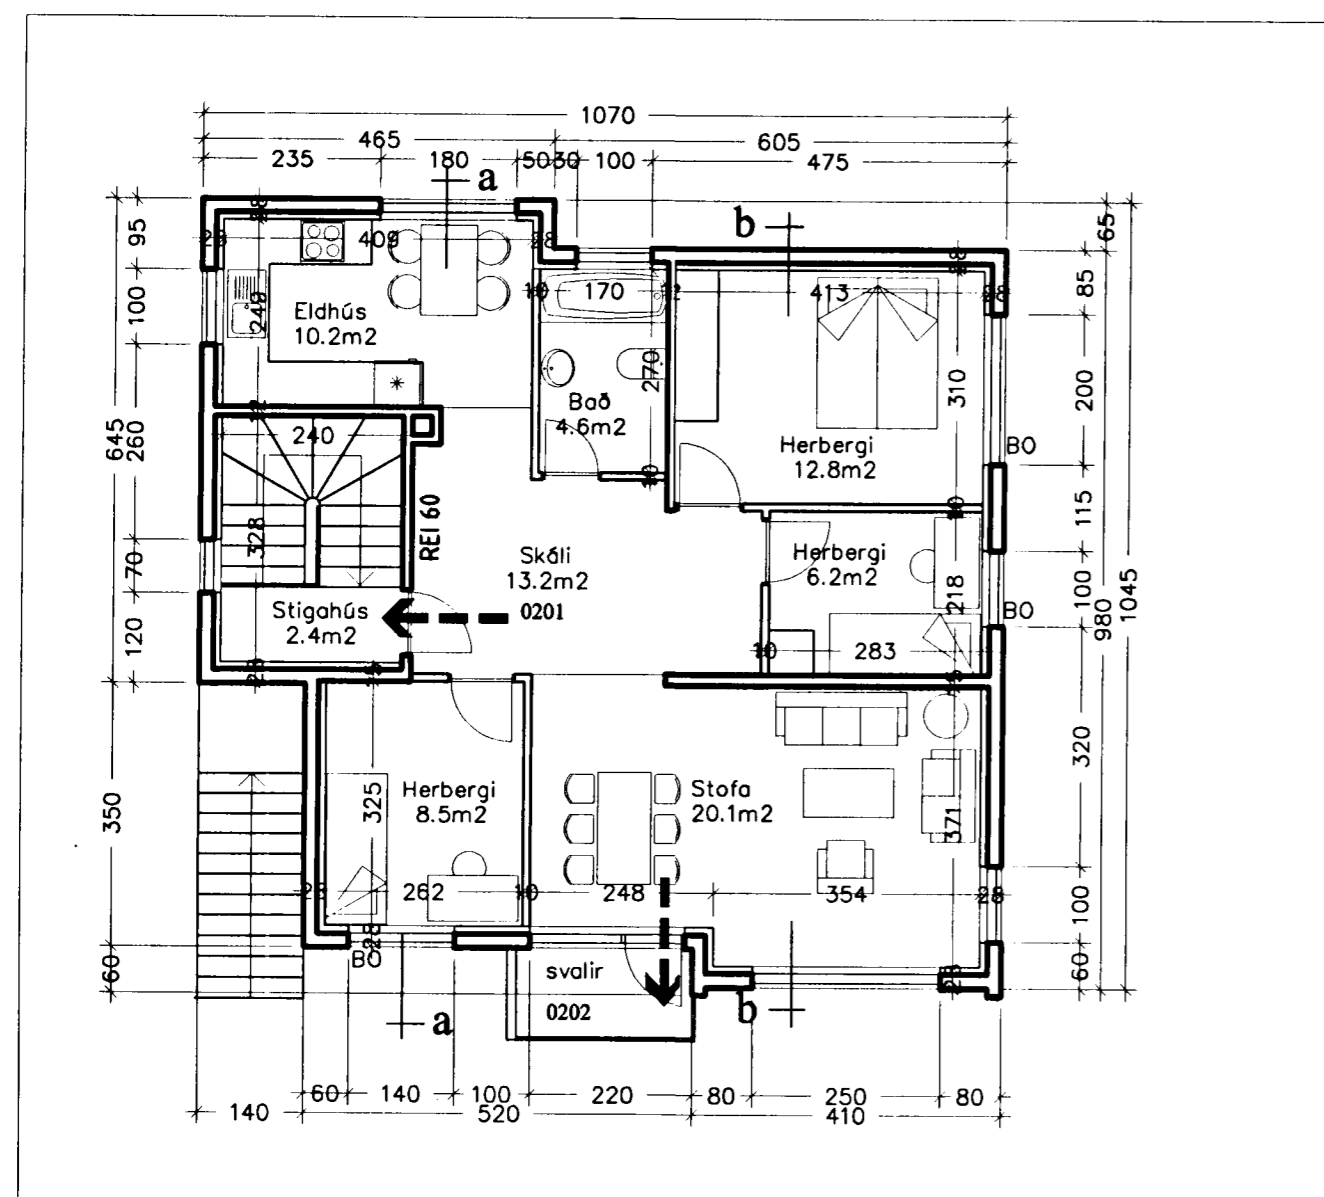

Grunnmynd 2.hæð 1:100

Reyndartekningar

verkhett
 Hringbraut 31, Hafnarfirði

heiti teikningar
 Grunnmyndir mív. 1:100
 dagi 6.2.2002 Nr. A 102

Ársæll Vignisson Arkitekt
 Strandgata 26-28 555 4795
 220 Hafnarfjörður

Ársæll Vignisson