


AFSTÖDUMYND 1:500

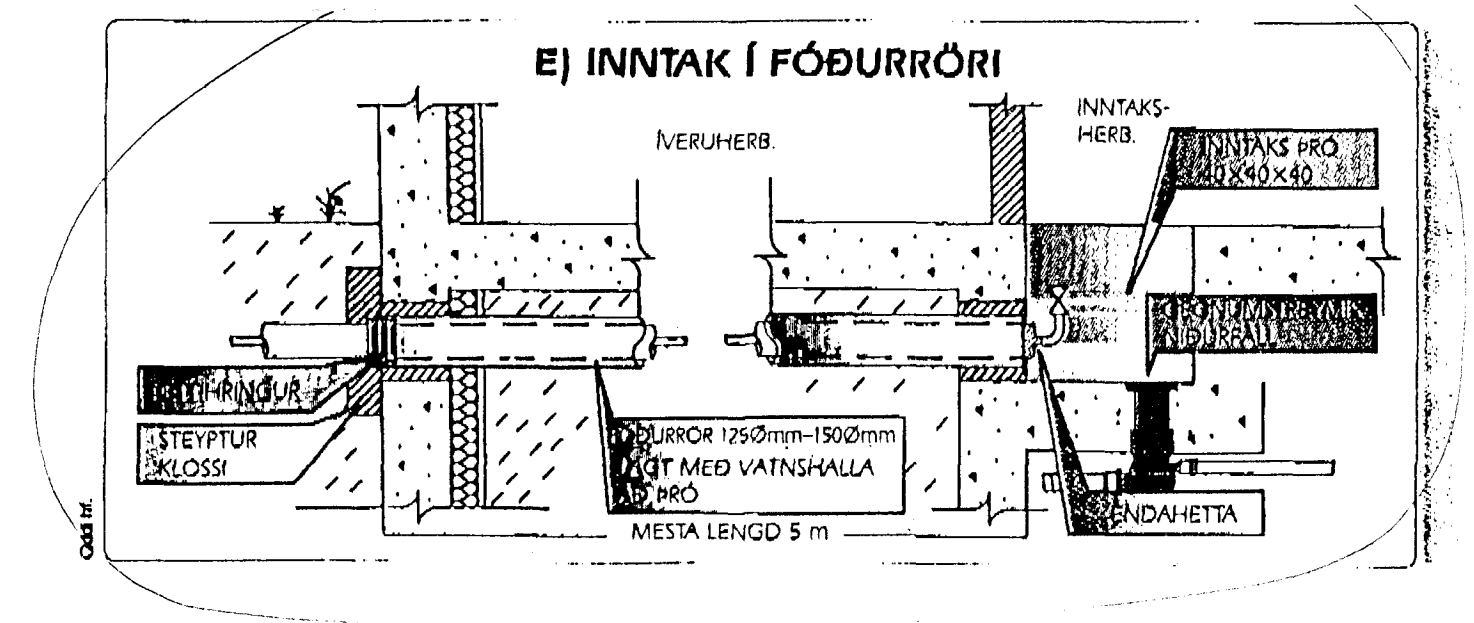

*Ösp. 17/10 95.
Vöta
stað inntaks. Kaldvata
Brunnar*

| | | | |
|----------------------------|-------------|----------------------------------|------------|
| VERKFRÆÐISTOFA | | HALDÓRS HANNESSONAR, S. 565-4355 | |
| | | DALSHRAUNI 13, 220 HAFNARFJÖRDUR | |
| MKV.: 1:50 | REIKNAD: HH | TEIKNAD: PVB | YFIRF.: HH |
| HRINGBRAUT 41, HAFNARFIRDI | | FRÆNNISLAGNIR | |
| LAGNIR Í JÖRD | | 13/10 95 | |
| VERK: | BLAD: 2.01 | DAGS: 17.09.1995 | |