

INNTAK VATN Ø 32 PEH

Ø 100 P 40‰


23.33

BRUNNUR Ø 600

ELDKI LÖGN

Ø 150 ST

GRUNNMYND 1:50

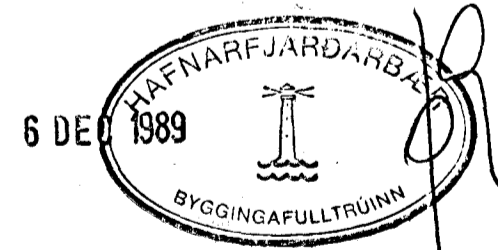

DR. NR.	1	DAGS.	17.10.89	LEGD LAGNA BÆTT	SIGN.	4.21.
HRINGBRAUT 42 HAFNARFIRÐI			EÐLI BÆYTINGAR		DAGS. OKT. '89	
GRUNNLAGNIR: GRUNNMYND - AFSTÖÐUMYND.					HANNAÐ 4.21.	
MELIKV. 1:50 + 1:500.					TEIKNAD 9.26.	
SIGURÐUR ÞORLEIFSSON			TEKNIFRÆÐINGUR F.T.F.I.		VERK NR. 8936	
STRANDGÖTU 11 HAFNARFIRÐI			SÍMI 54781		BLAD NR. 2-01A	