




SJA HUGA - í bókun -

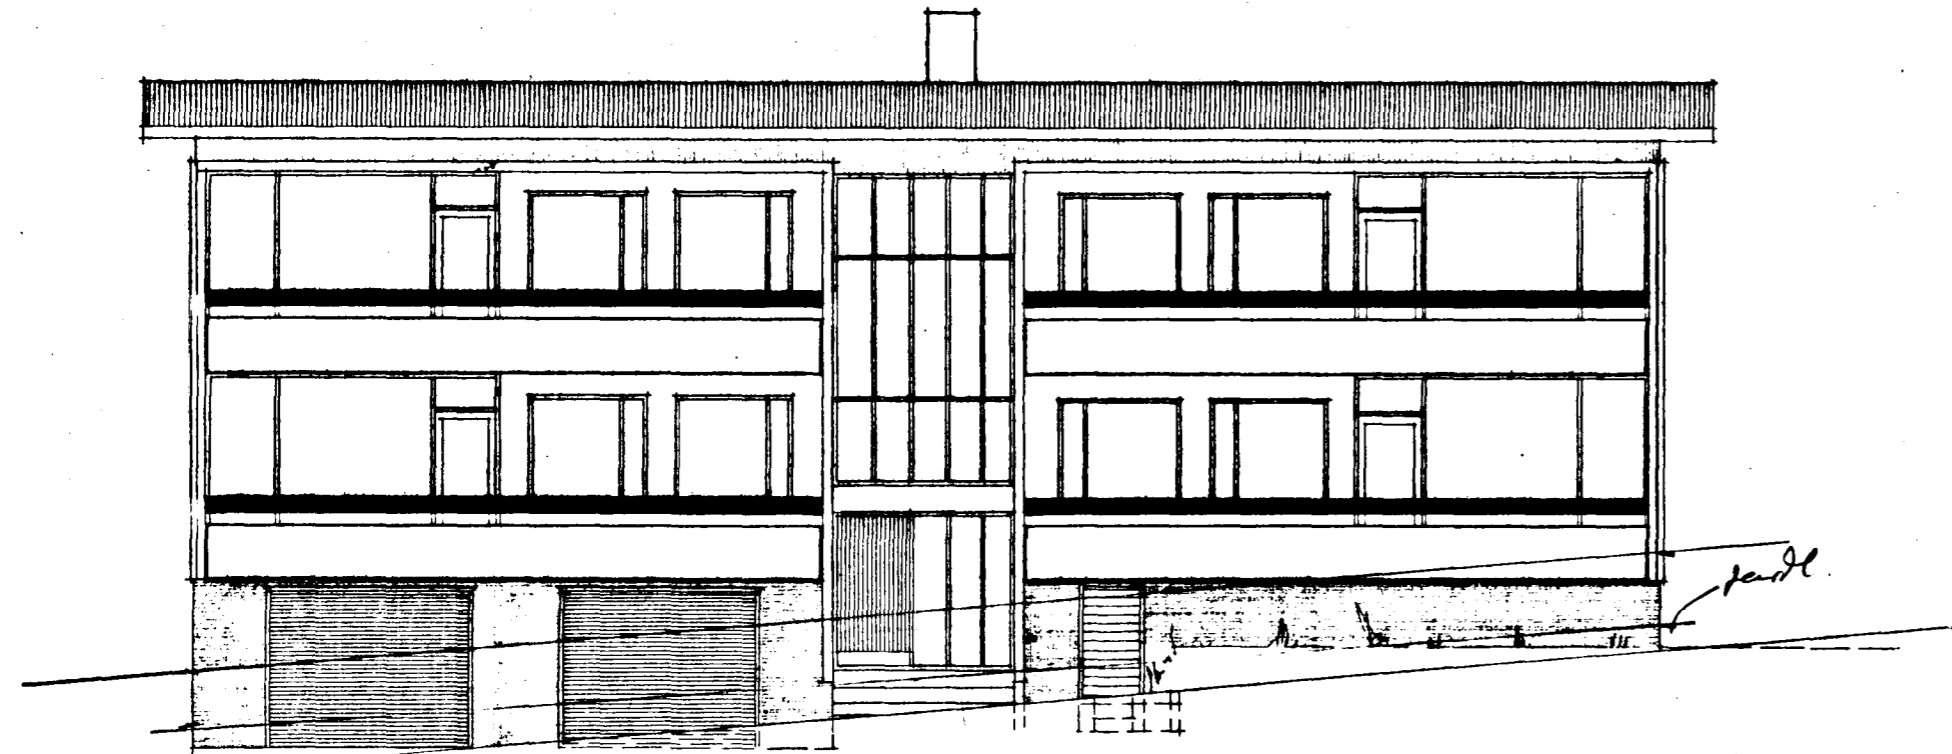


SUD-AUSTUR

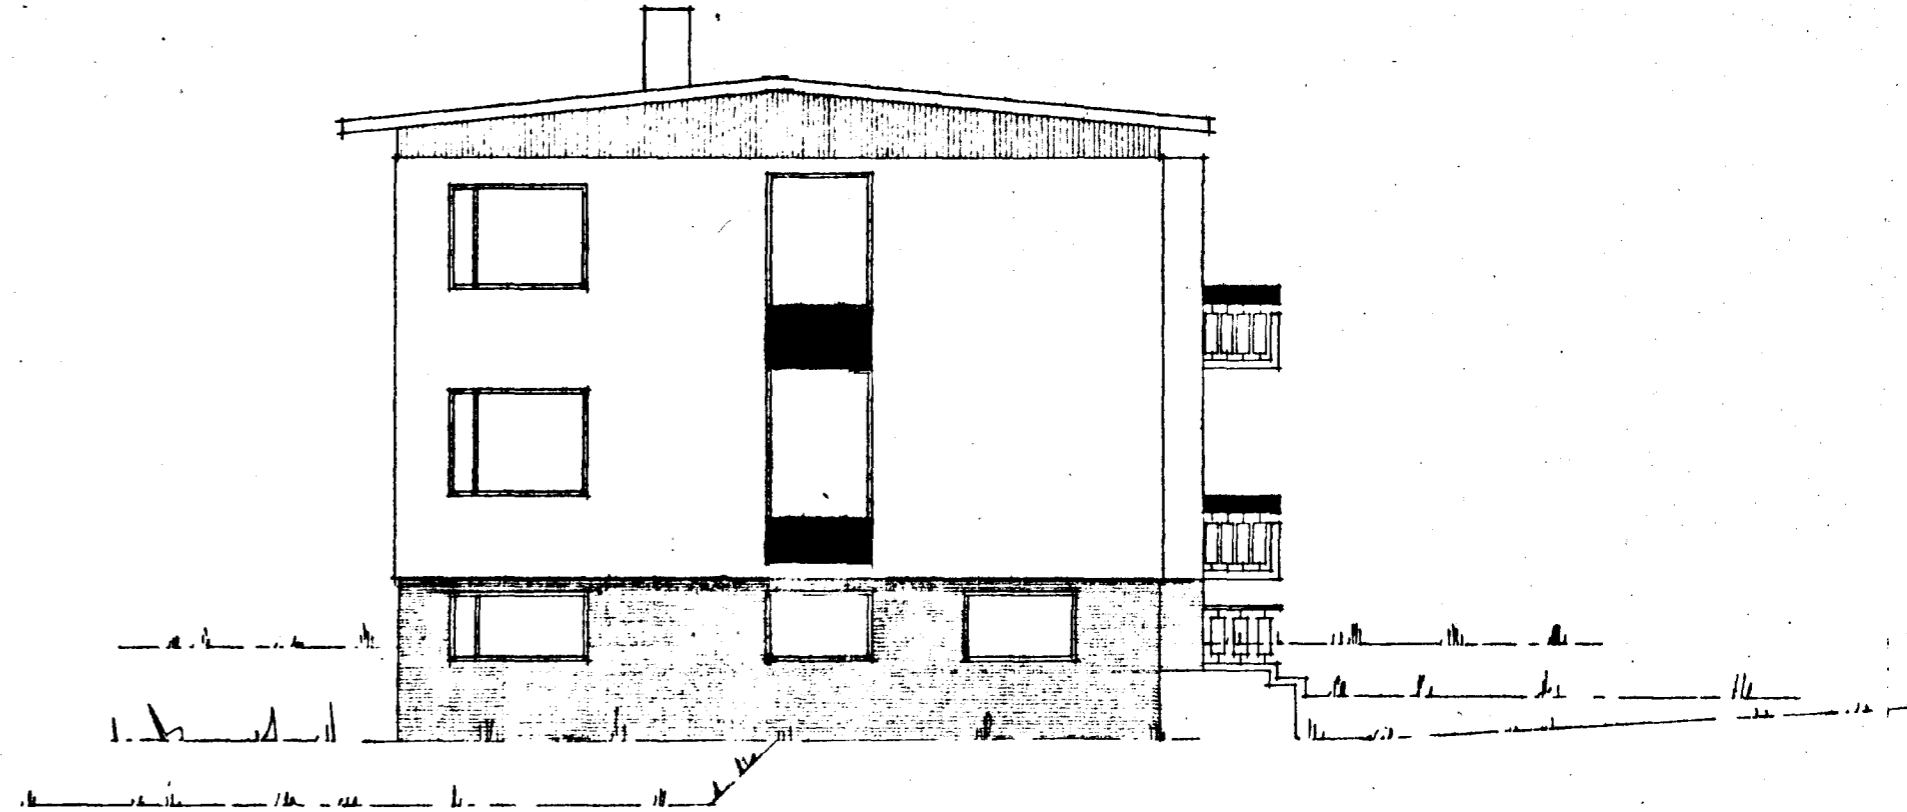

SUD-VESTUR

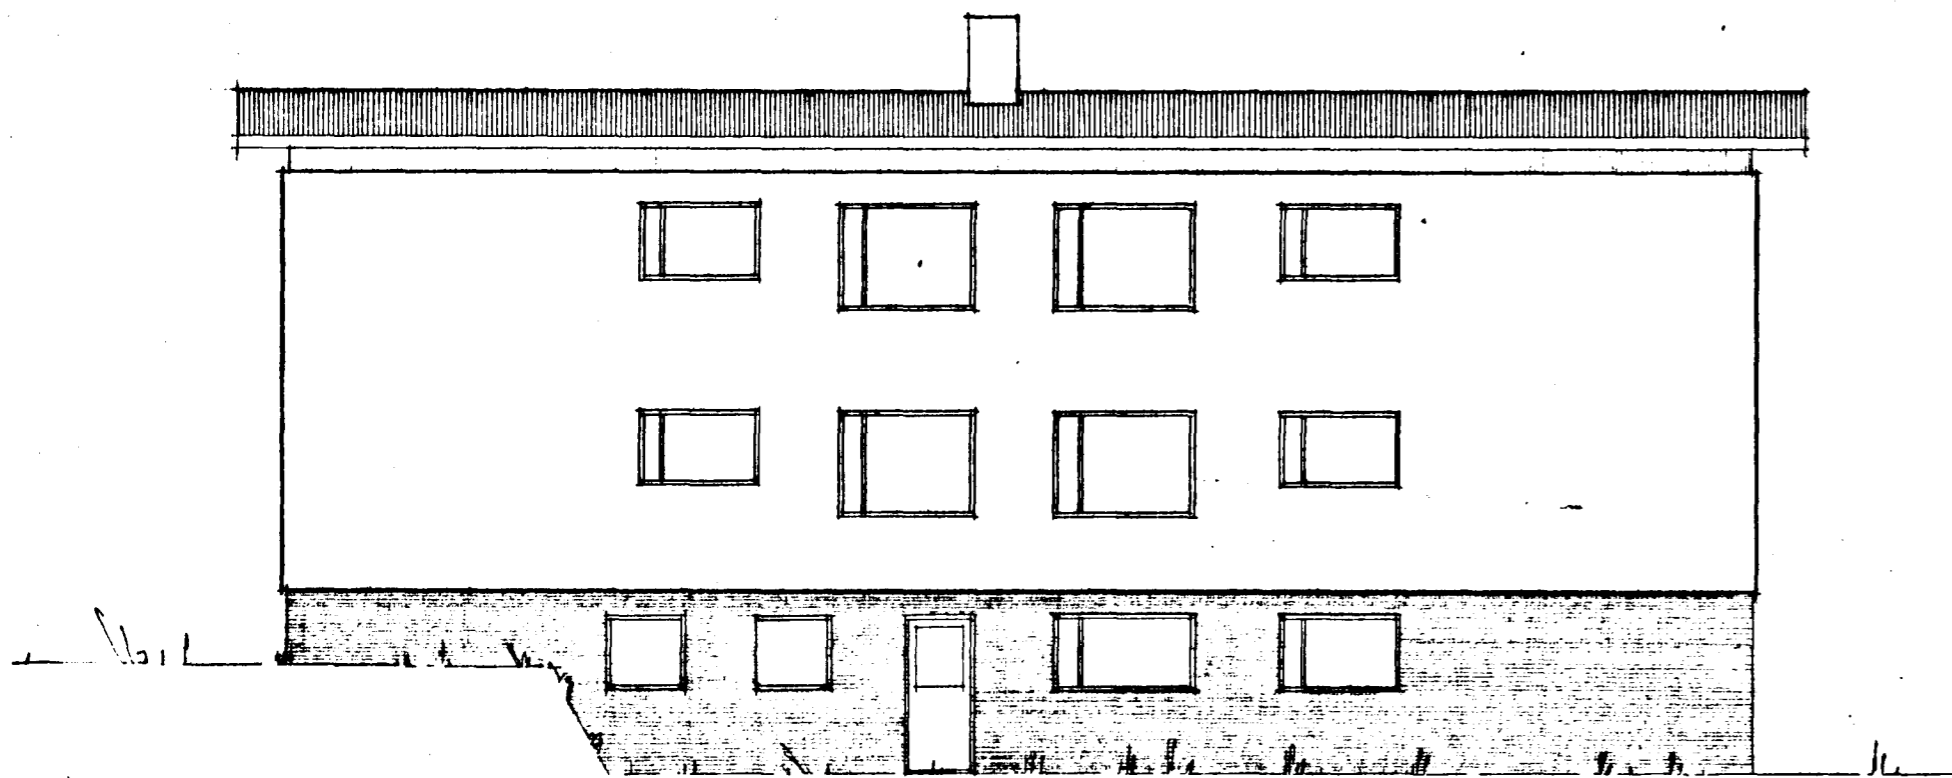

NOED-VESTUR

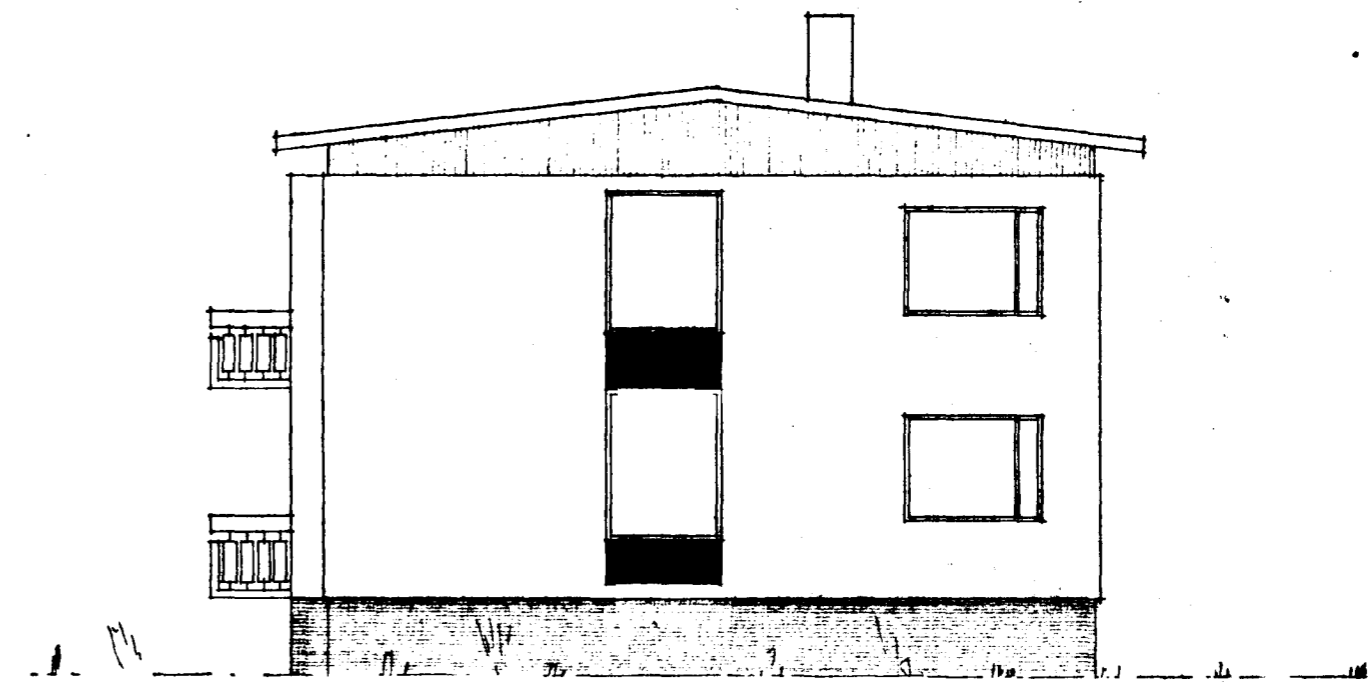

NOED-AUSTUR

VERKENEI HRINGBRAUT NR. 63	MÁL. 1:100	DAGS. MAY 68	NR.
HAFNARFIRÐI	TEIKN.	BR.	
TEIKNISTOFA KJARTANS SVEINSSONAR SKÚLAGOTU 63 SÍMI 16534		SAMP. <i>yfjartan Sveinsson</i>	