


Sjá áthugasemd á bláði 1



Þrjúþykkt 6 fundi bygginga-  
ráðgjafar p. 6/3 1968

BYGGINGARÁÐGJAFURINN  
HAFNARFIRÐI  
P. Sigurðsson

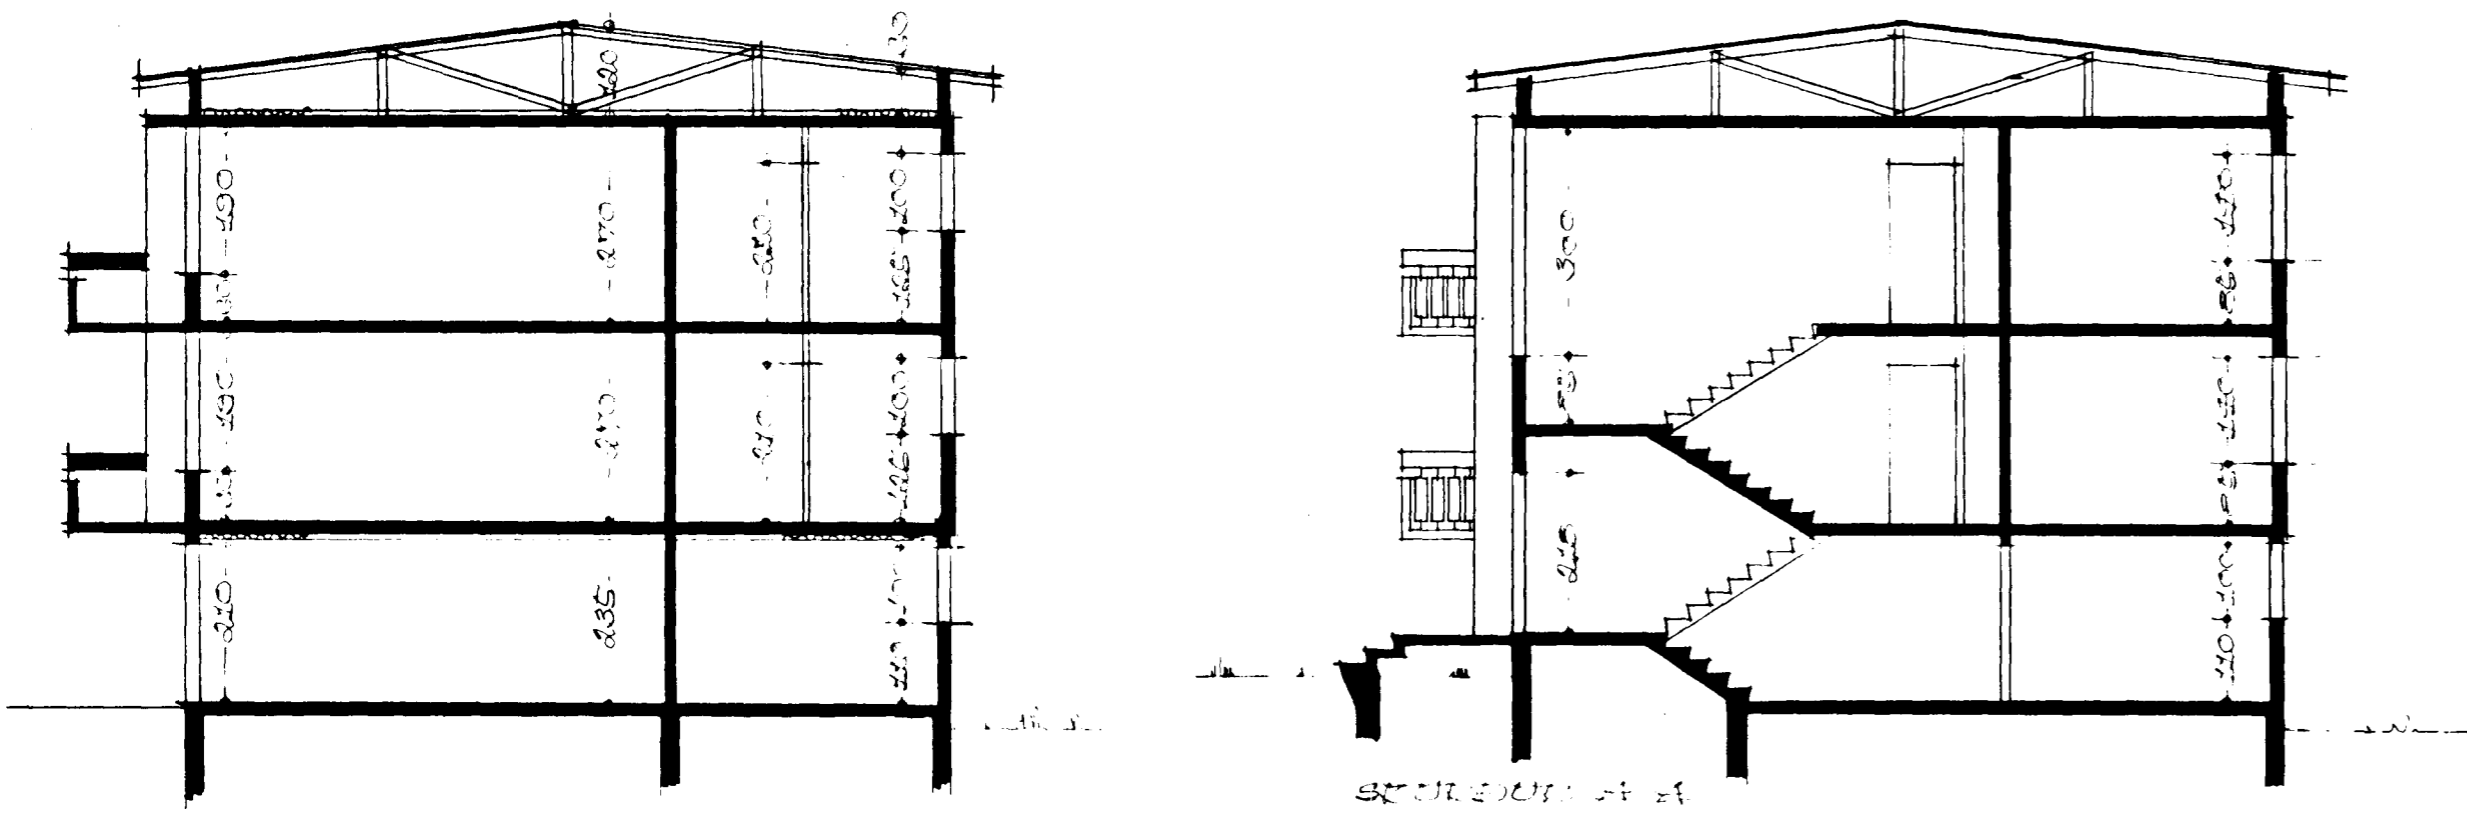


SKURDUR E. B


SKURDUR A. A

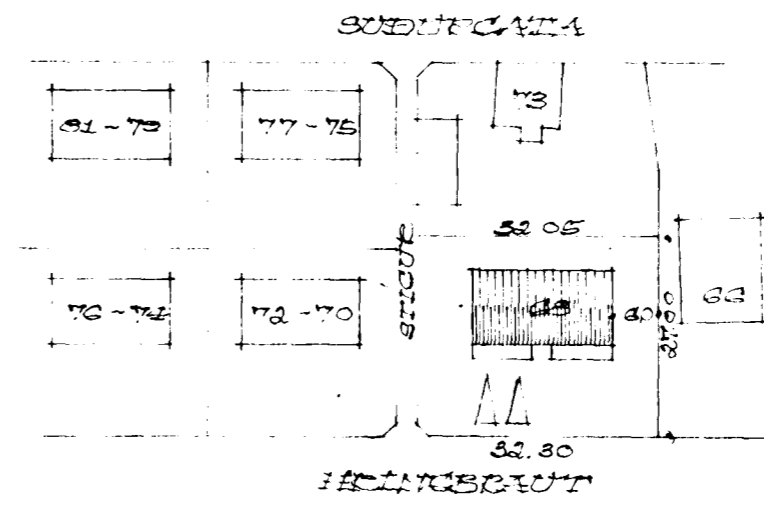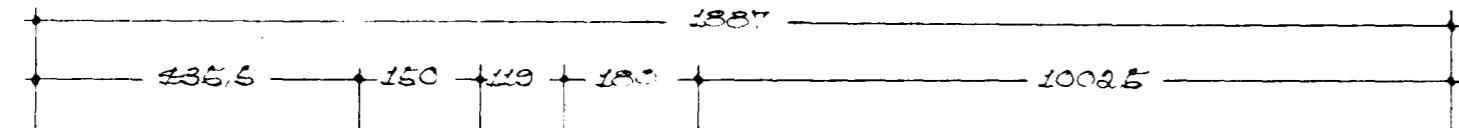



FRINGBRAUT M 1:100  
FLATARMÁL HÚSS 193.93 M<sup>2</sup>

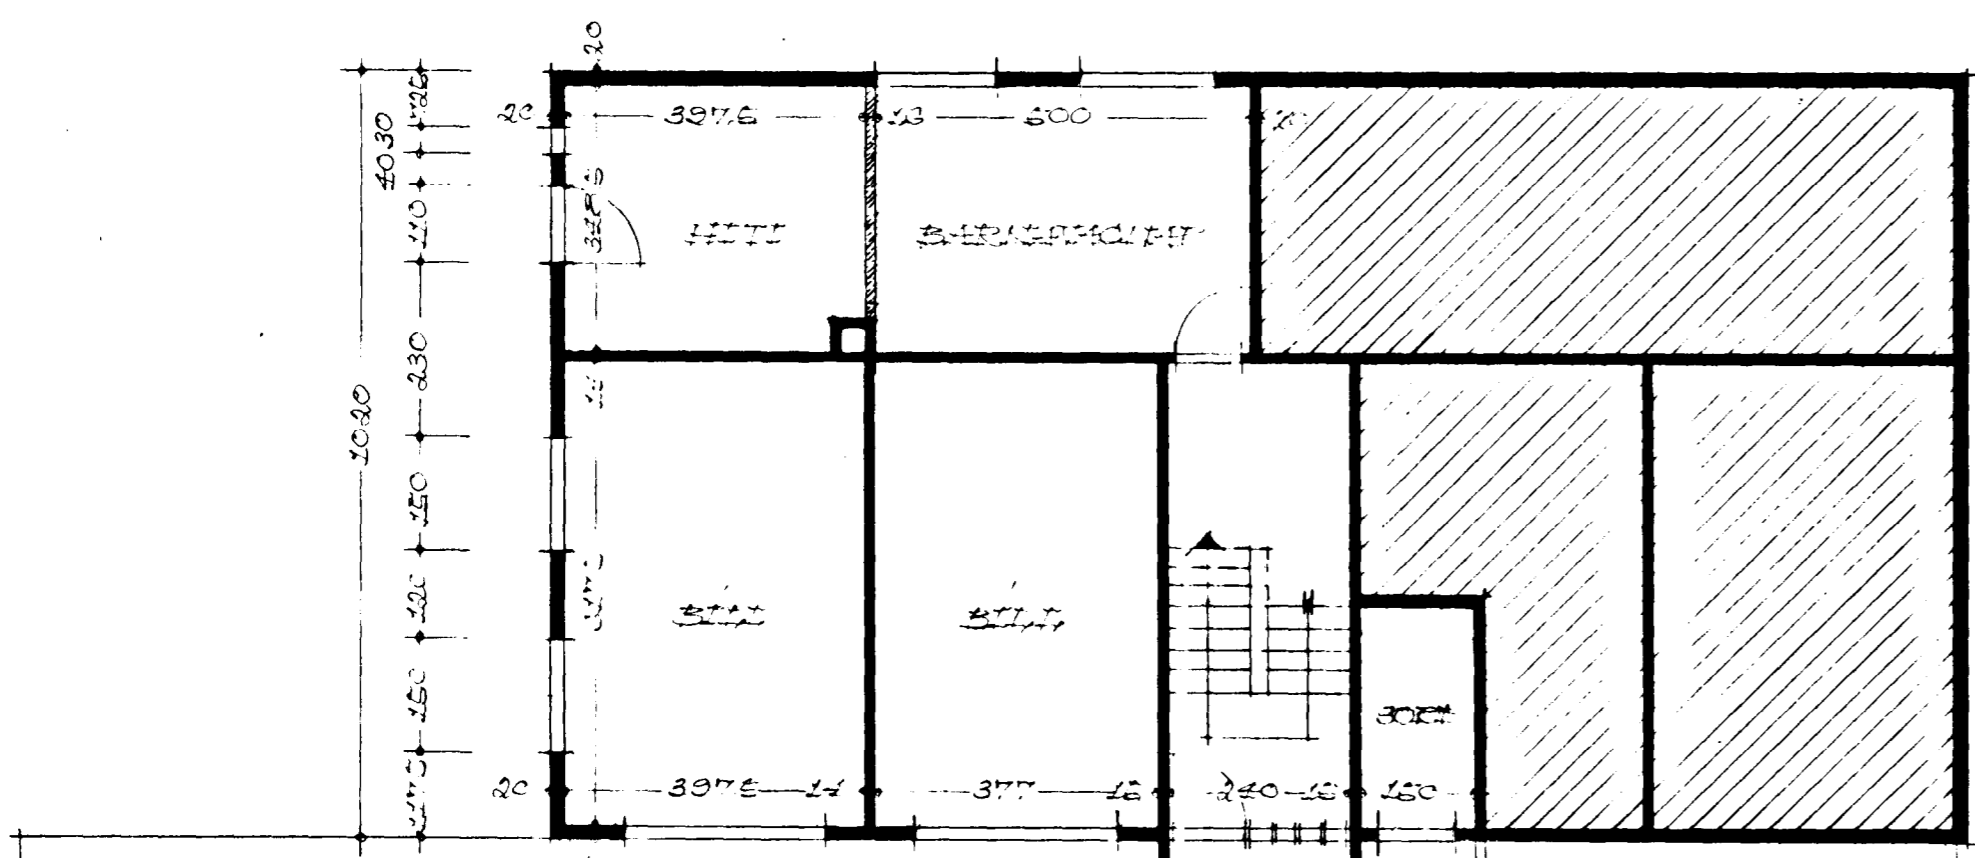

FRINGBRAUT 1-2. HÚSD

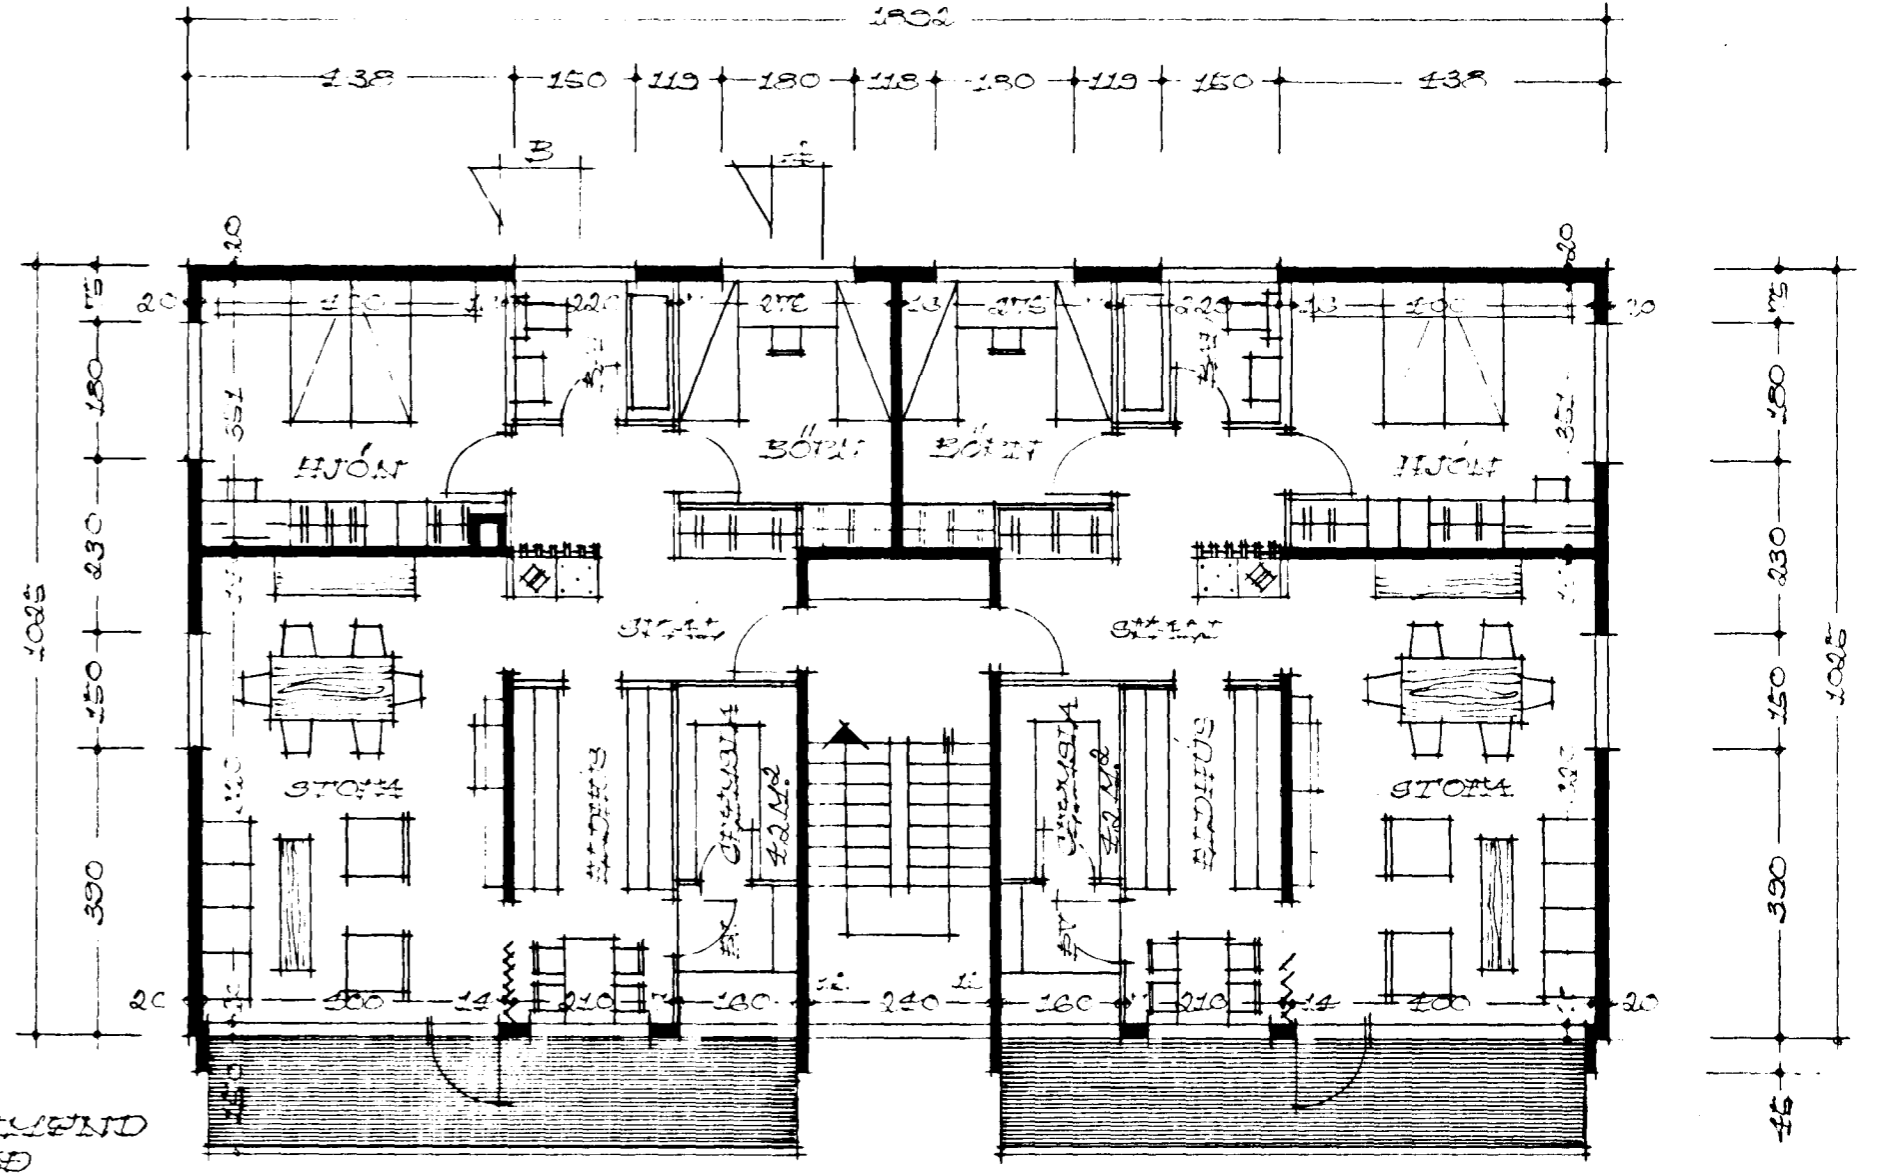

FRINGBRAUT 1-2. HÚSD

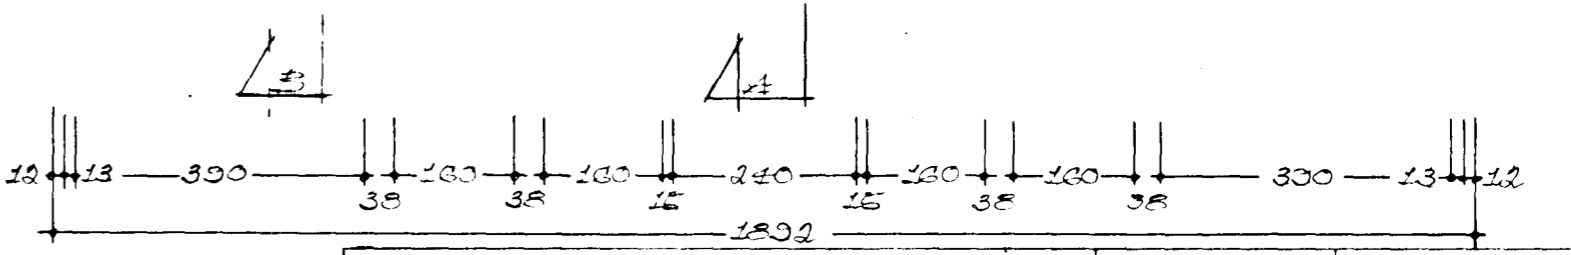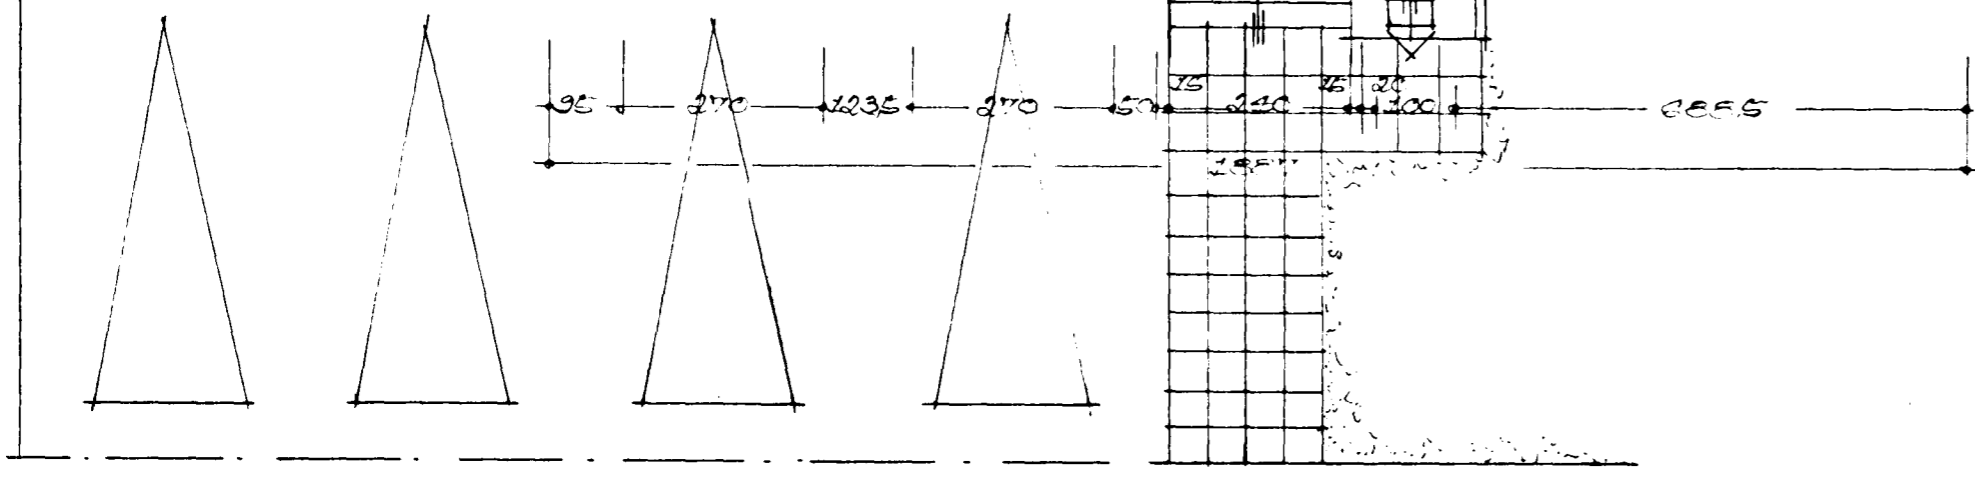

|  |              |                 |          |
|--|--------------|-----------------|----------|
| VERKEFNI<br>FRINGBRAUT NR. 65                            | MÁL<br>1:100 | DAGS.<br>MÁR 68 | NR.<br>2 |
| TEIKN.   | BR.          |                 |          |
| SAMP. <i>P. Sigurðsson</i>                               |              |                 |          |
| TEIKNISTOFA KJARTANS SVEINSSONAR SKÚLAGOTU 63 SÍMI 16534 |              |                 |          |