




Húsið Hringbraut nr 75  
 Eig. Sigmundur Bjarnason  
 Mál 1:100

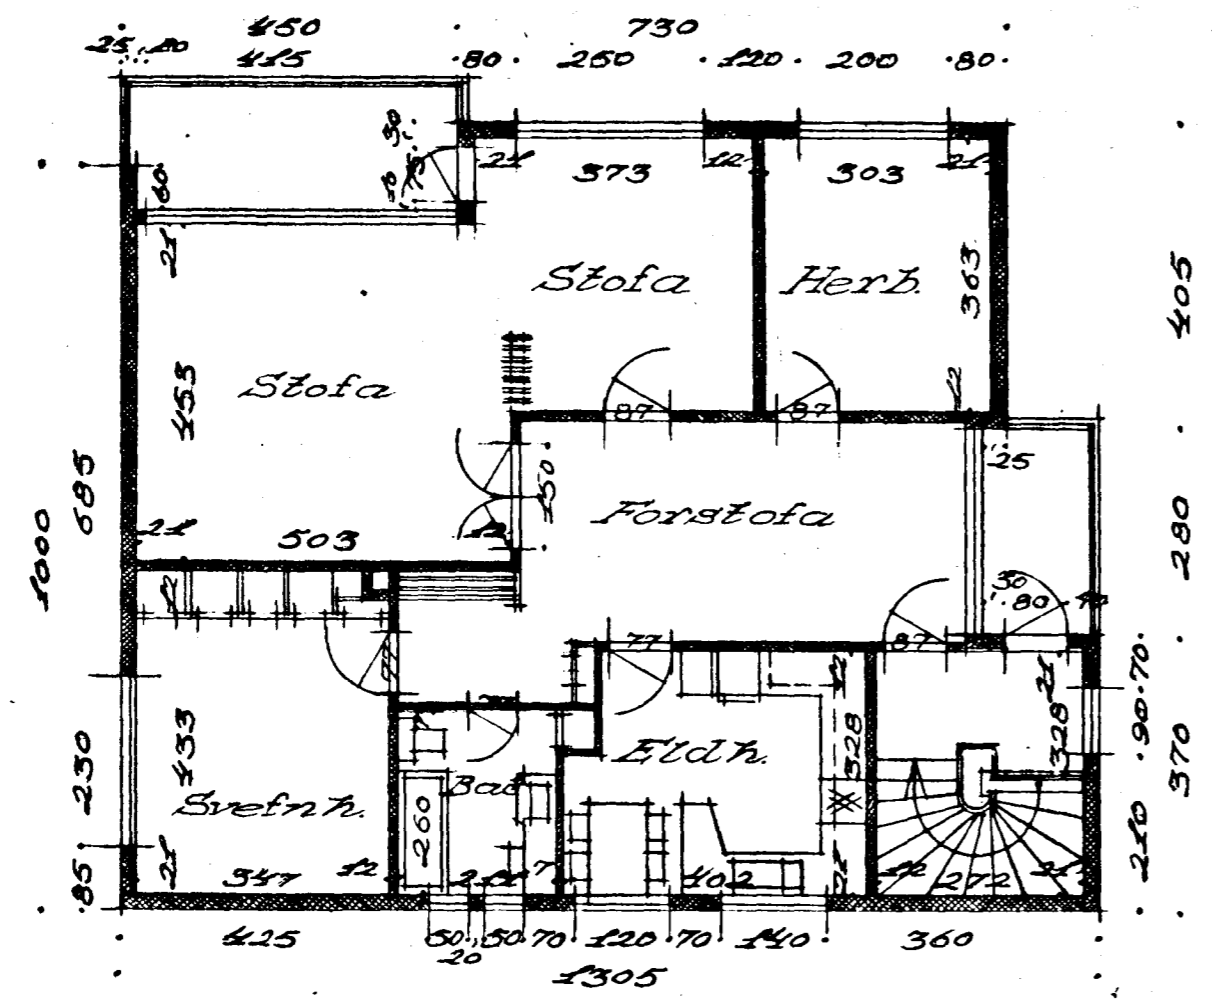


2. Hæð

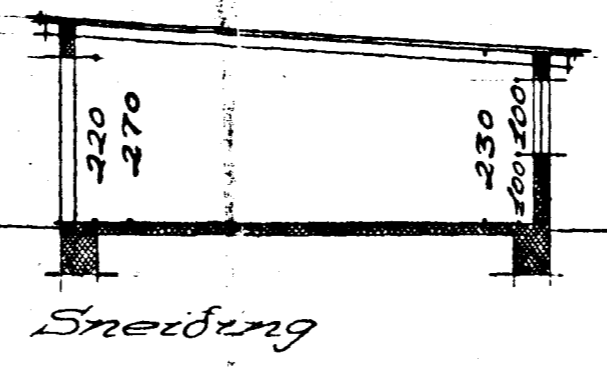

Sneidning

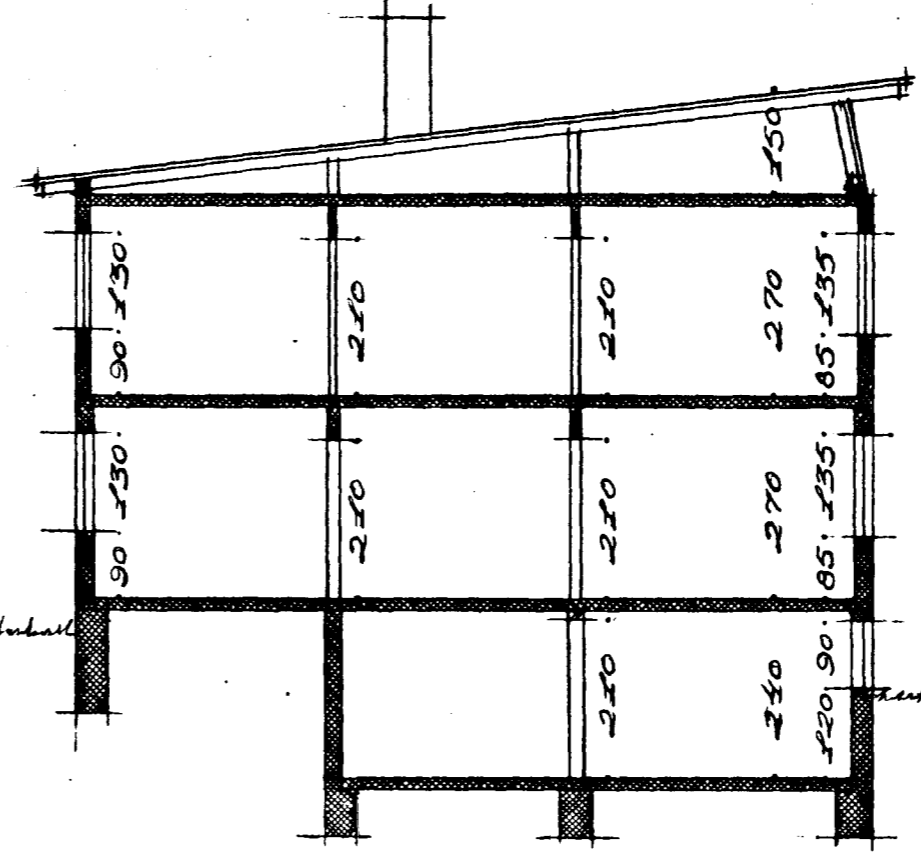


Sneidning

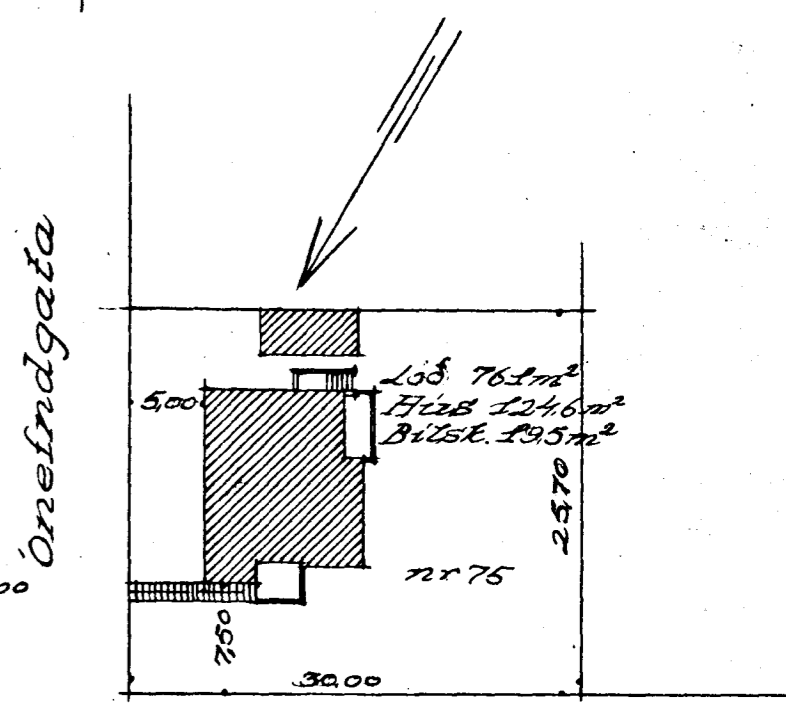

Hringbraut


Afstöðumynd 1:500

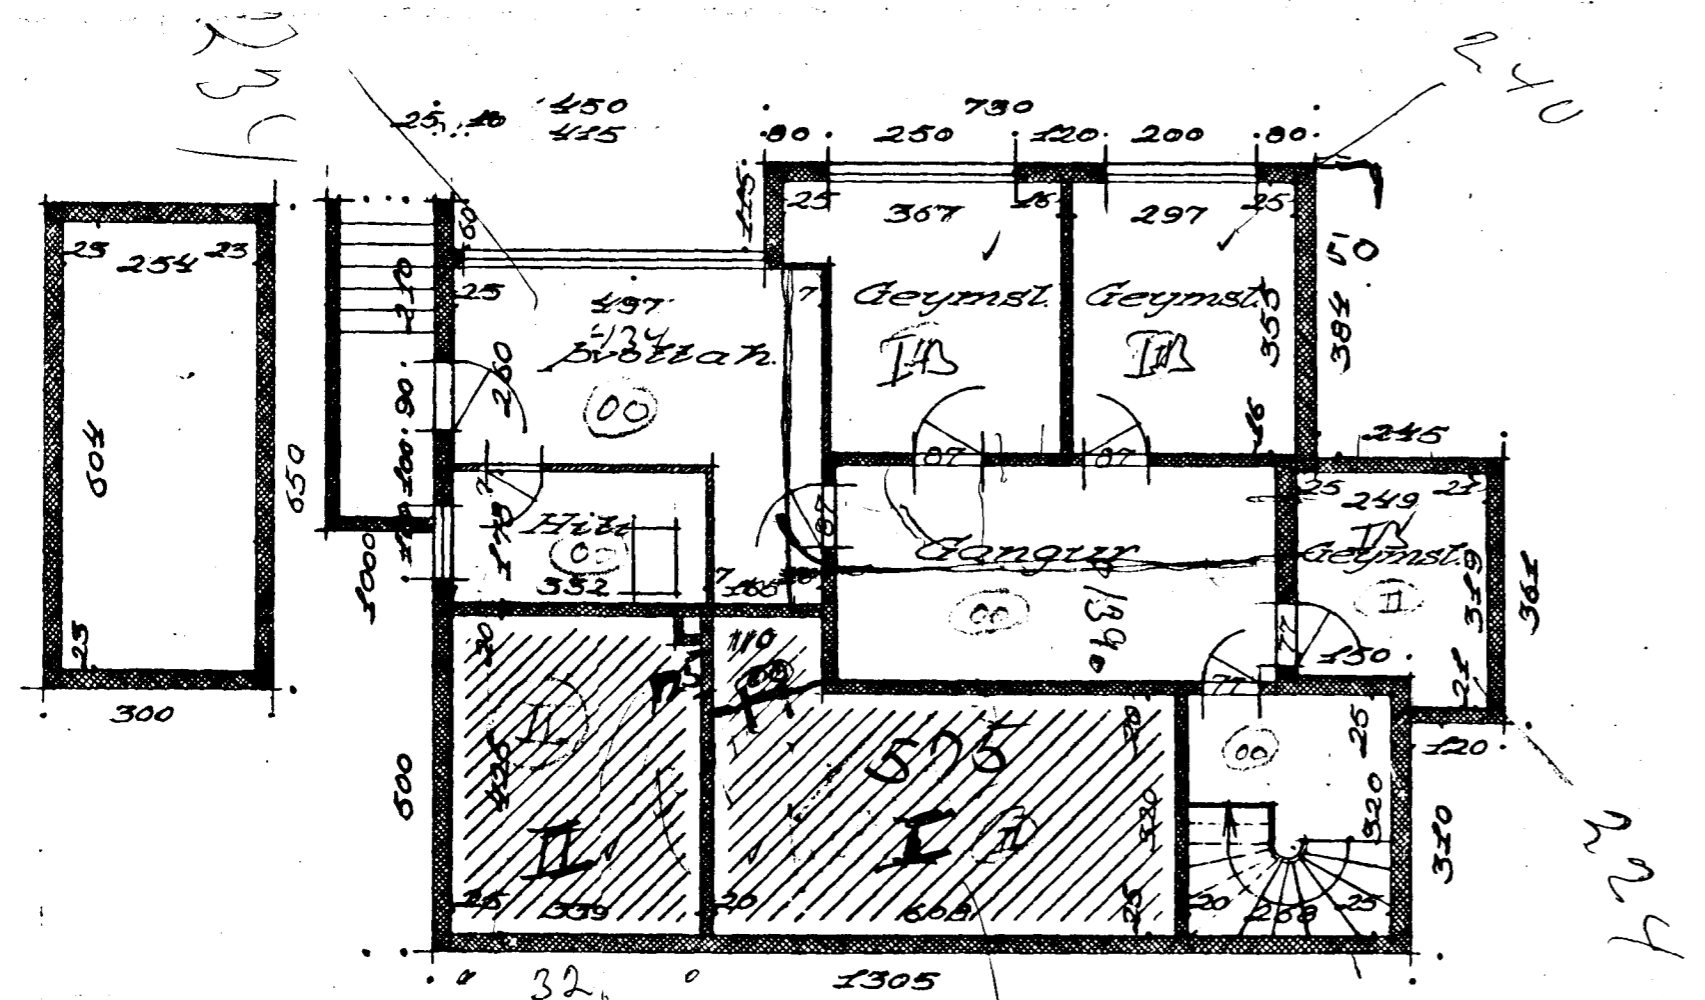

Kjallari

12.55

2.34

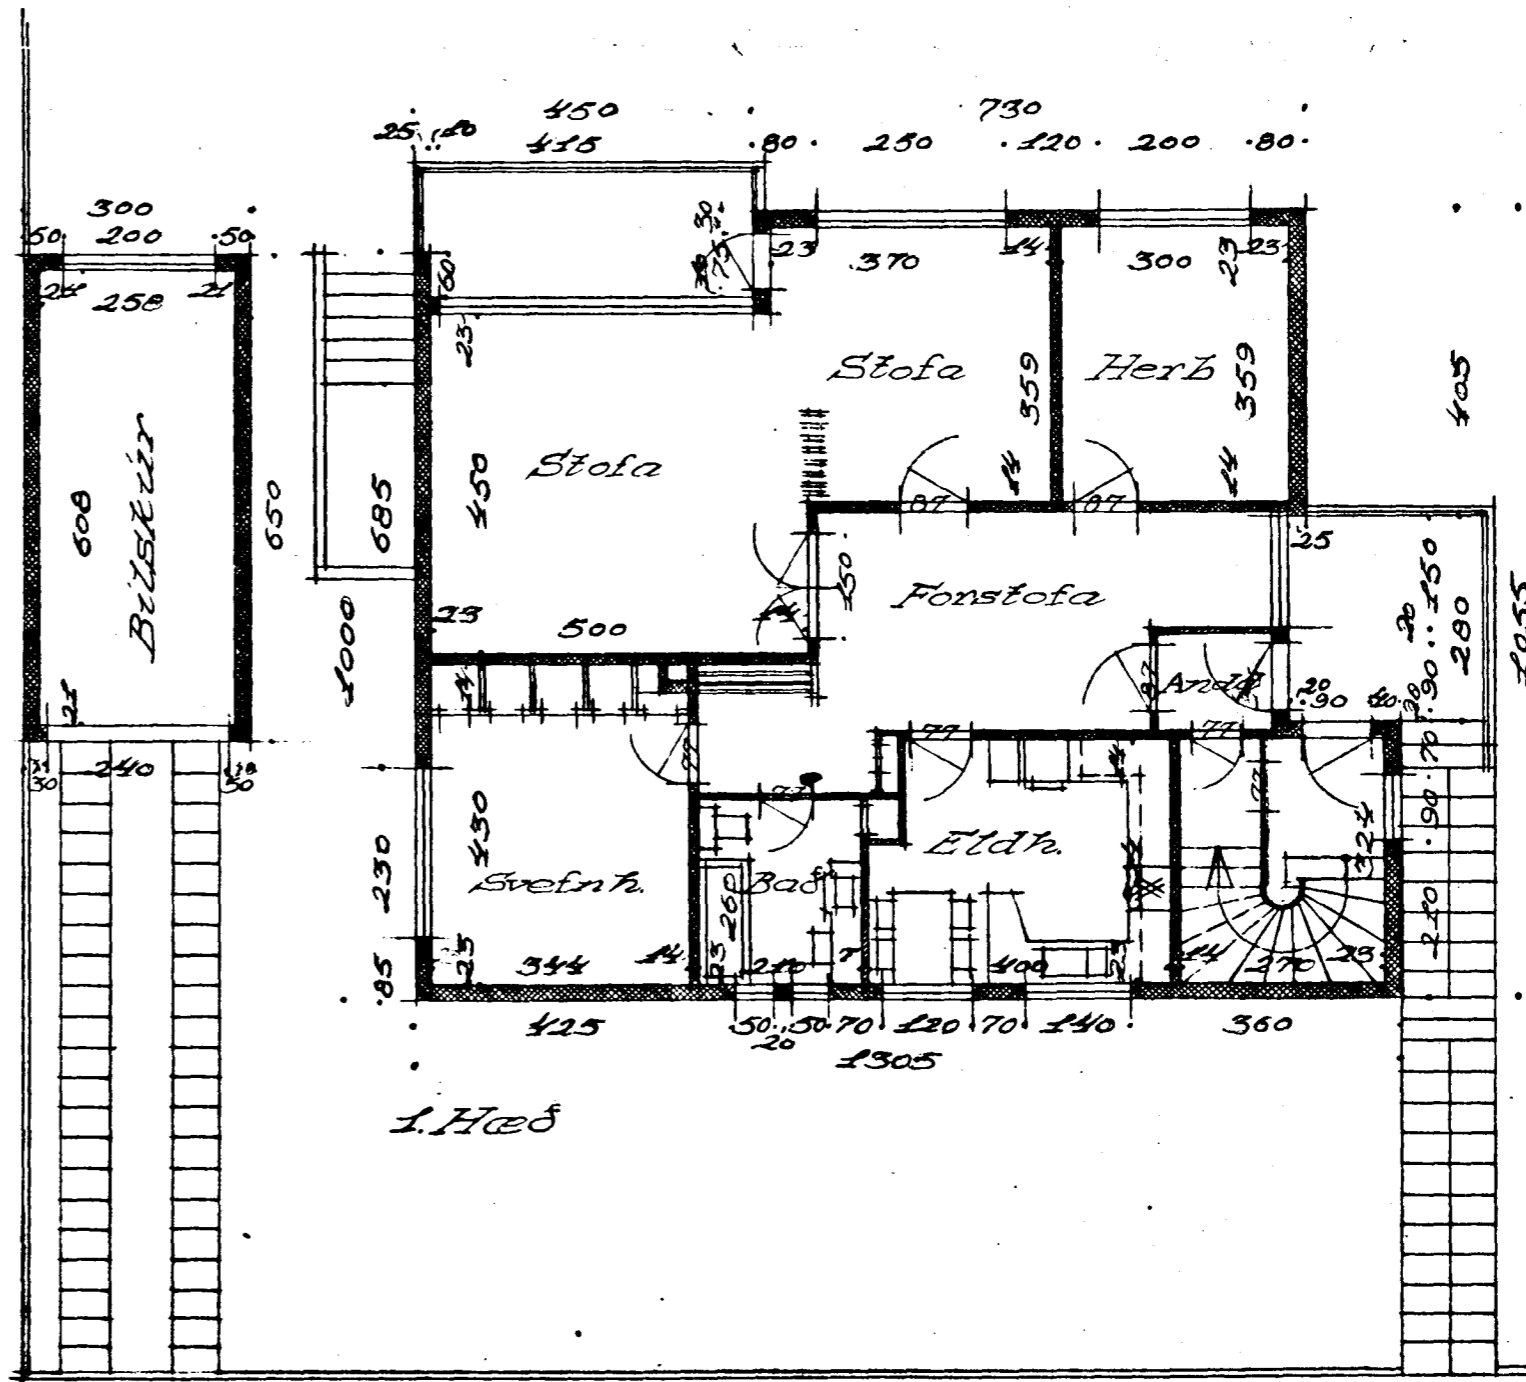

1. Hæð