


BREYTT 4. DES. 1987.  
 BREYTT 12. MÁRS 1987.

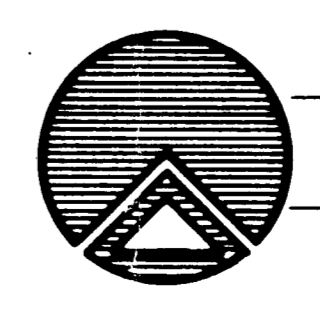

**TEIKNISTOFAN RÖÐULL**  
 ARMULA 36 - 108 REYKJAVÍK - SÍMI 33950 & 33577  
**MALBIKUNARSTÖÐ MARKHELLU 1, HF.**  
**HLADBÆR COLAS**

AFSTÖÐUMYND.

TEKN.	H.B.	DAGS	FEB. 1987
REIKN.		VERK.	87003
YFIRF.		BLAD.	102
MKV.	1:200		

*[Handwritten signature]*