




austur 1:100

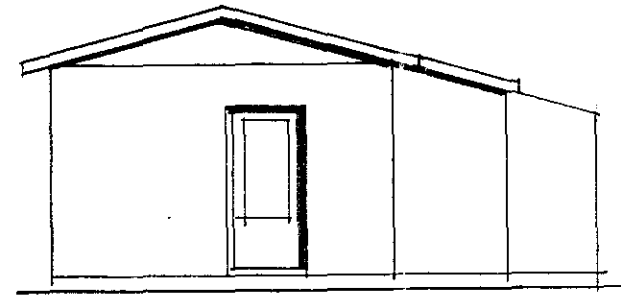

nordur 1:100

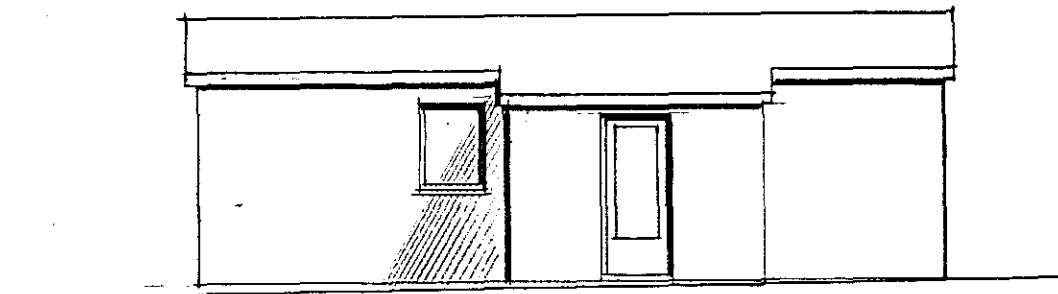

vestur 1:100

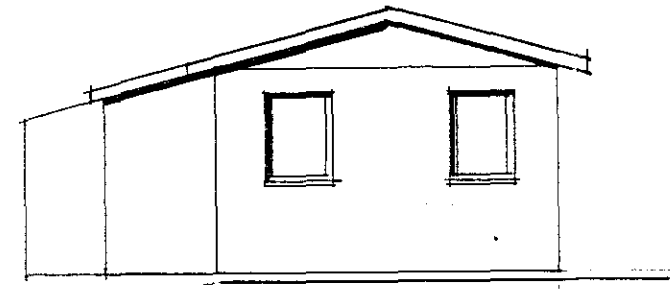

sudur 1:100



Samþykkt á fundi bygginga-
nefndar þ. 24. 8. 1994
BYGGINGAUFULLTRÚINN
Í HAFNARFIRÐI
J. M. Þorgeirsson

Bráðabirgða skrifstofuhús úr timbri

Flatarmál 50,6 m²

Rúmmál 159,6 m³

Teiknad samkv. uppmælingu

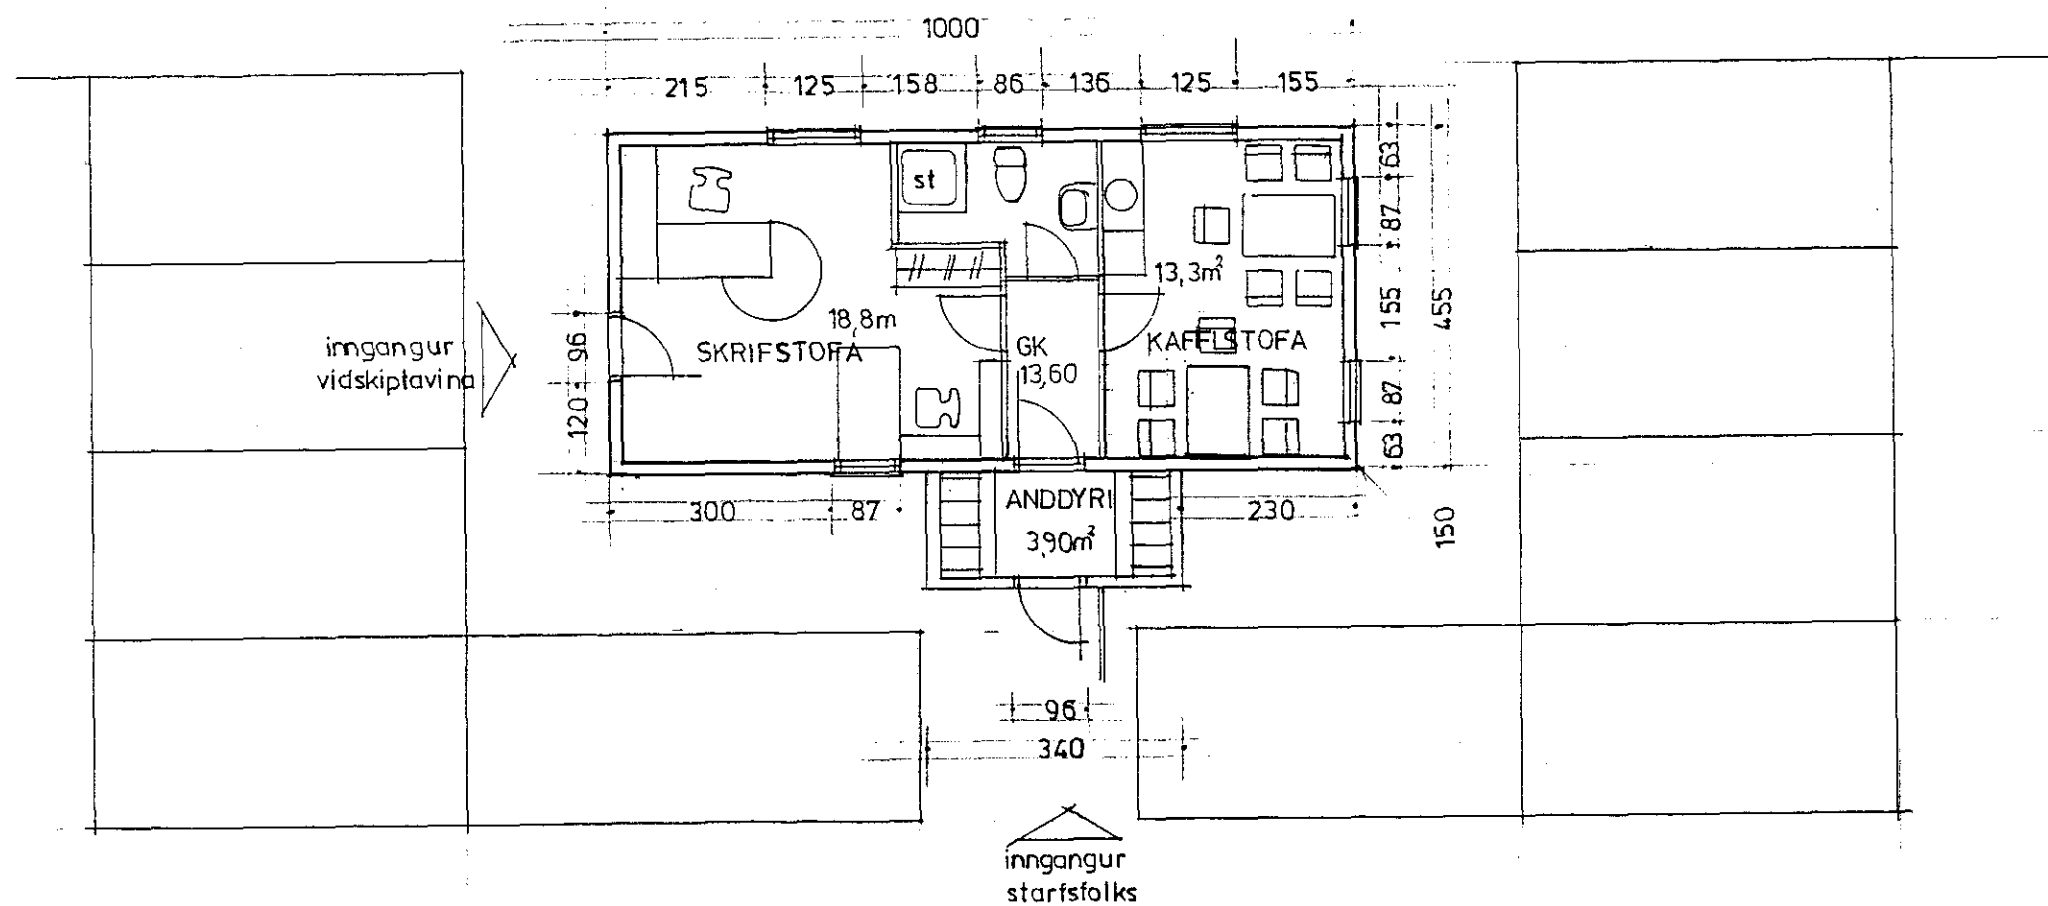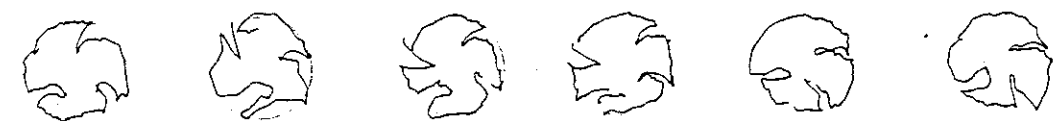

Grunnmynd 1:100

Hönnuð hella 2

01

BR 15.10.94
BR 25.07.94
BR 27.09.94

<p>JÖRFABAKKA 20 109 RVK S 77671, 985 37087</p>	<p>STENSTEYPAN HF <i>Þorshella 12</i> Markhella 7, Hafnarfirdi A3</p>
	<p>Étmi: bráðabirgða skrifstofuhús</p>
	<p>Dags 05.07.94 Mkv 1:100</p>
	<p>Teiknad: Ásgeir Ásgeirsson <i>Ásgeirsson</i></p>