




PVERSNID I GRYFJU 1:10

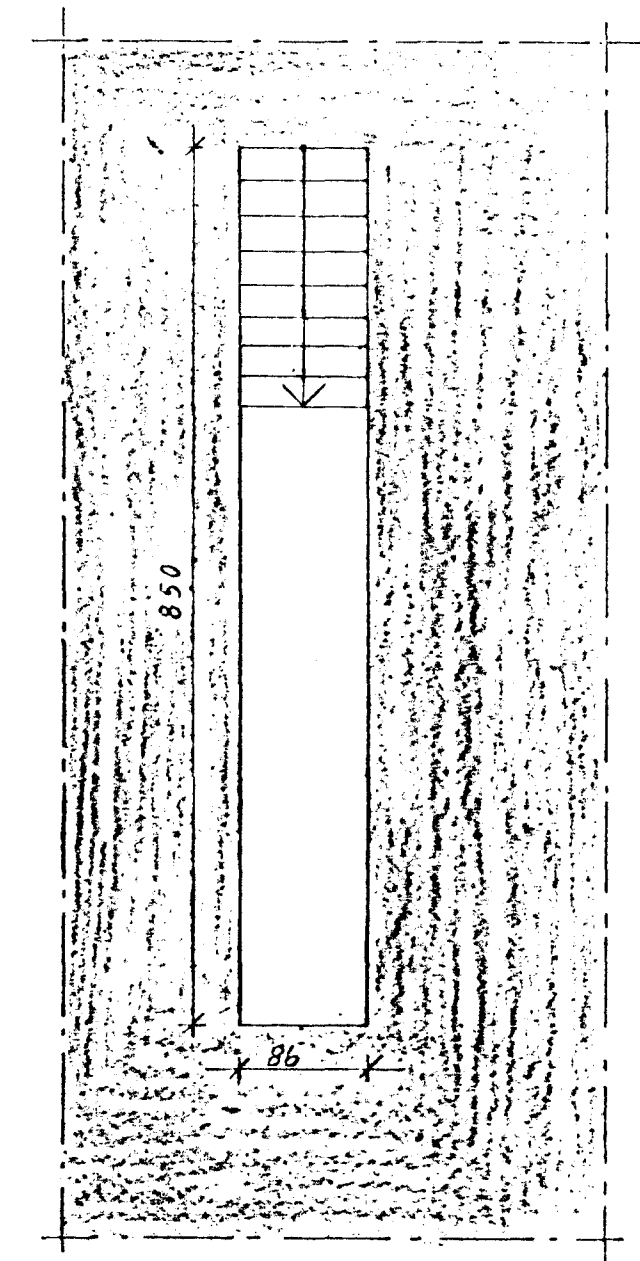

GRUNNMYND 1:50

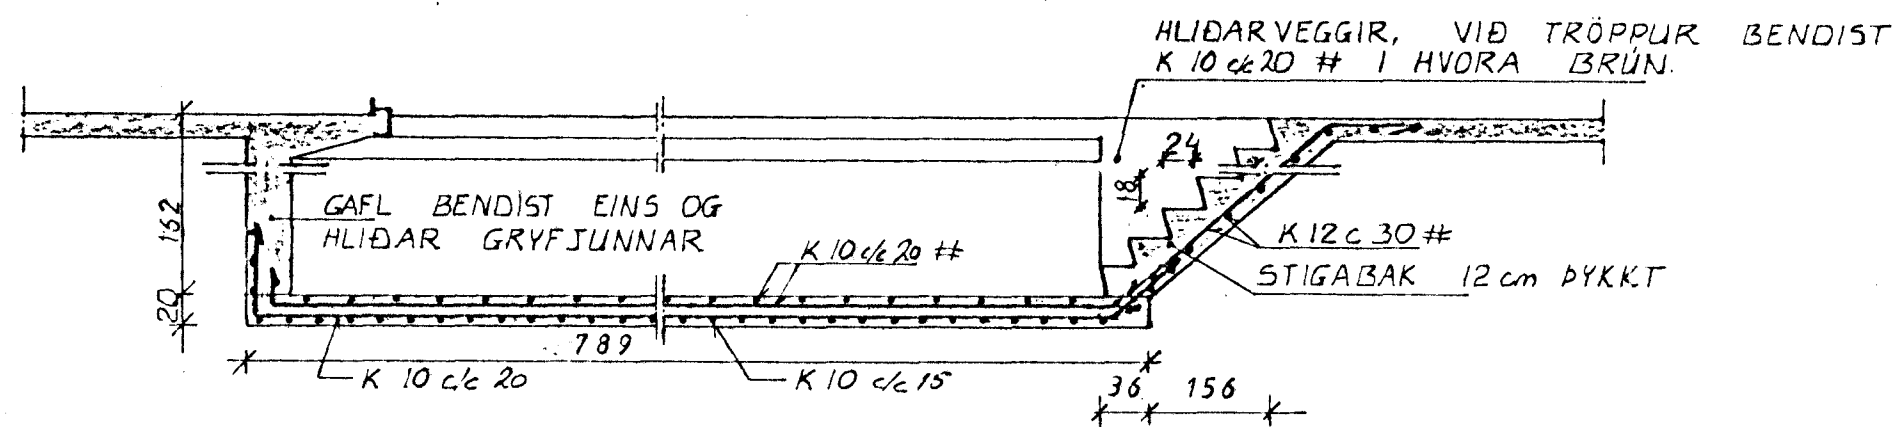

LANGSNID I GRYFJU 1:50

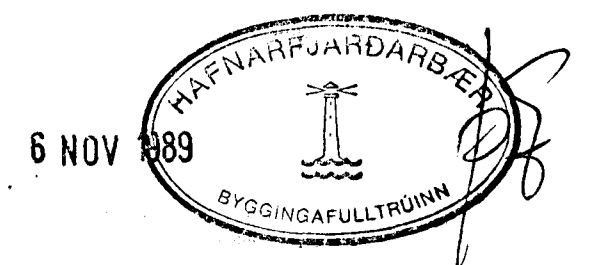

<b>HAGVIRKI HF</b> VERKTAKI VERKHÖNNUN SKÚTAHRAUN 2 - 220 HAFNARFJÓRÐI - SÍMI 53999	Verk nr FA 590
	Teikning nr <b>1.6</b>
<b>MARKHELLA 1</b> , HAFNARF. <del>HRINGHELLA 6</del> SMURGRYFJA	Mælikvarði 1:50, 1:10
	Dagsetning AGÚST '89
Hannað H.P.M.	Teiknað H.P.M.
Yfirfarið H.P.M.	Samþykkt

BREYTT 1.11 '89