


3.

2.

1.

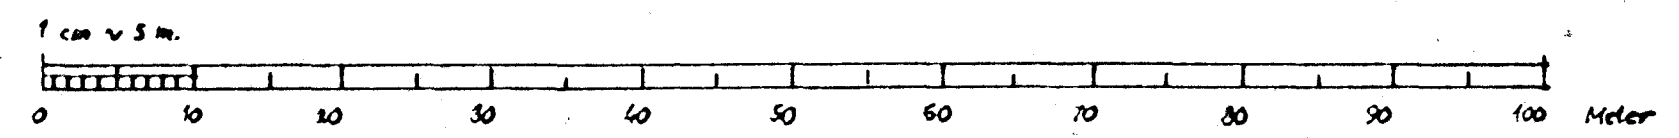

TEIKNISTOFAN RÖÐULL
 ARMULA 38 - 108 REYKJAVÍK - SÍMI 33950 & 33577
MALBIKUNARSTÖÐ MARKHELLU 1, HF.
HLAÐBER COLAS HRINGHELLA 6
 AFSTÖÐUMYND

BREYTT Í DES. '87

TEKNI: H.B.	DAGS: JAN. 1987
REKNI: 87003	BLAD: 1.01
YFRF: 1:500	

Anders Højgaard

Revideret d 22-1-87. Emulsionsfabrik fjernet.

BYGGINGAFÉLAGIÐ 1/2.	MÁ: 1:500	Sign: 14-12-86
Colas Vejmateriale 1/3.		Anders Højgaard
Malbikunarstöð		
Skiplag á löt sydri i		
Hettuhraunir		
HRINGHELLA 6		
		Tegn. nr. Re-1