


Hot dat.

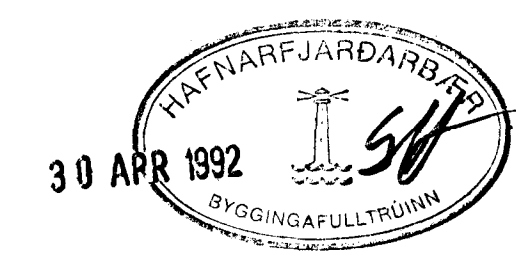

Breytingar	RAGNAR G. GUNNARSSON TÆKNIFR. MTFI	
Nr.	Dagur	Nafn
1	24.9.92	MTFI
LOGAFOLD 159 SIM 676773		H T S
HVALEYRARBRAUT 2		M 1:100
GRUNNMÝND 2. HÆÐ 02-01		Sk
OFNA- OG NEYSLUVATNSLAGNIR		Daga 3.11.92