


Br. júní 1996: Hlutamyndir af boltasamsetningu, IPE 400 við sulu.

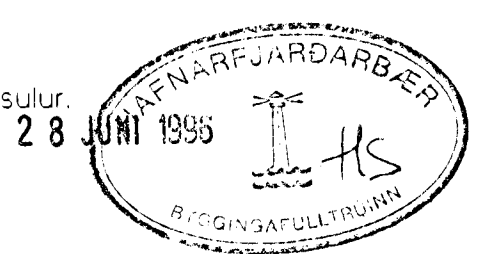

Hvaleyrarbraut 31 Hfnarf.		Teikn. Mars 96
Verkefni: Stálgrindarhús	Reikn.	
Verklutari: Hlutamyndir	Ath.	
GUDNI HANSSON		Samp.
FTFI	knt.061044-3539	Kvordr. 1:10
		Teikn. 4-96