


Úr Gildi

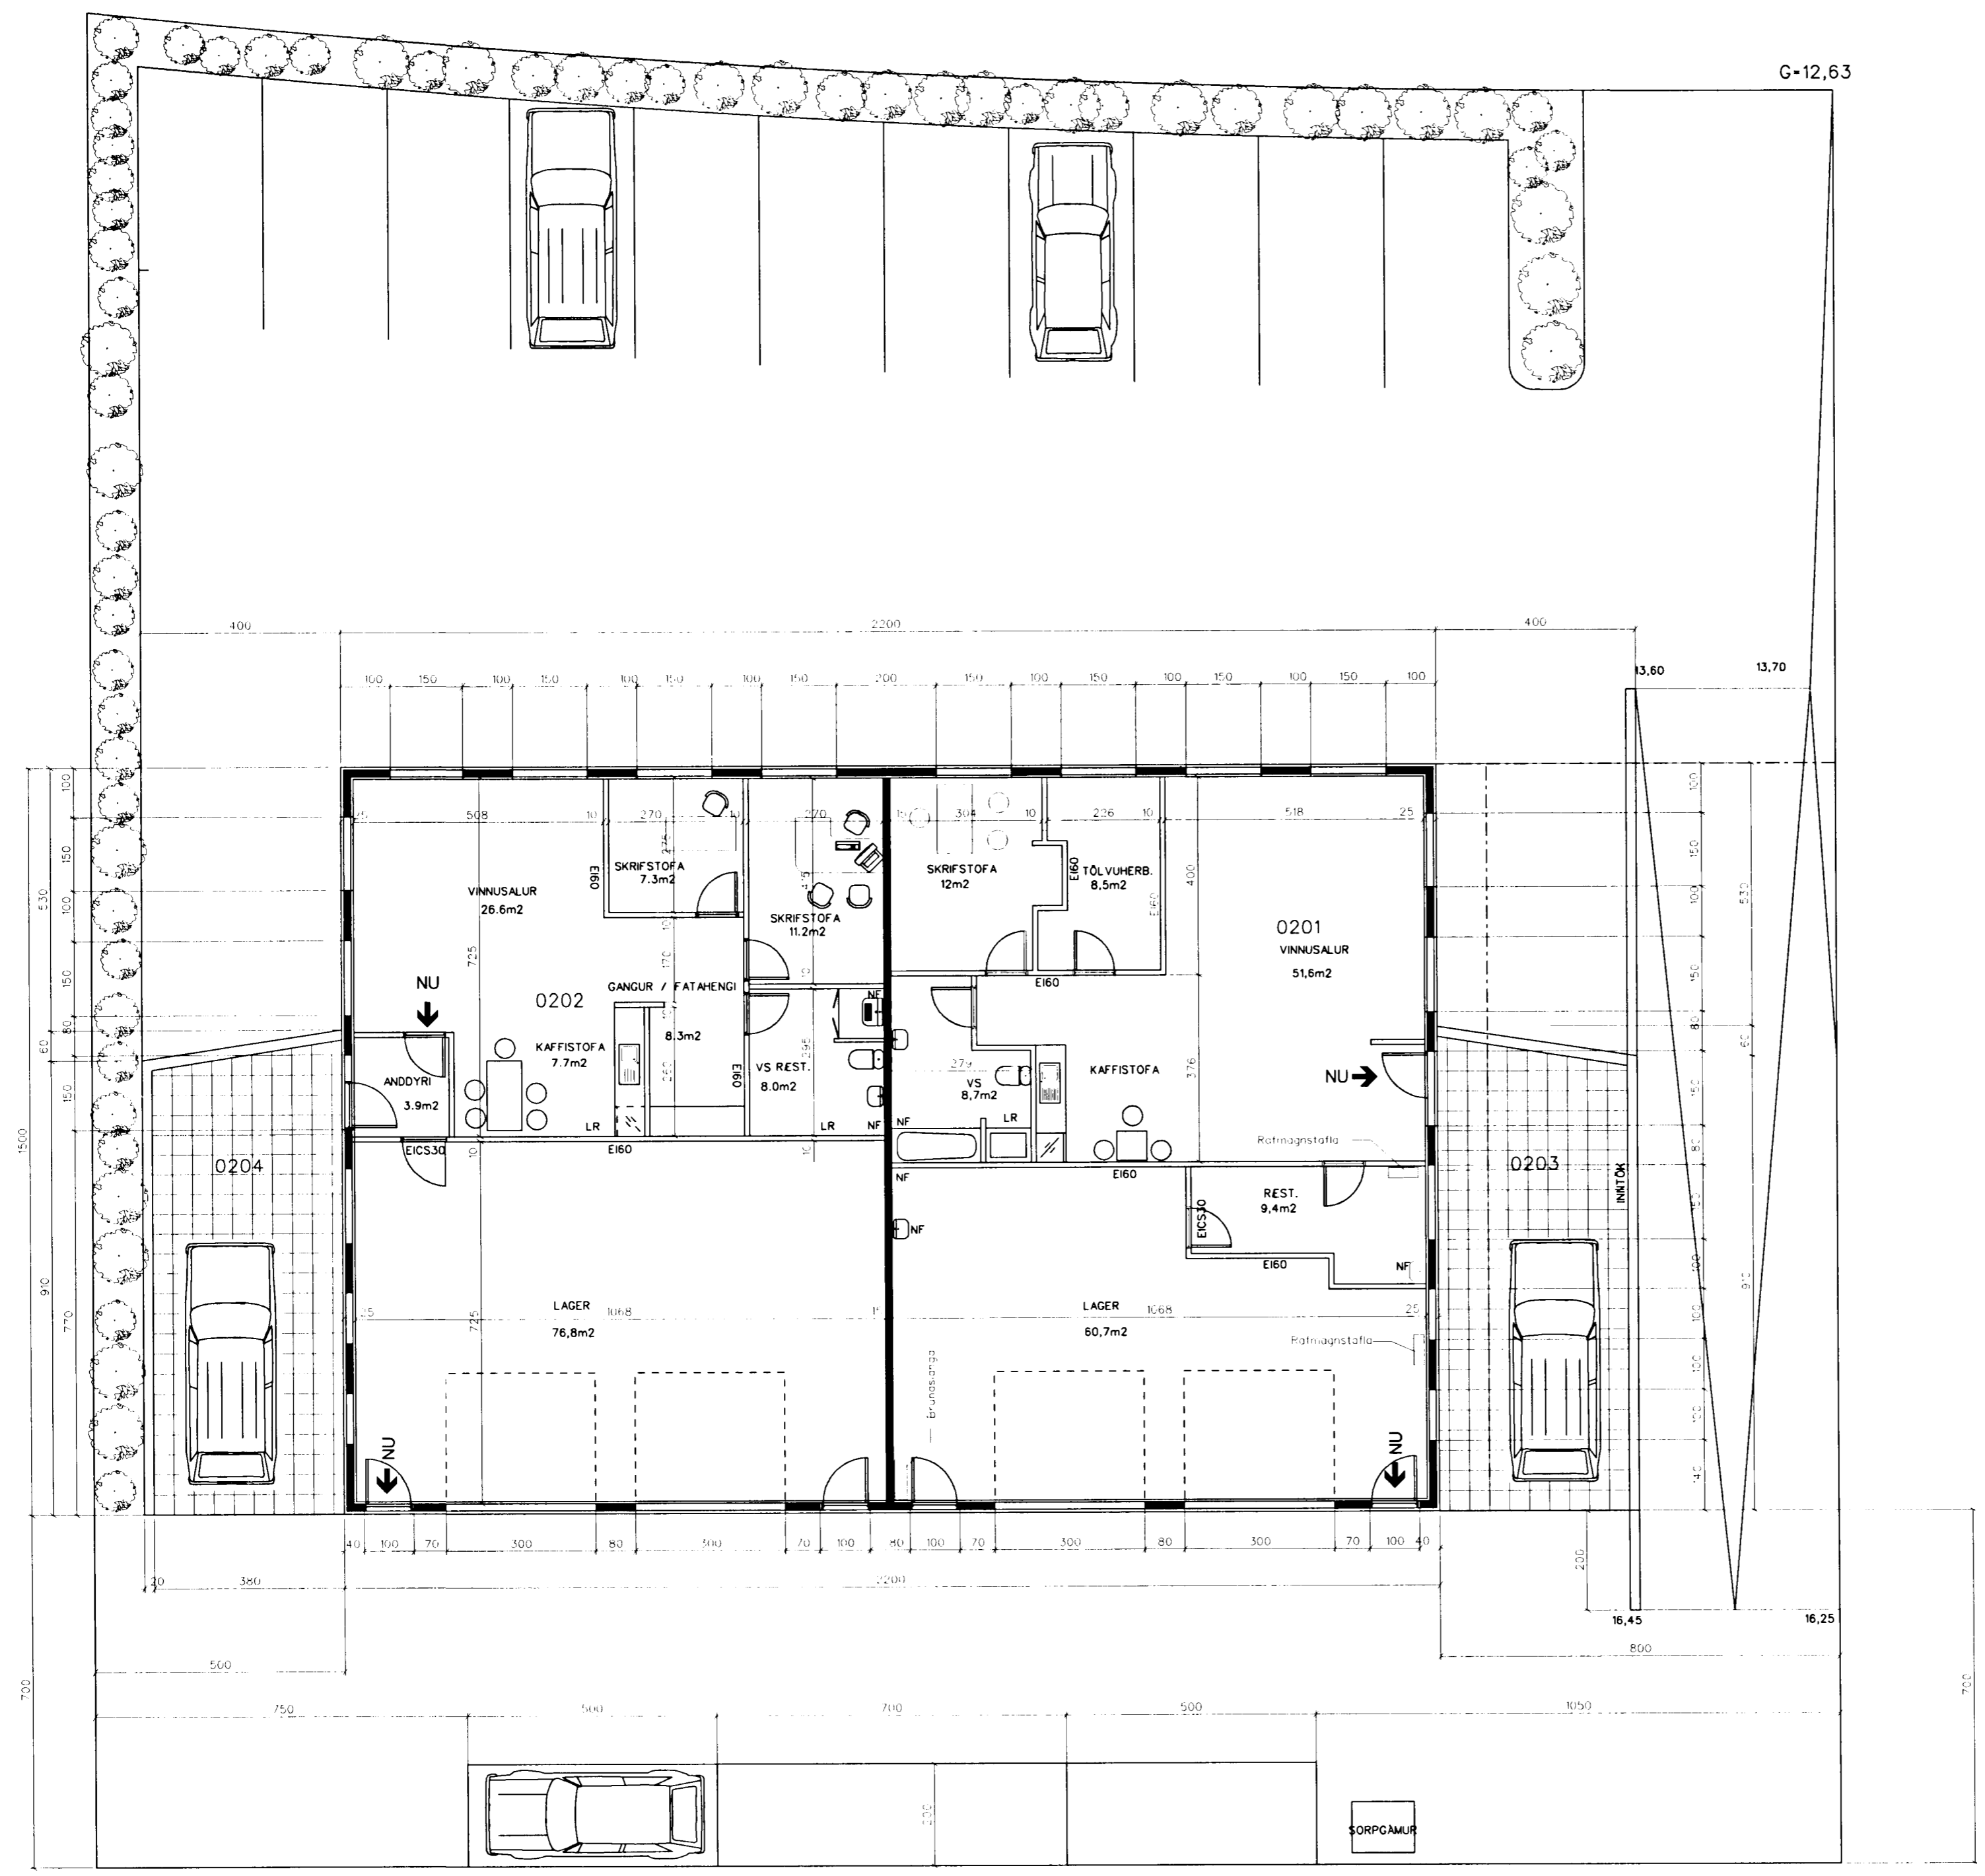

BREYTINGAR 4. MARS 2002:
 INNRETTINGUM EIGNARHLUTA 0201 BREYTT
 BETT INN GLUGGUM A GÖFLUM EIGNARHLUTUM 0201 OG 0202
 HURD A GAFLI EIGNARHLUTA 0201 SPEGLUD

BREYTINGAR 6. MARS 2002:
 INNRETTINGUM EIGNARHLUTA 0202 BREYTT

HVALEYRARBRAUT 35

BYGGINGARNEFNDARTEIKNINGAR Dags : 28. MARS 2000
Byggingarnefnd 2.4 Mk 1:100
 C: TEIKN\ATVINNA\HVALEYRI\ 1.DGN BLAD: 3

SVEINN ÍVARSSON ARKITEKT F.A.Í.
 LYNGHÁLSI 3 110 REYKJAVÍK SÍMI 567-9006, GSM 893-9006 FAX 567-2781
 SVEINN ÍVARSSON e.h.f., ALFHÖLSVEGI 79A KÖPAVOGI KT: 550296-2339

