

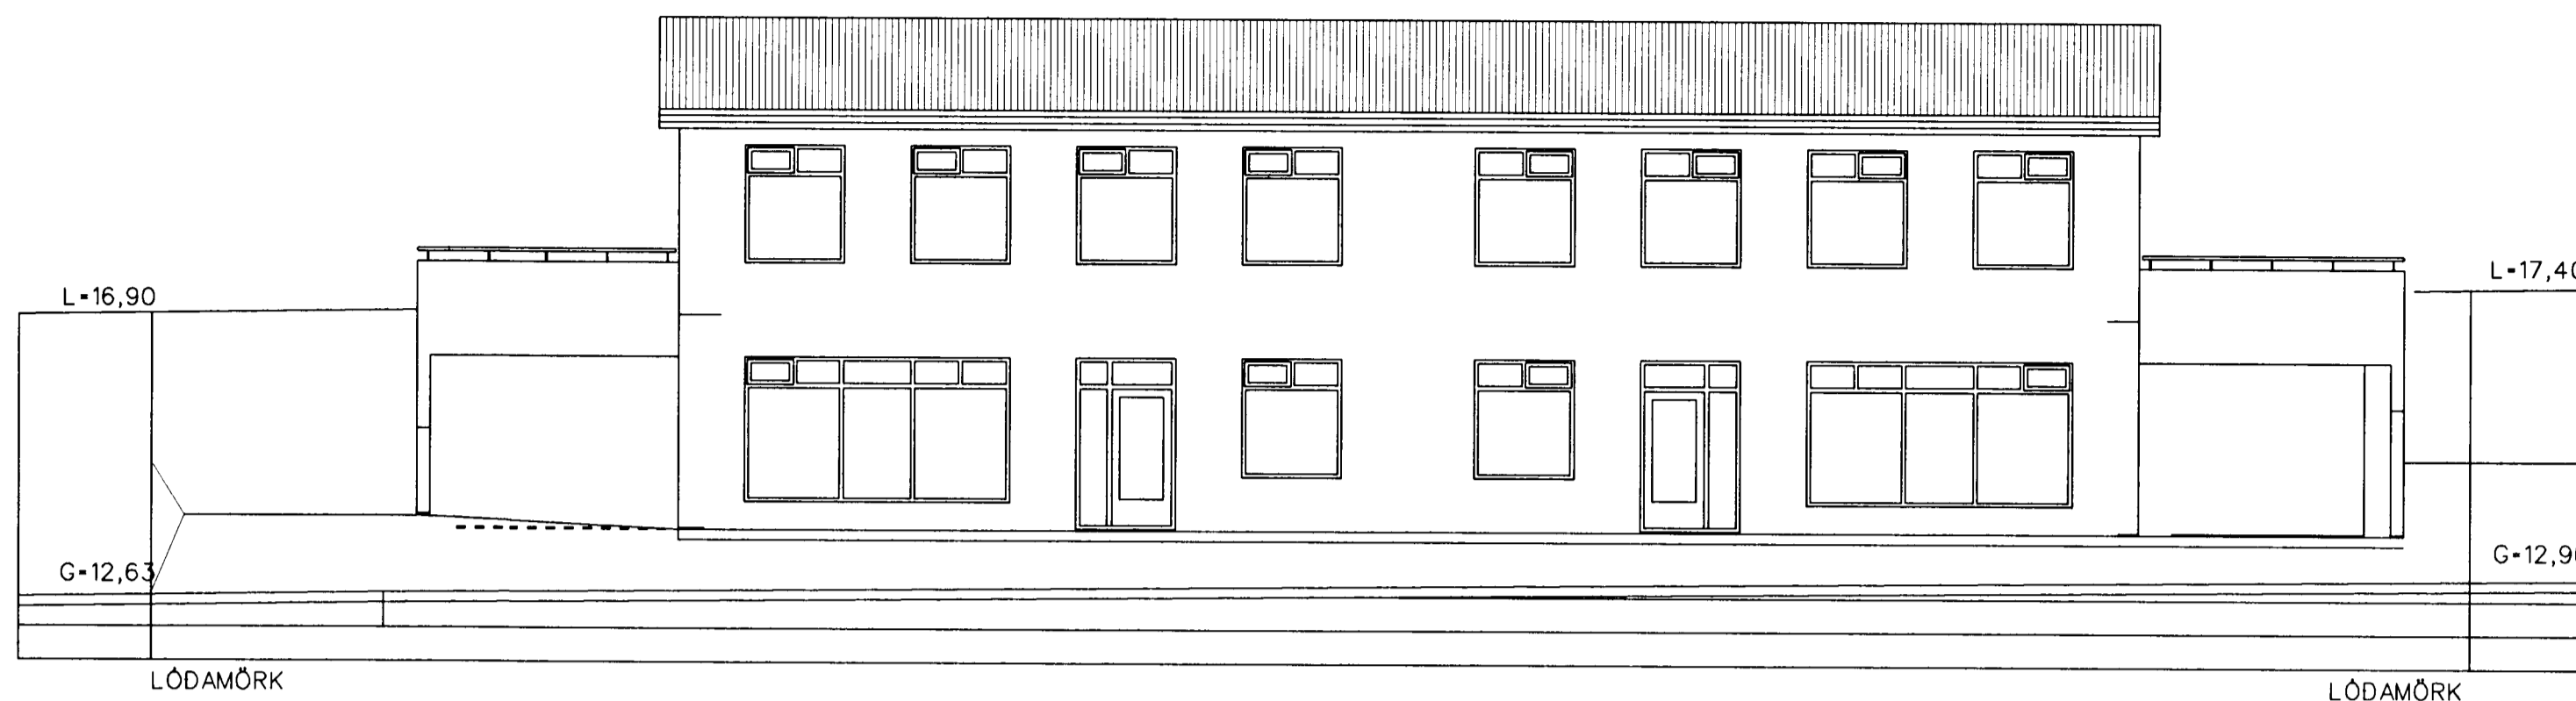


02 JULI 2002

Byggingafulltrúinn í Hafnarfirði  
Erlendur Hjálmarsson

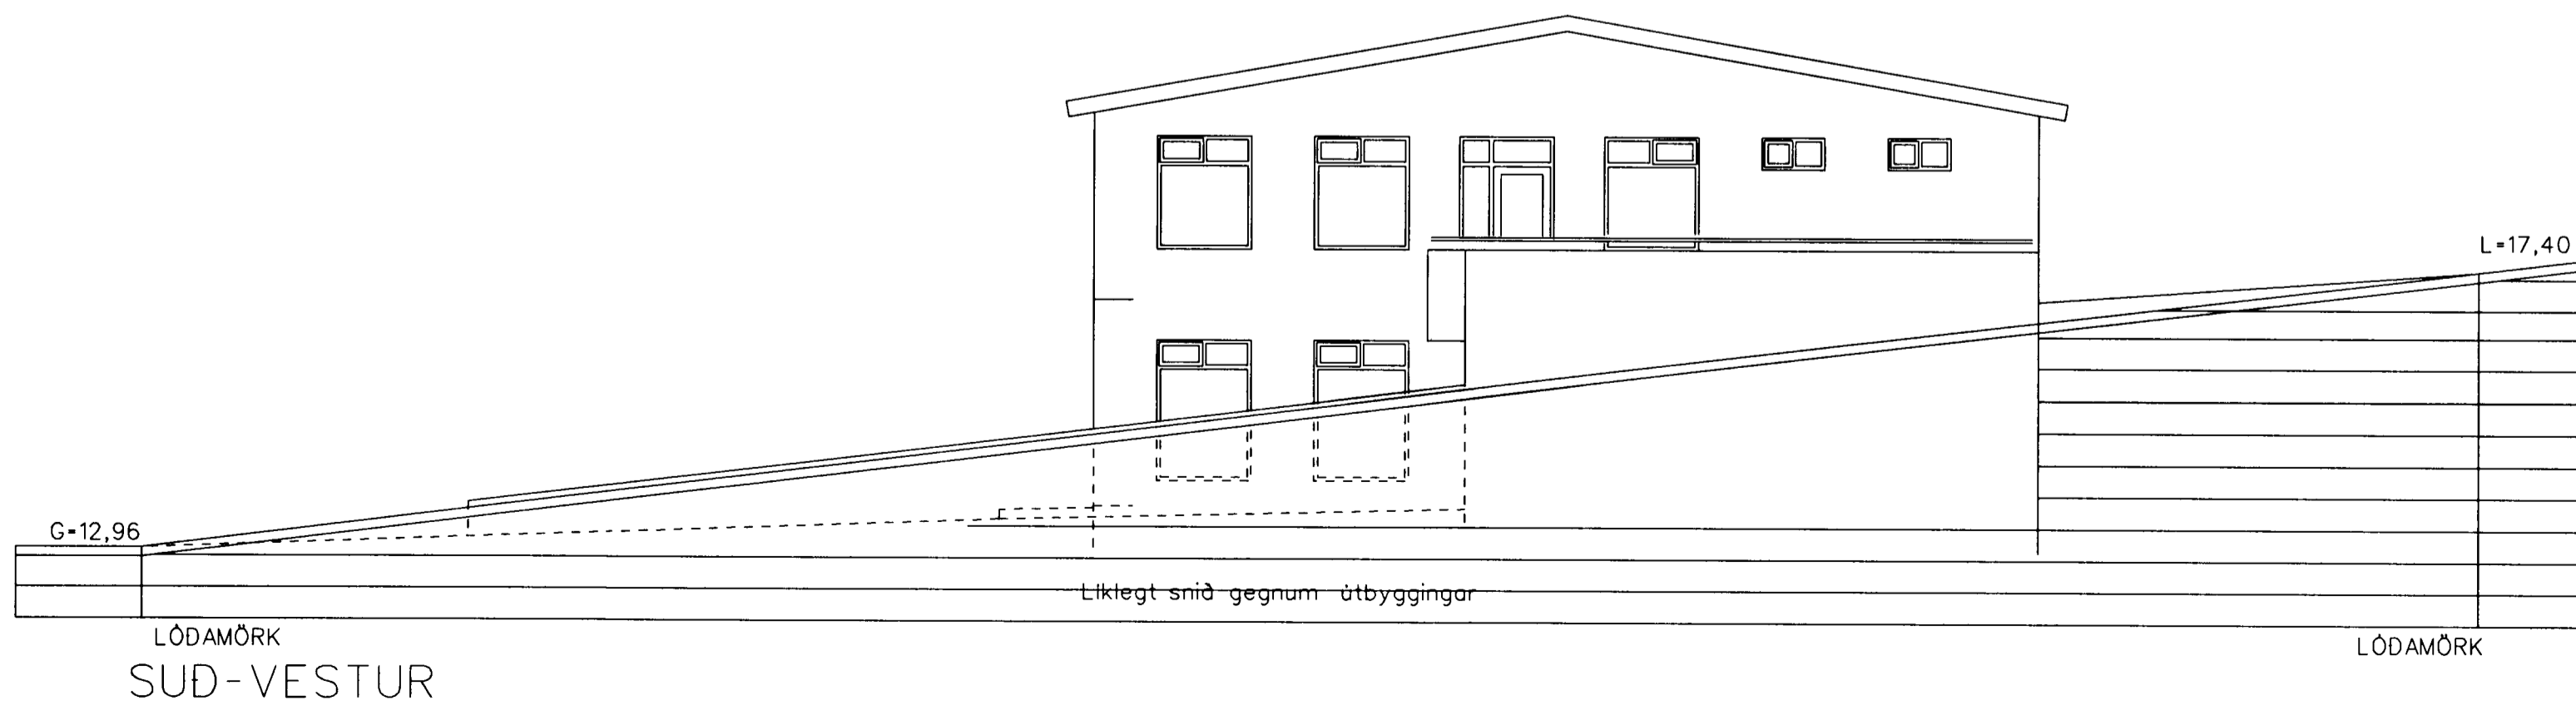

NORD-VESTUR

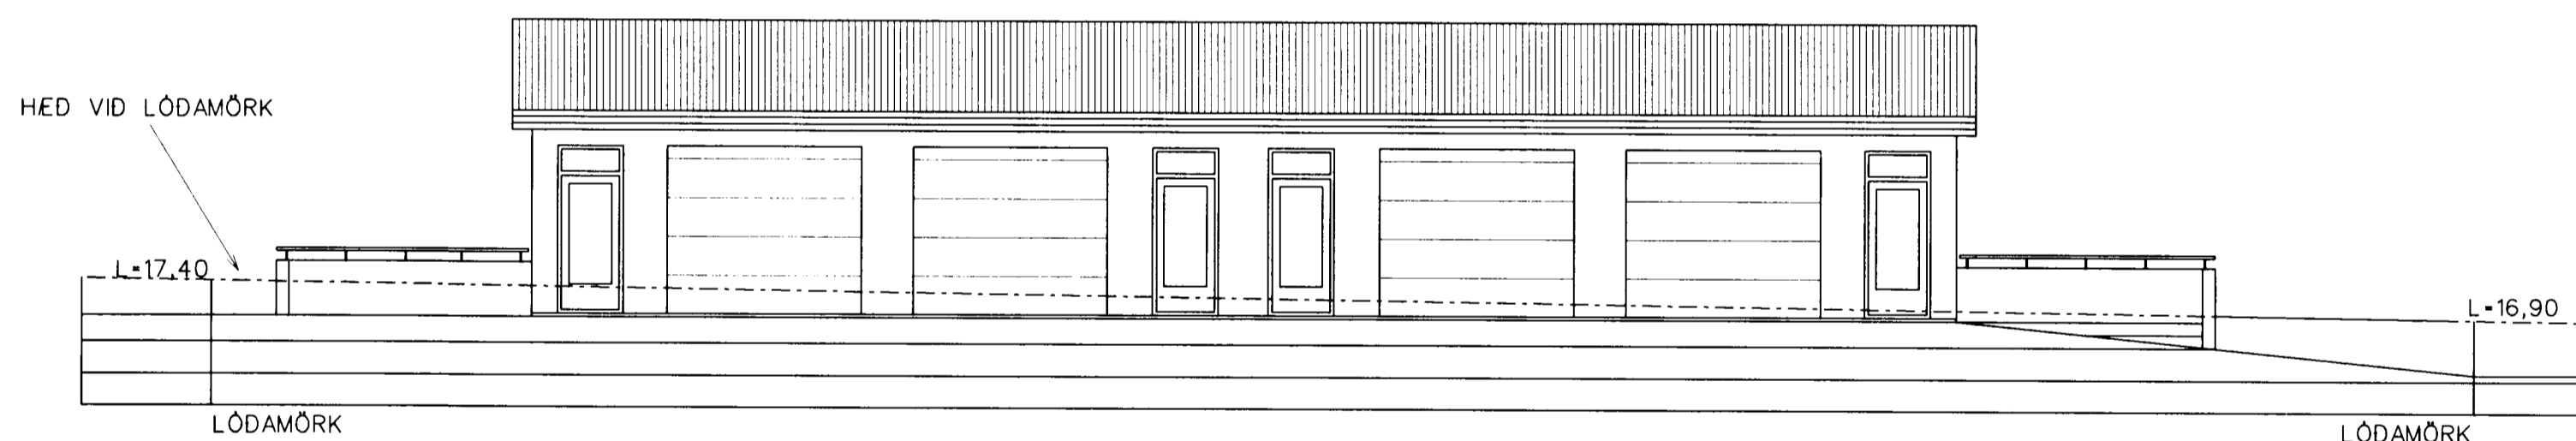

BREYTINGAR 4. MARS 2002:  
INNRETTINGUM EIGNARHLUTA 0201 BREYTT  
BETT INN GLUGGUM A GÖFLUM EIGNARHLUTUM 0201 OG 0202  
HURD A GAFLI EIGNARHLUTA 0201 SPEGLUD

BREYTINGAR 6. MARS 2002:  
INNRETTINGUM EIGNARHLUTA 0202 BREYTT

BREYTINGAR 28. MARS 2002:  
INNRETTINGUM EIGNARHLUTA 0101 BREYTT

### HVALEYRARBRAUT 35

BYGGINGARNEFNDARTEIKNINGAR Dags : 28. MARS 2000  
MK 1:100

C: TEIKN/ATVINNA/HVALEYRI/ 1.DGN BLAD: 4

SVEINN ÍVARSSON ARKITEKT F.A.Í.

LYNGHÁLSI 3 110 REYKJAVÍK SIMI 567-9006, GSM 893-9006 FAX 567-2781  
SVEINN ÍVARSSON e.h.f. ALFHÓLSVEGI 79A KÖPAVOGI KT: 550296-2339